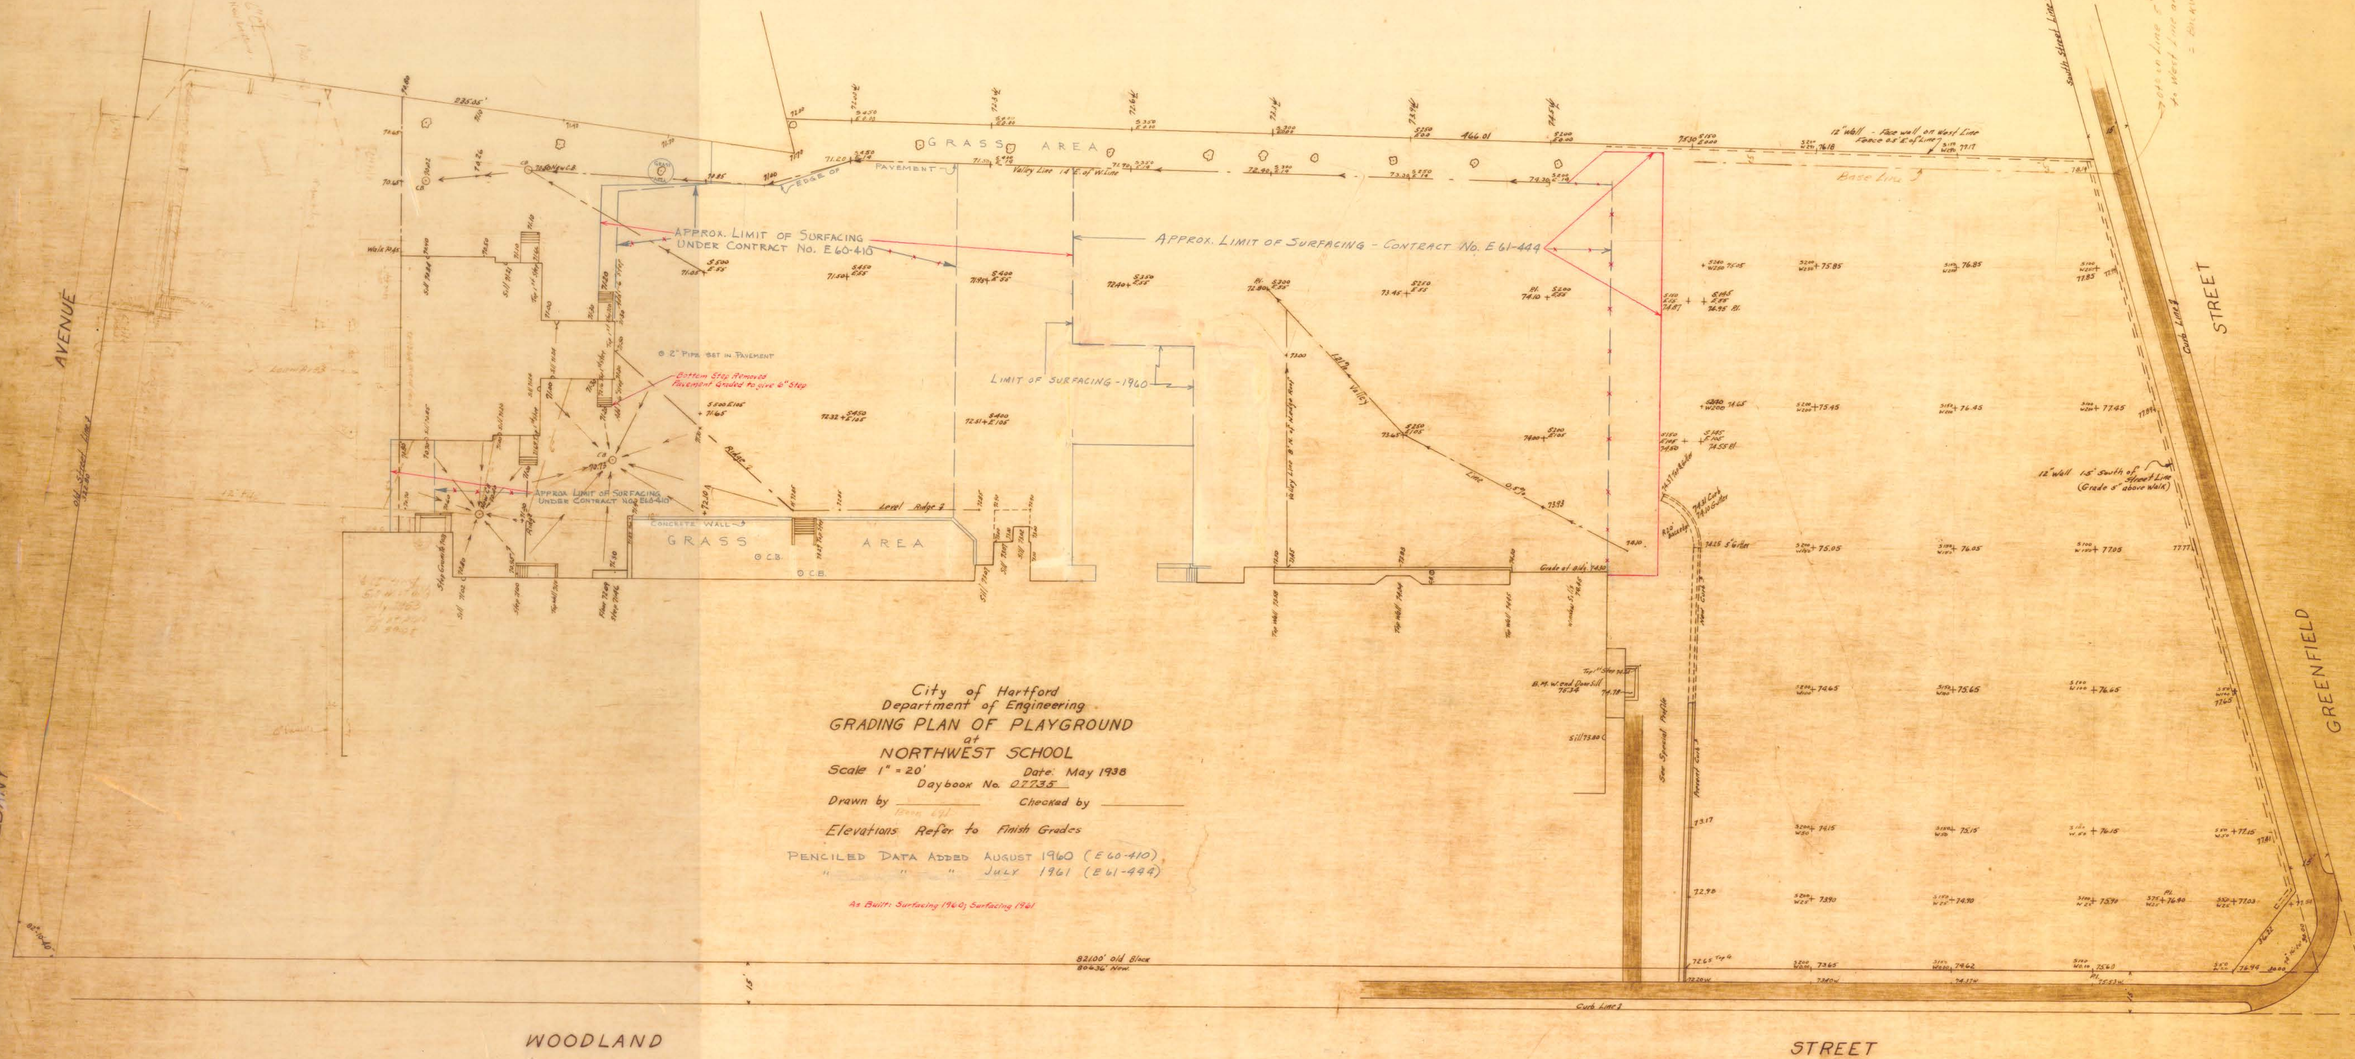
GRASS AREA
EDGE OF PAVEMENT
APPROX. LIMIT OF SURFACING UNDER CONTRACT No. E60-410
APPROX. LIMIT OF SURFACING - CONTRACT No. E61-449
LIMIT OF SURFACING-1960
Bottom Step Removed Pavement Graded to give 6" Step
CONCRETE WALL
GRASS AREA
Level Ridge
Base Line
Curb Line
Grade of walk 74.30
12" wall 15' South of Above Line (Grade 5" above walk)
ALBANY AVENUE
WOODLAND STREET
GREENFIELD STREET
City of Hartford
Department of Engineering
GRADING PLAN OF PLAYGROUND
at
NORTHWEST SCHOOL
Scale 1" = 20'
Date: May 1938
Daybook No. 27735
Drawn by
Checked by
Elevations Refer to Finish Grades
PENCILED DATA ADDED AUGUST 1960 (E60-410)
" " " JULY 1961 (E61-449)
As Built: Surfacing (1960) Surfacing 1961