


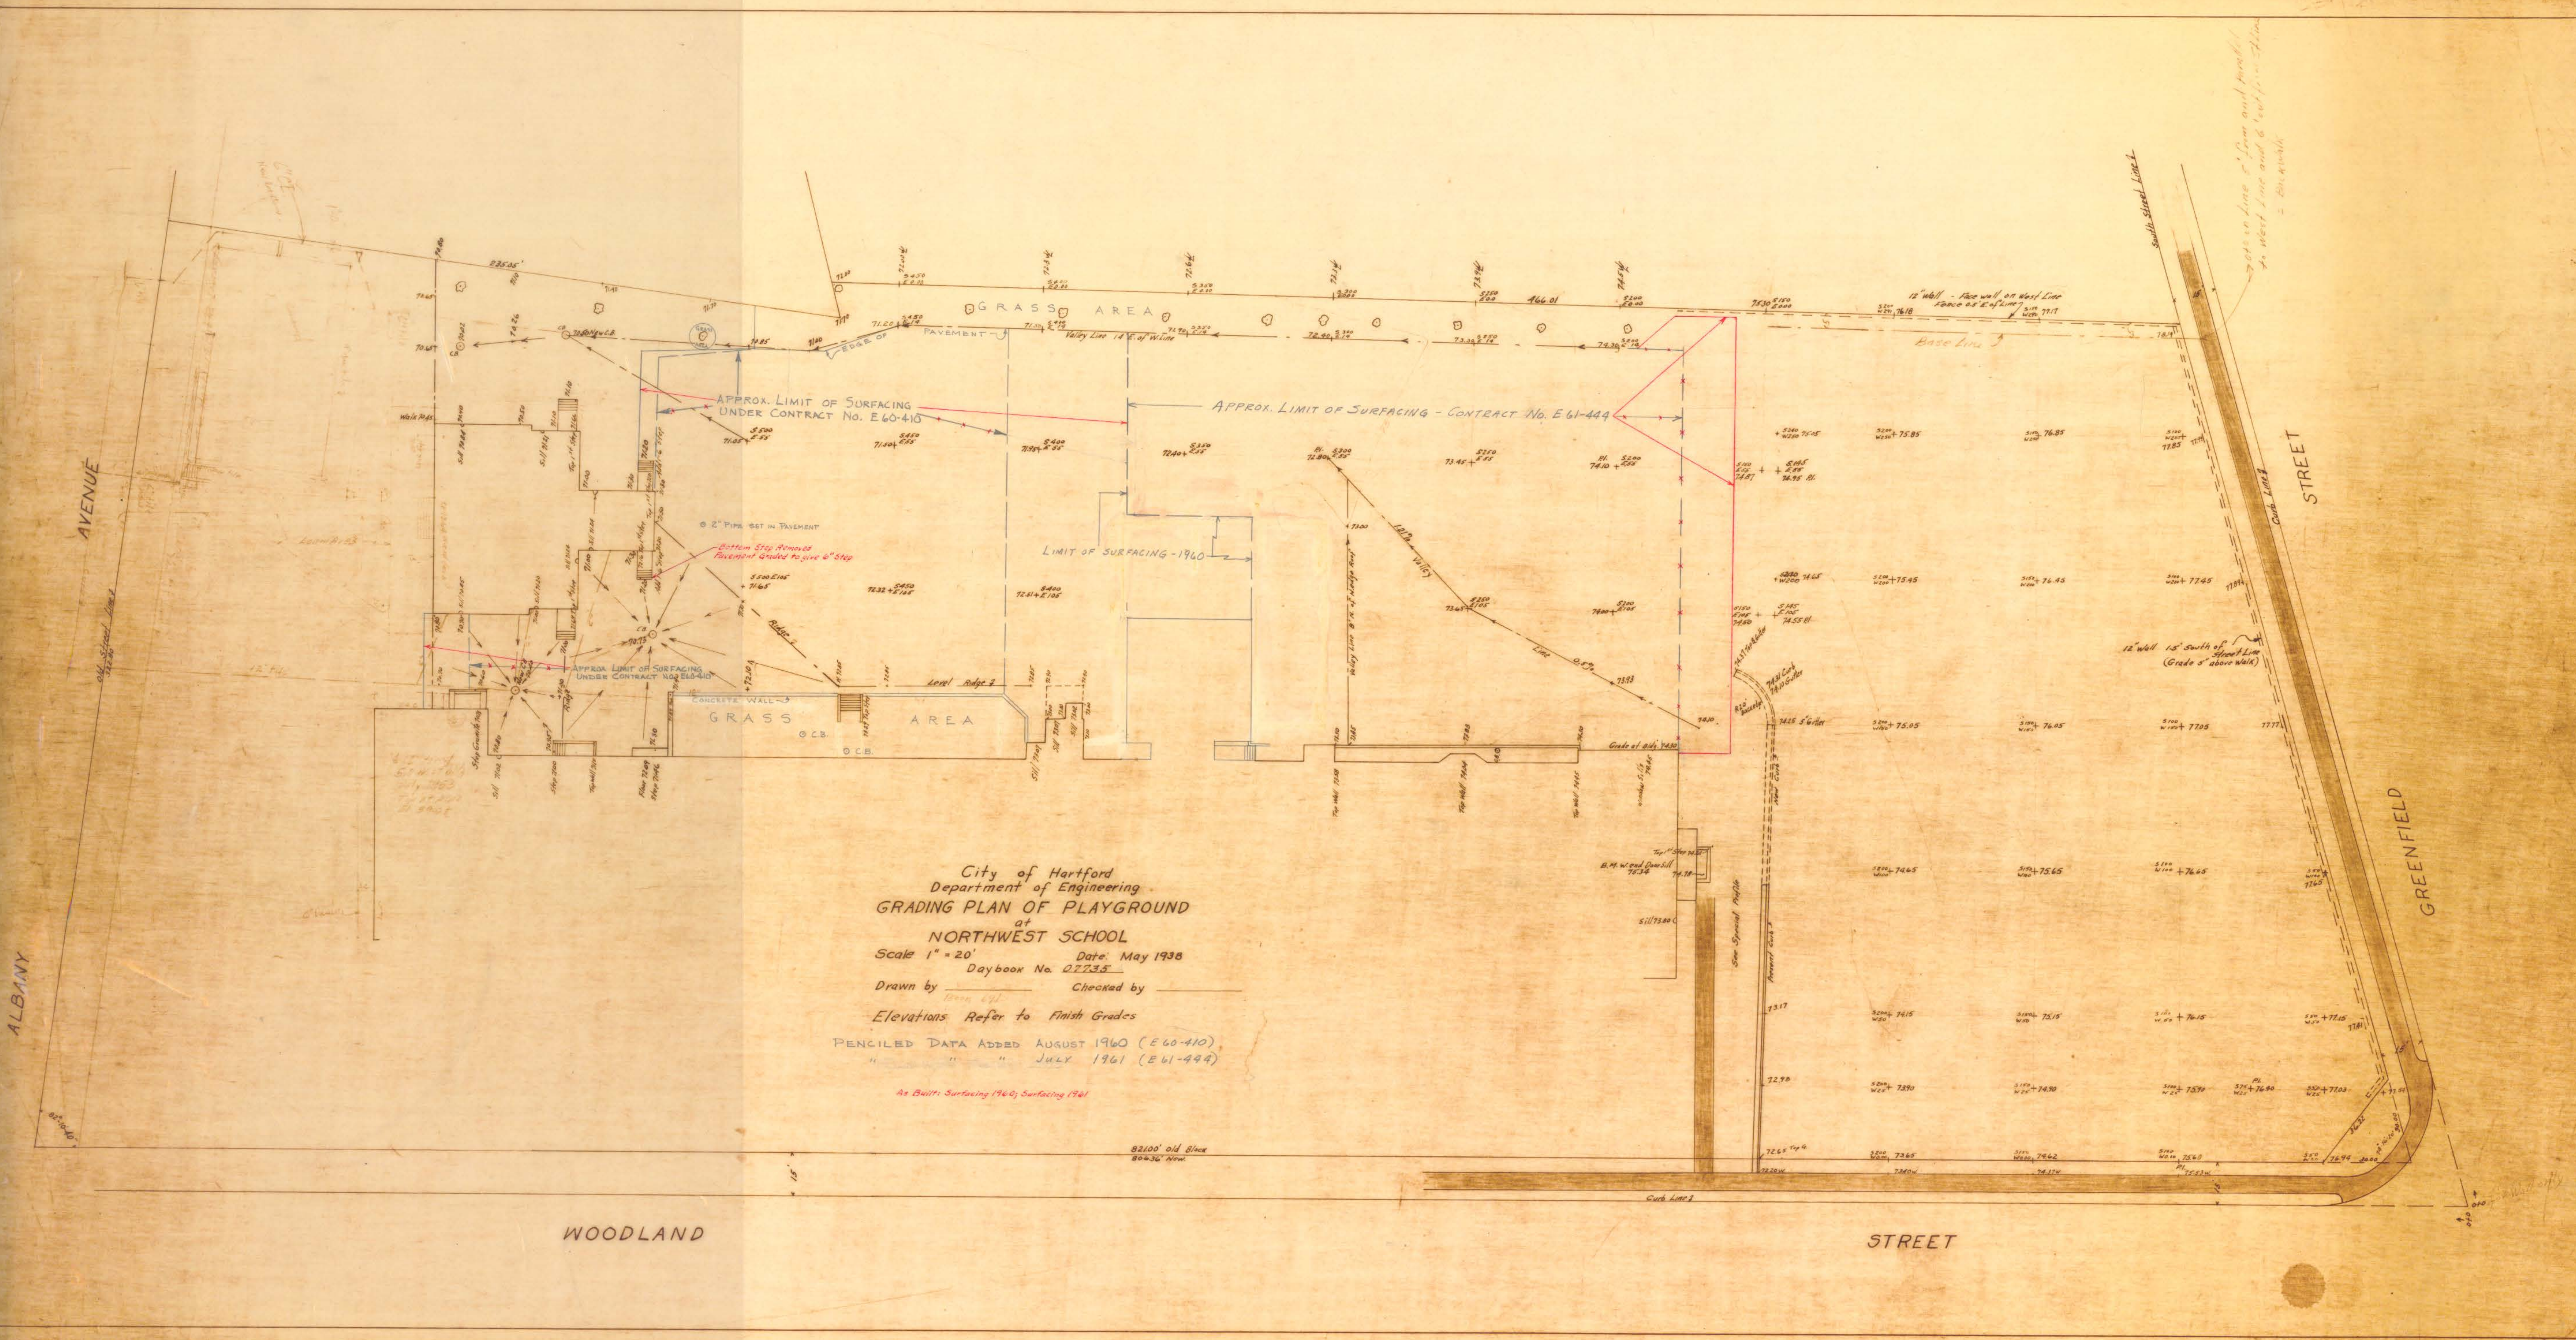

City of Hartford
Department of Engineering
GRADING PLAN OF PLAYGROUND
at
NORTHWEST SCHOOL
Scale 1" = 20' Date: May 1938
Daybook No. 02735
Drawn by [signature] Checked by [signature]
Elevations Refer to Finish Grades
PENCILED DATA ADDED AUGUST 1960 (E 60-410)
JULY 1961 (E 61-444)

As Built: Surfacing (1960) Surfacing (1961)