


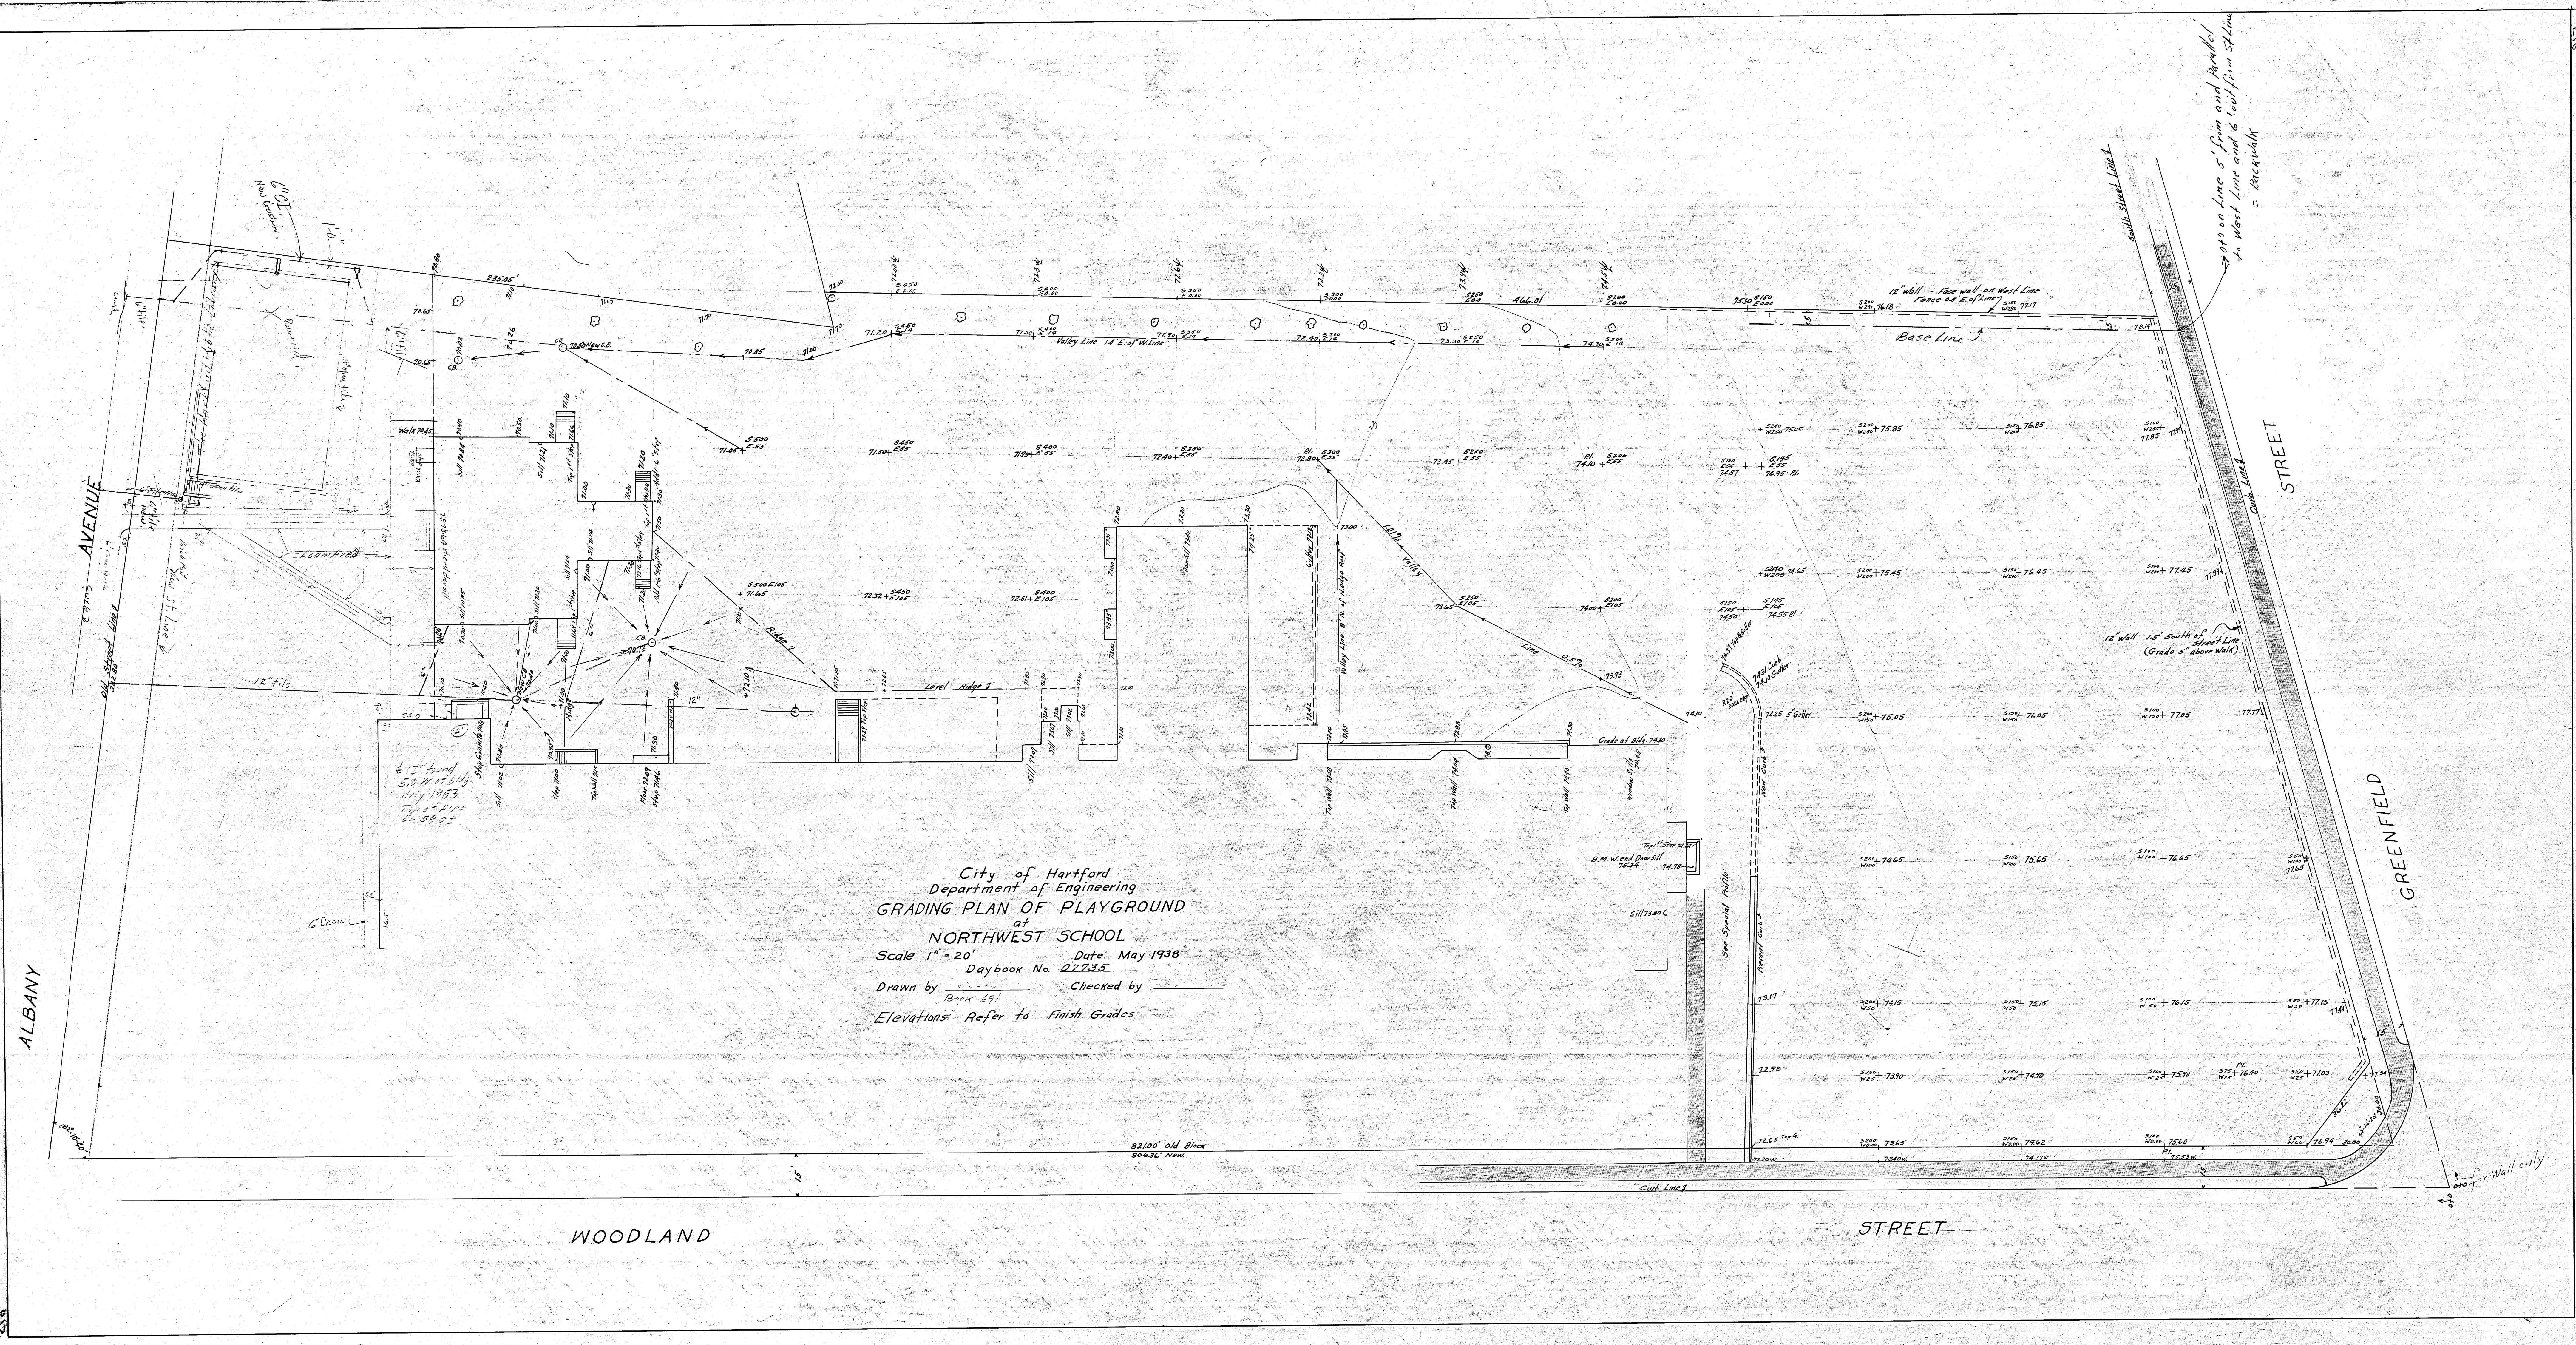

City of Hartford
 Department of Engineering
GRADING PLAN OF PLAYGROUND
 at
NORTHWEST SCHOOL
 Scale 1" = 20' Date May 1938
 Daybook No. 27735
 Drawn by [Signature] Checked by [Signature]
 (Book 69)
 Elevations Refer to Finish Grades

WOODLAND

STREET

GREENFIELD

ALBANY

STREET

for Wall only