


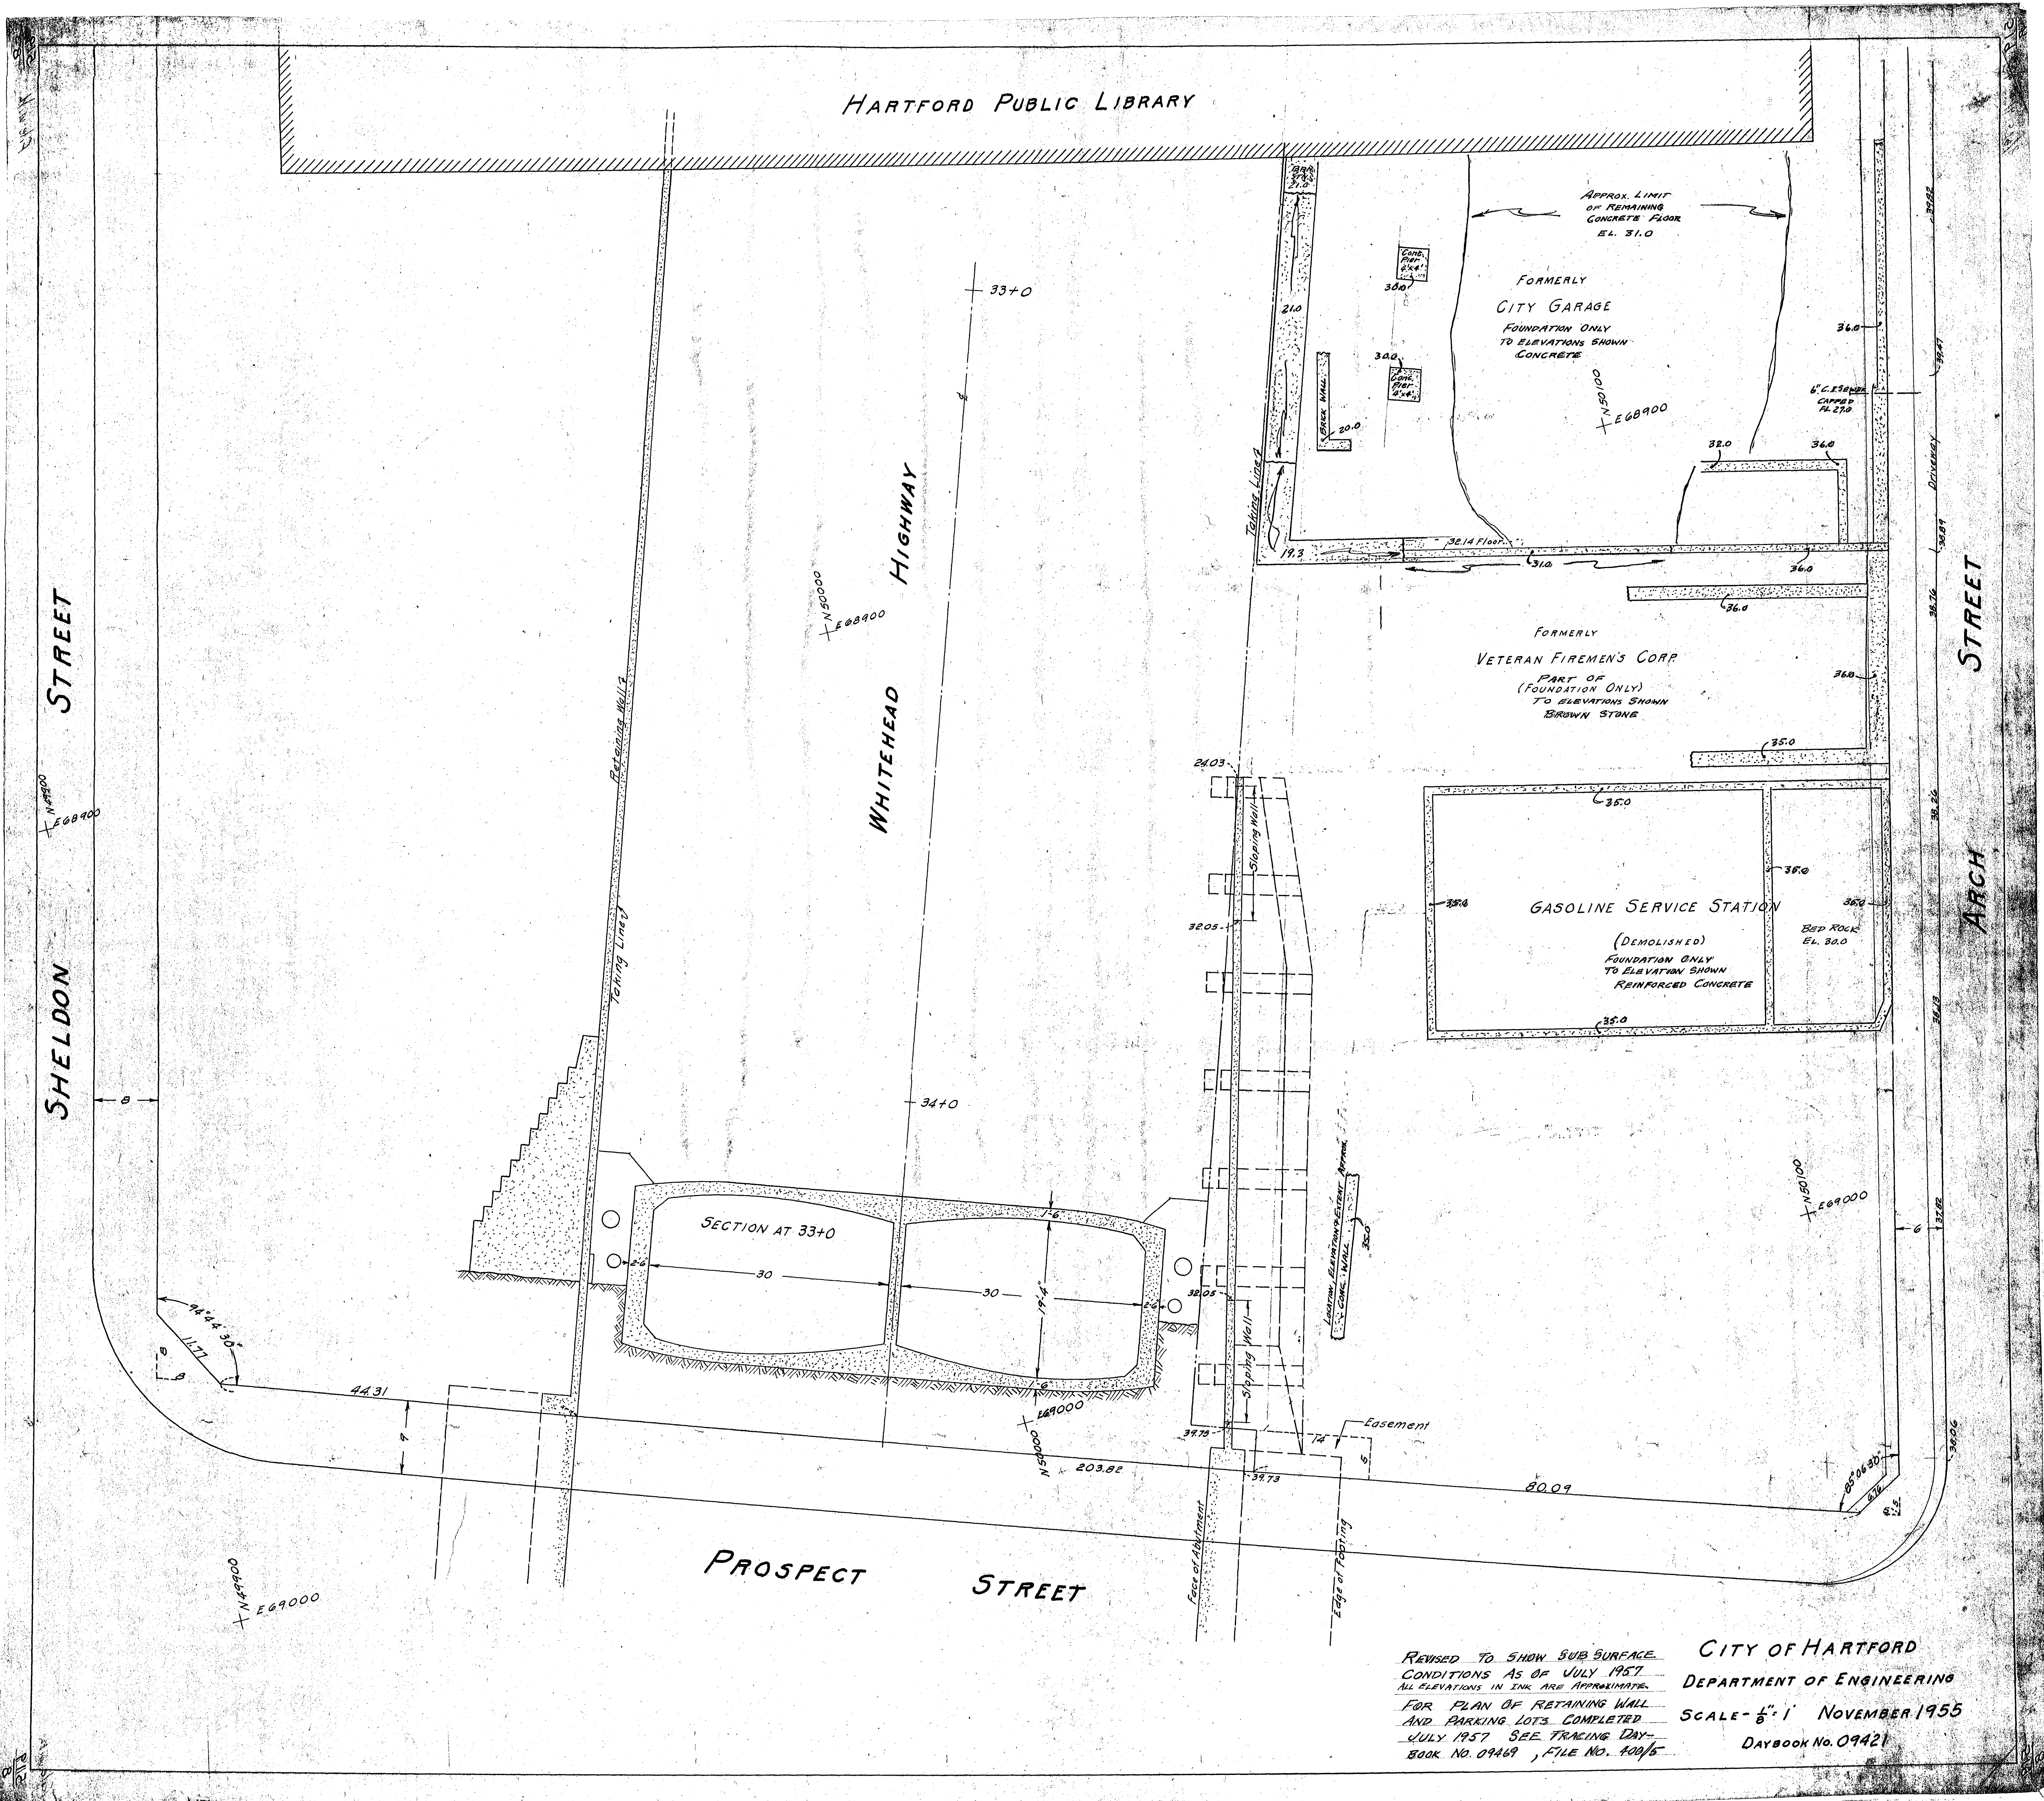

REVISED TO SHOW SUB-SURFACE
CONDITIONS AS OF JULY 1957
ALL ELEVATIONS IN INK ARE APPROXIMATE
FOR PLAN OF RETAINING WALL
AND PARKING LOTS COMPLETED
JULY 1957 SEE TRACING DAY-
BOOK NO. 09469, FILE NO. 400/5

CITY OF HARTFORD
DEPARTMENT OF ENGINEERING
SCALE - 1/8" = 1' NOVEMBER 1955
DAYBOOK NO. 09421