



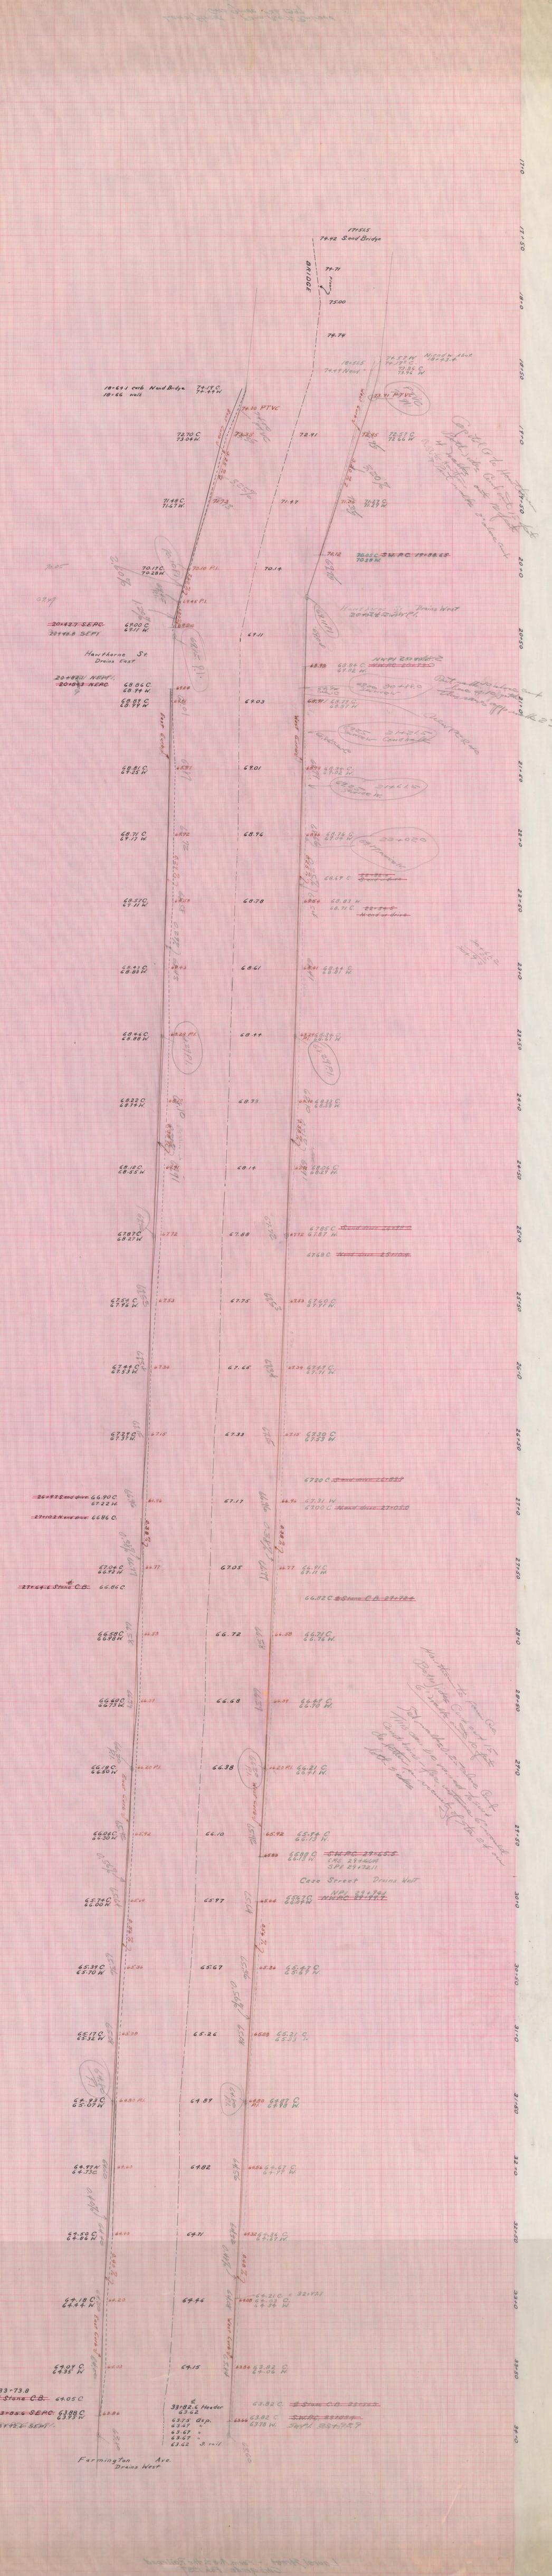


Printed No. 07627

51