


PROPERTY
OF
CONNECTICUT GENERAL LIFE INS. CO.
STATE MARKET^{NO} KINGSLEY STS.
HARTFORD CONN.
SCALE 1"=8'

JUNE 1933
PETERSEN & HOFFMAN ENGRS.
Theodore A. Petersen
Edward J. Hoffman
We hereby certify that this
map is substantially correct.
Petersen and Hoffman, Engrs.
Theodore A. Petersen
Edward J. Hoffman

Additions March 1937

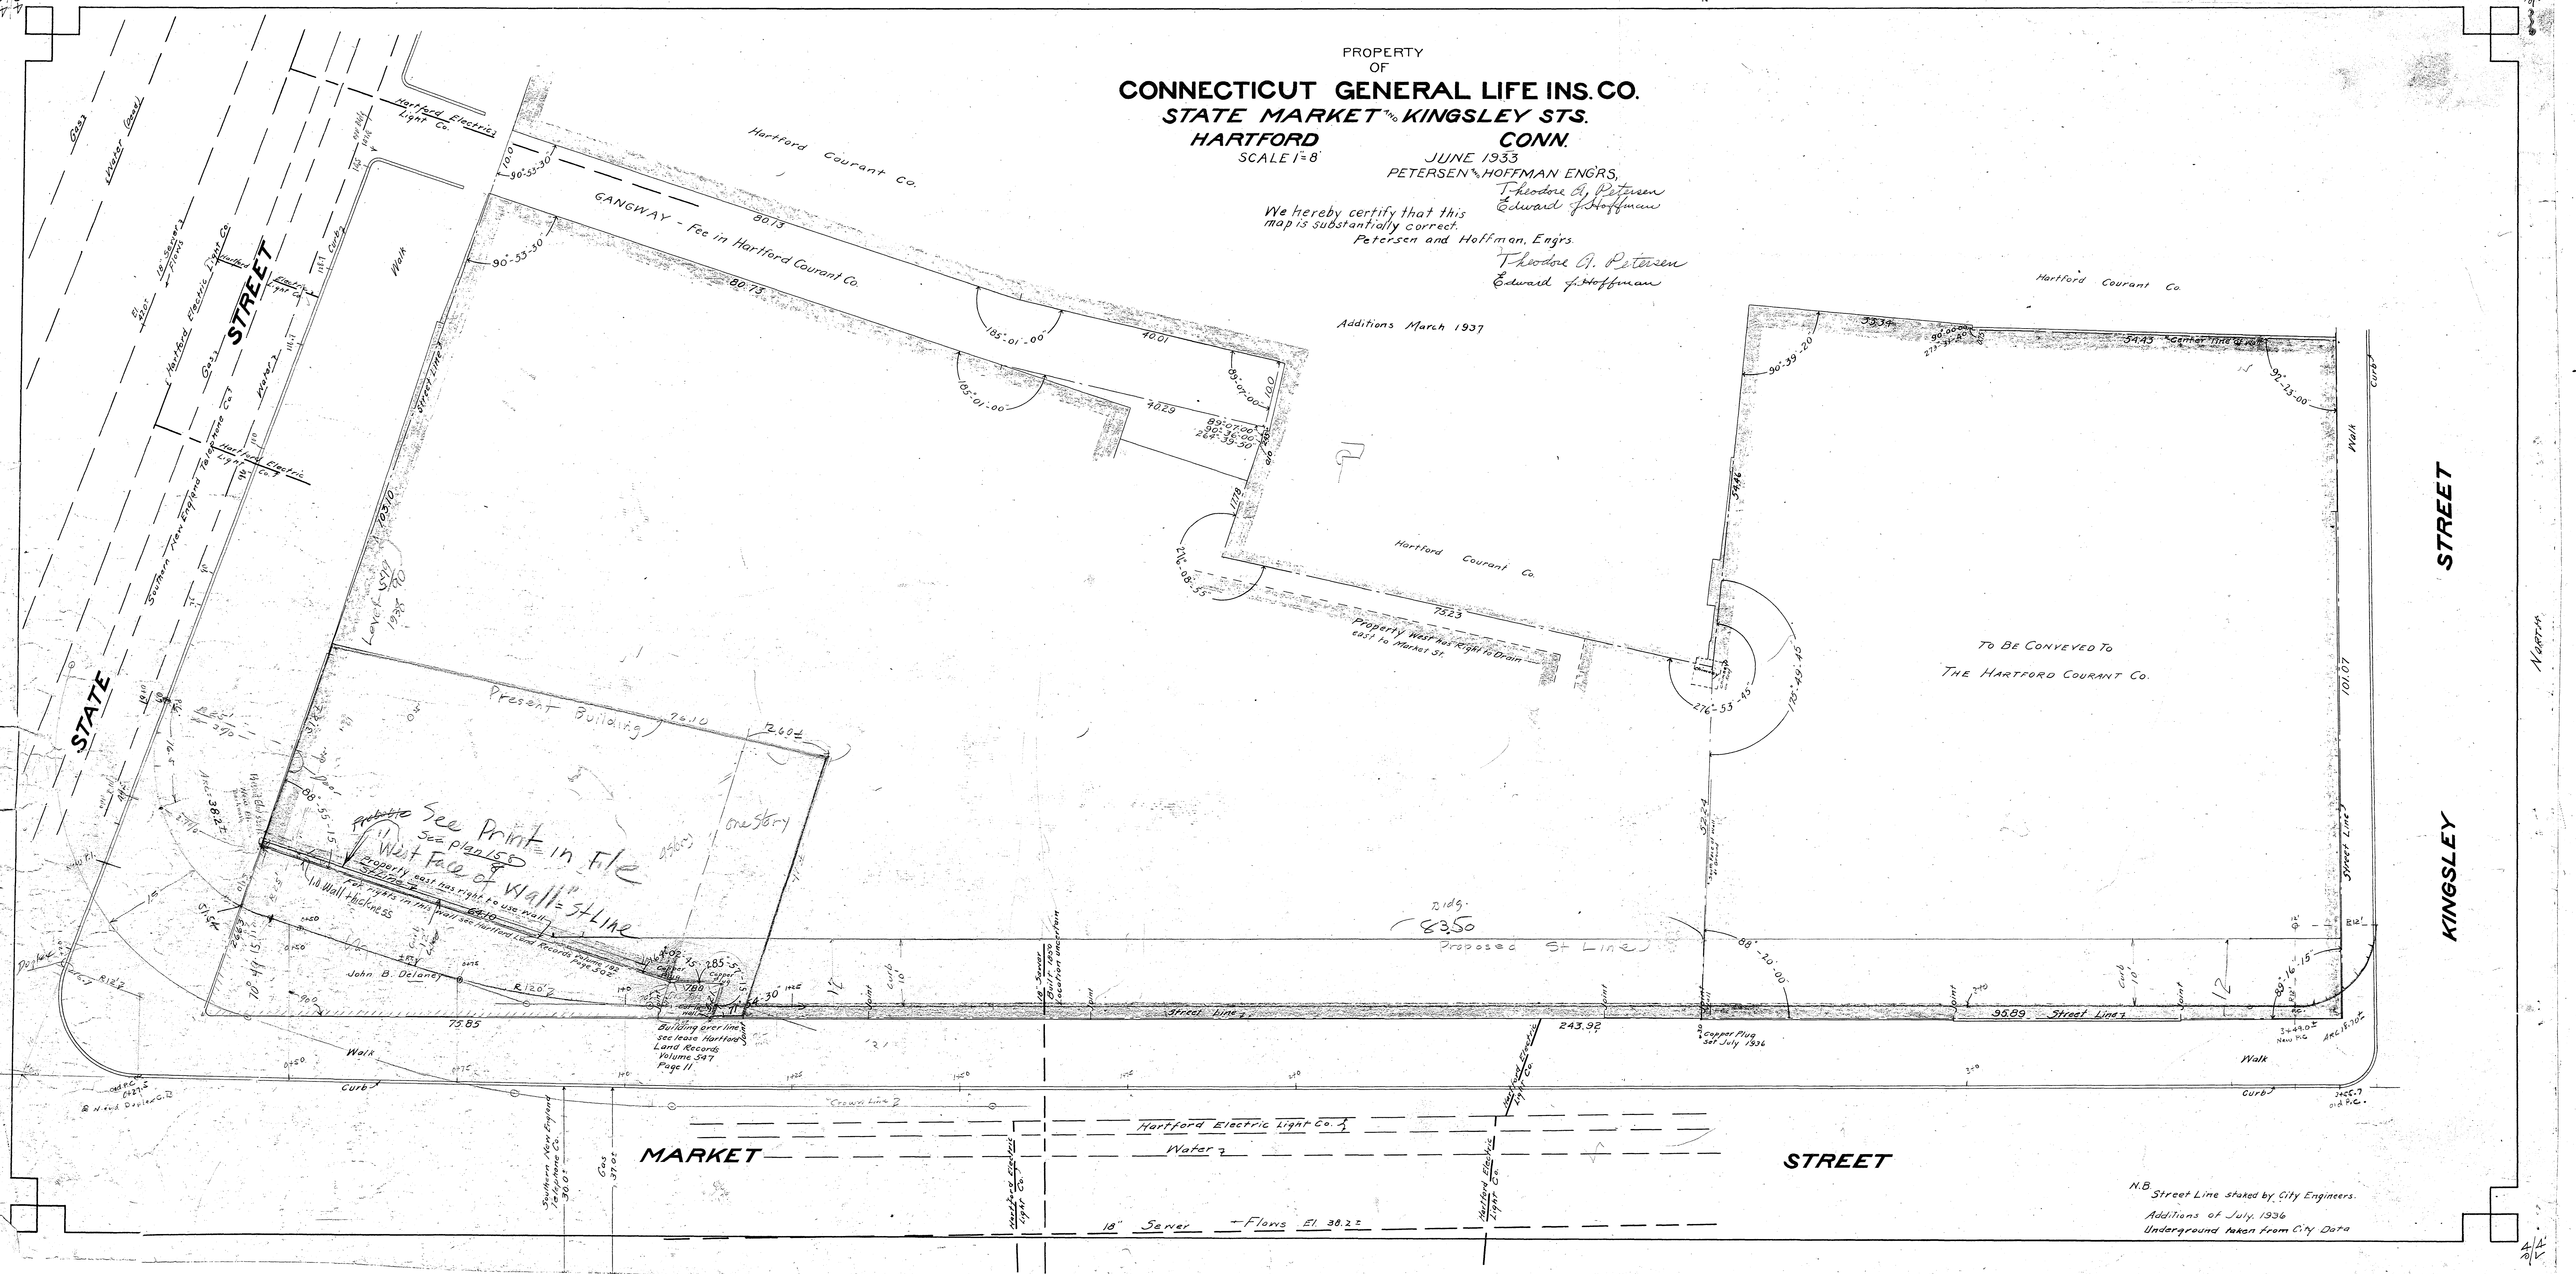

N.B. Street Line shared by City Engineers.
Additions of July, 1936
Underground taken from City Data