

1937









0+0 0+50 1+0 1+50 2+0 2+50 3+0 3+50 4+0

CURB PROFILE SHELDON STREET 1937


2. Proposed curb Line & Proposed street Line
elevations taken from cross sections

New
Roadway to be 36.72'
USE 18.4' as measurement
to figure cross-slope

Profile along E. of Sheldon St
Running
East from Sta 3+25 (near So. Prospect St)
(0+0 = at Main St.)

"1937" SHELDON STREET Main St To So Prospect St Curb Profile

N ← N-50 → South toward E. of South Prospect St at Header (then south on R.)

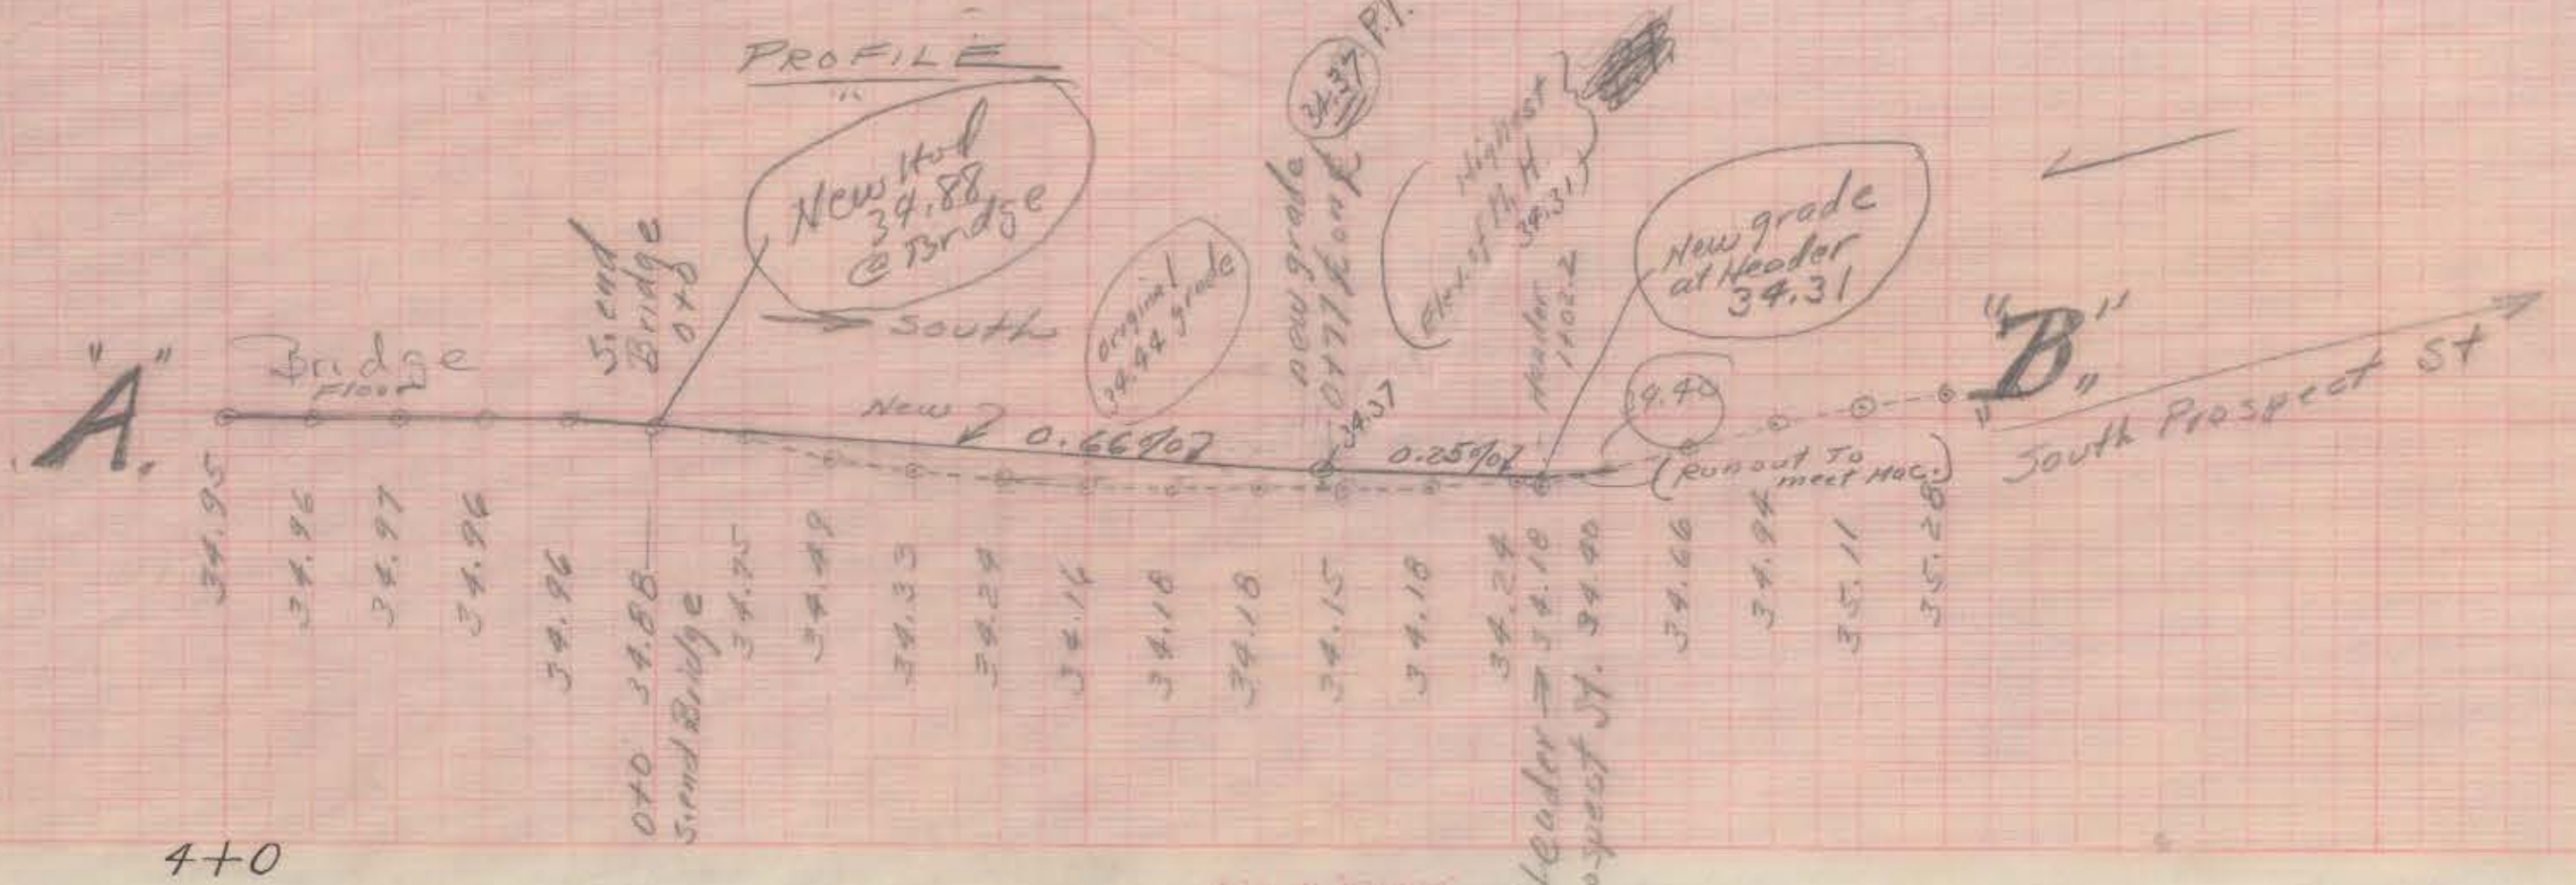

SHELDON STREET Main Street To So. Prospect Street CURB PROFILE Hor Scale 1"=20' Ver Scale 1"=2'

Day Book No. 07663

Note Book- 682
W.H. Drinnard

Jan-1937

Sheldon Street Profile

Revised
See 553
3

0+0 0+50 1+0 1+50 2+0 2+50 3+0 3+50 4+0