MARKET STREET
STATE STREET to KINSLEY STREET
CURB PROFILE
HOR SCALE 1"=20'
VER SCALE 1"=2'
Stations measured on new West Curb Line and on slope

Day Book No. 07697 Note Book 681

CITY OF HARTFORD
Department of Engineering
March 1938
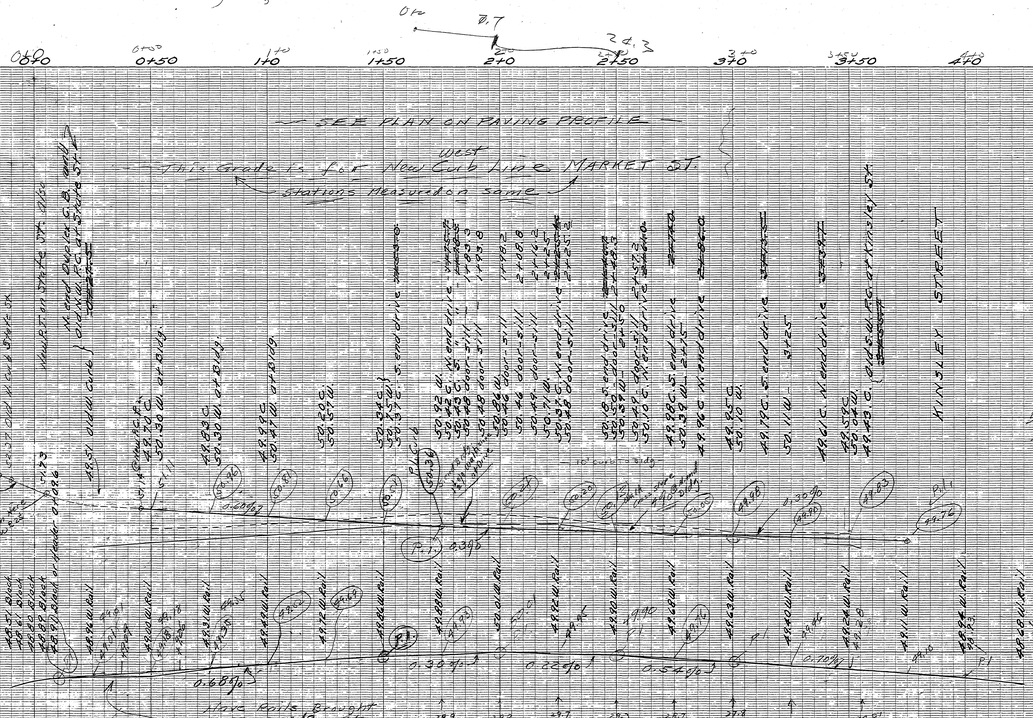
NOTE:
SEE (525/7) (plan 1940) also (525/9) (Cross Sections 1939) (1940) (533/9) (Profile of New East Curb 1939)