
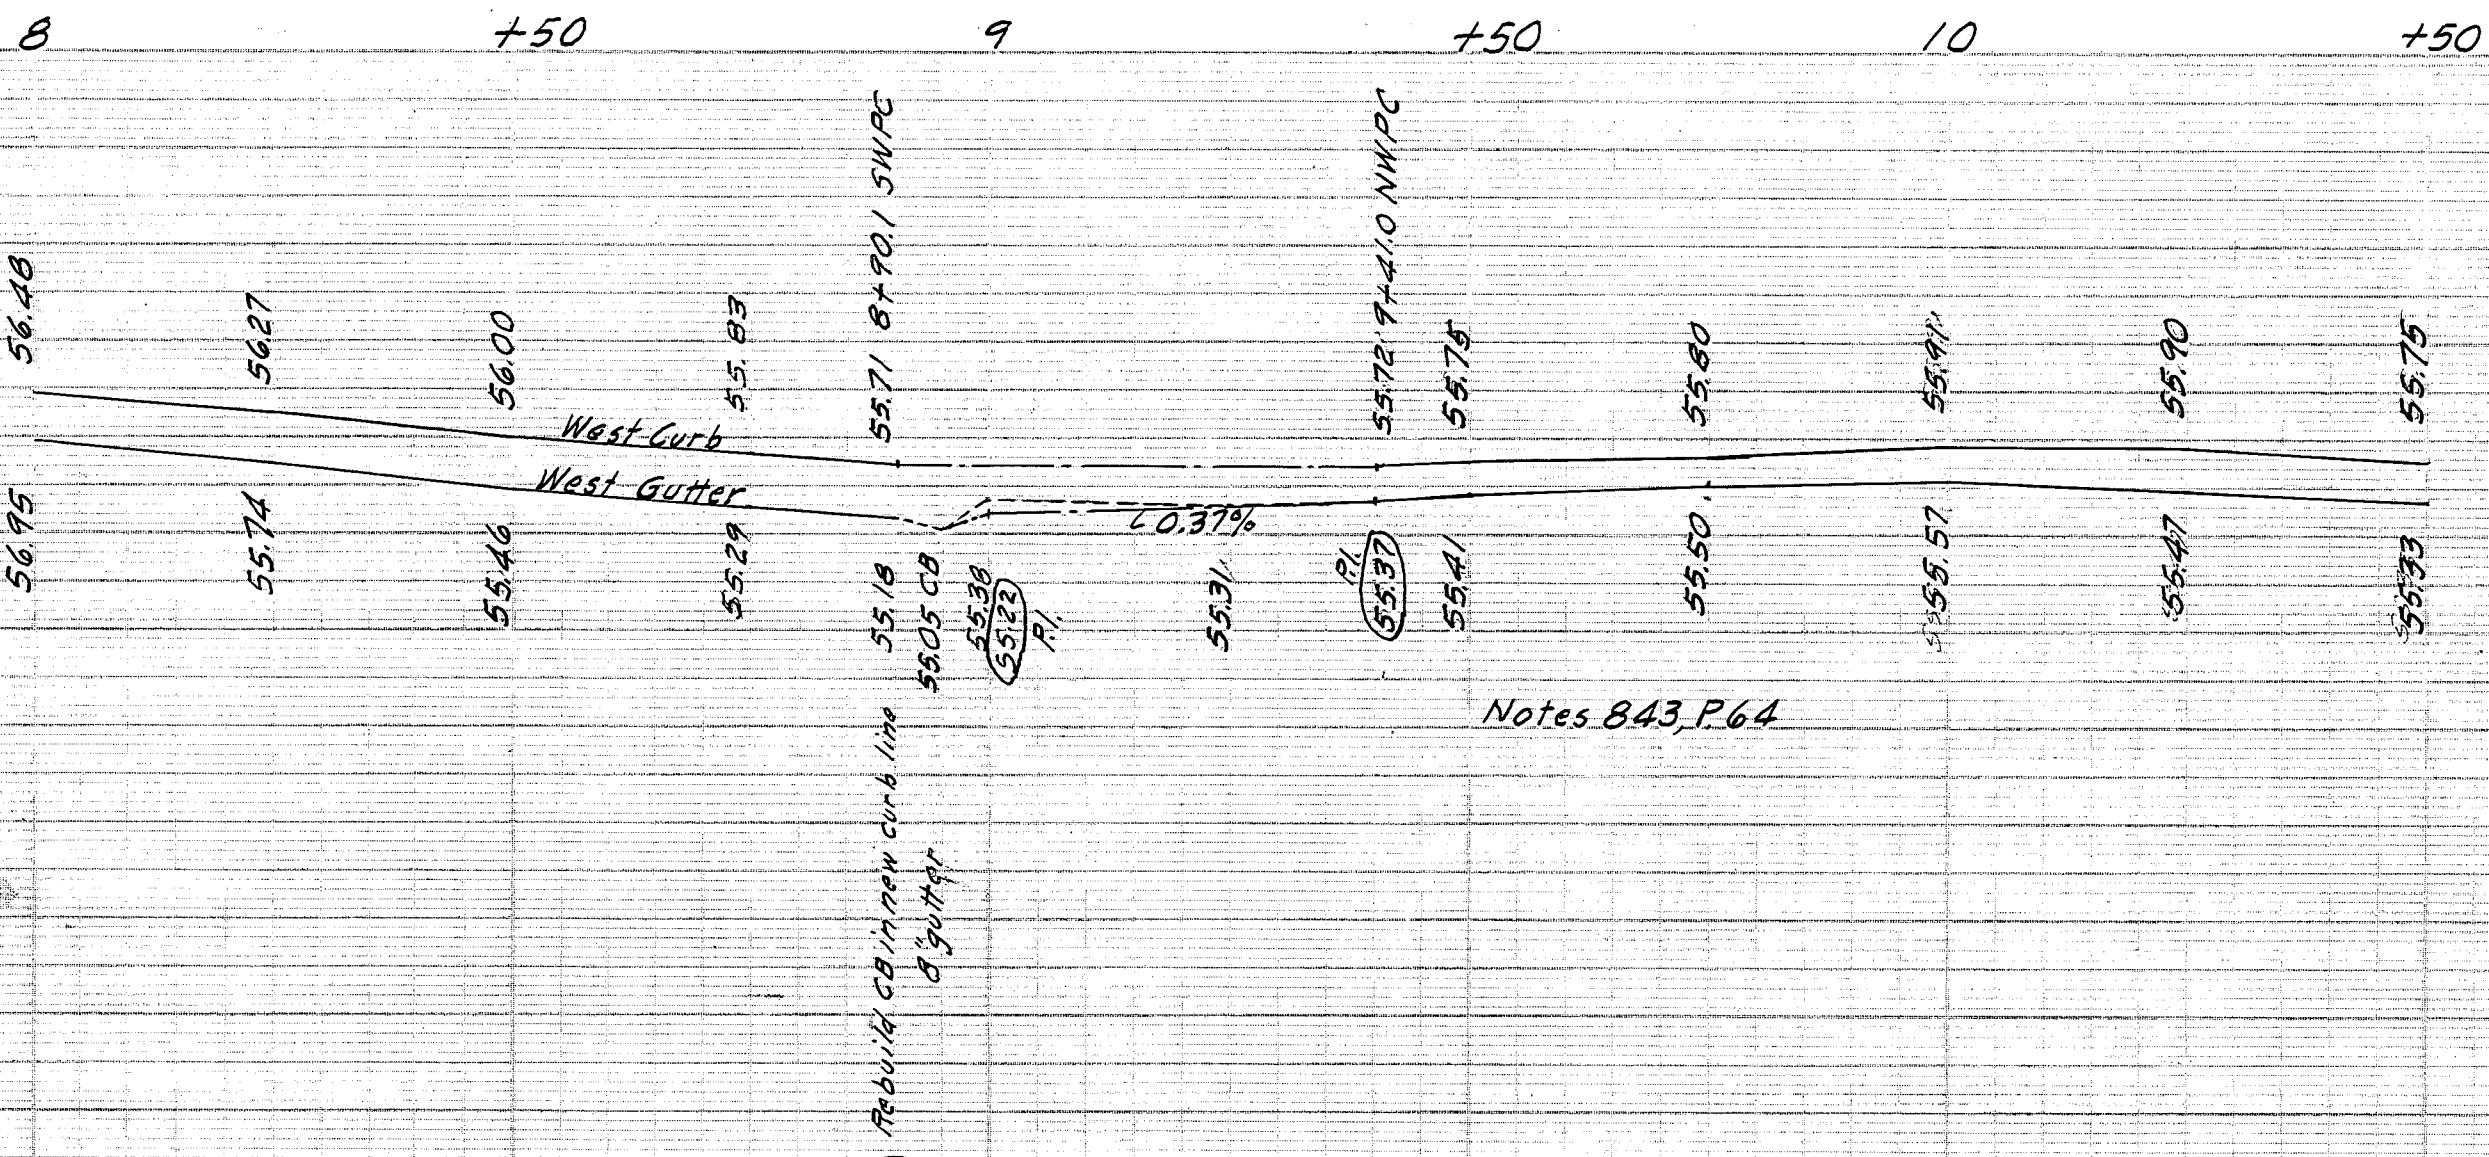
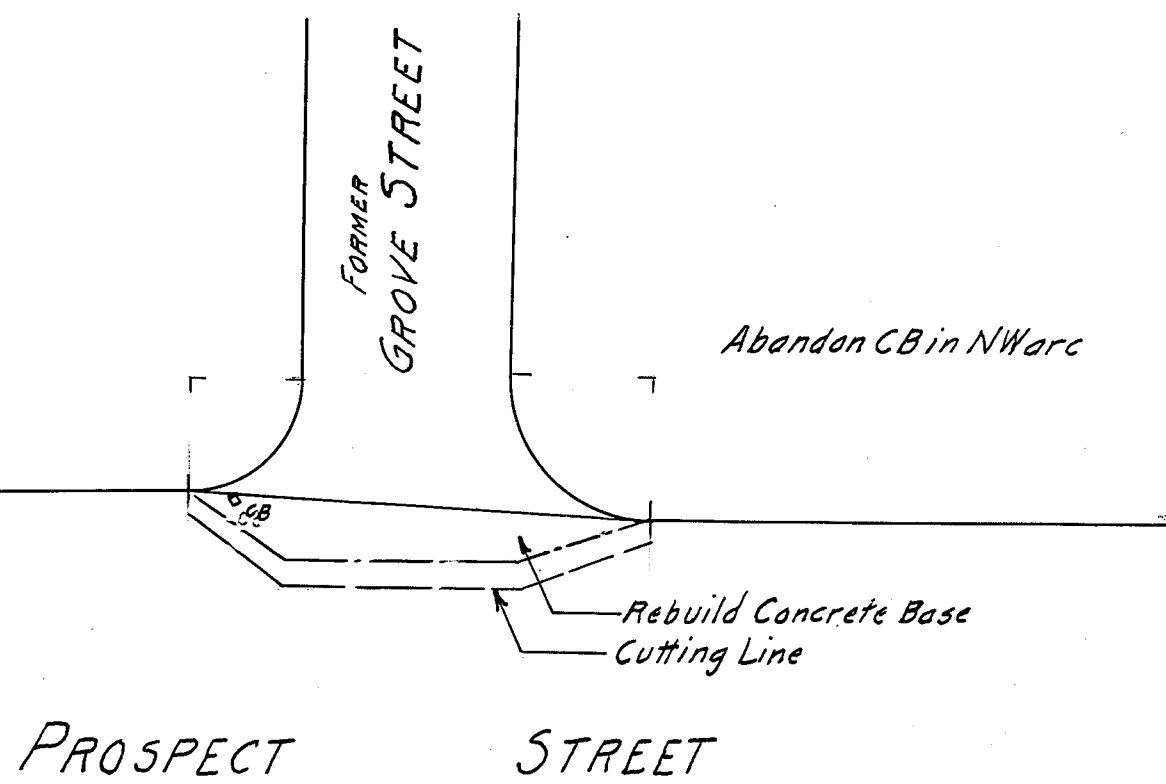


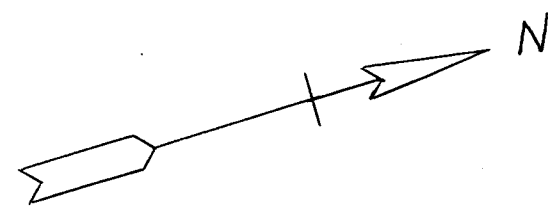

File with 529/2

Scales H. 1" = 20'
V. 1" = 2'

February 1970

Roll With $\frac{529}{2}$