


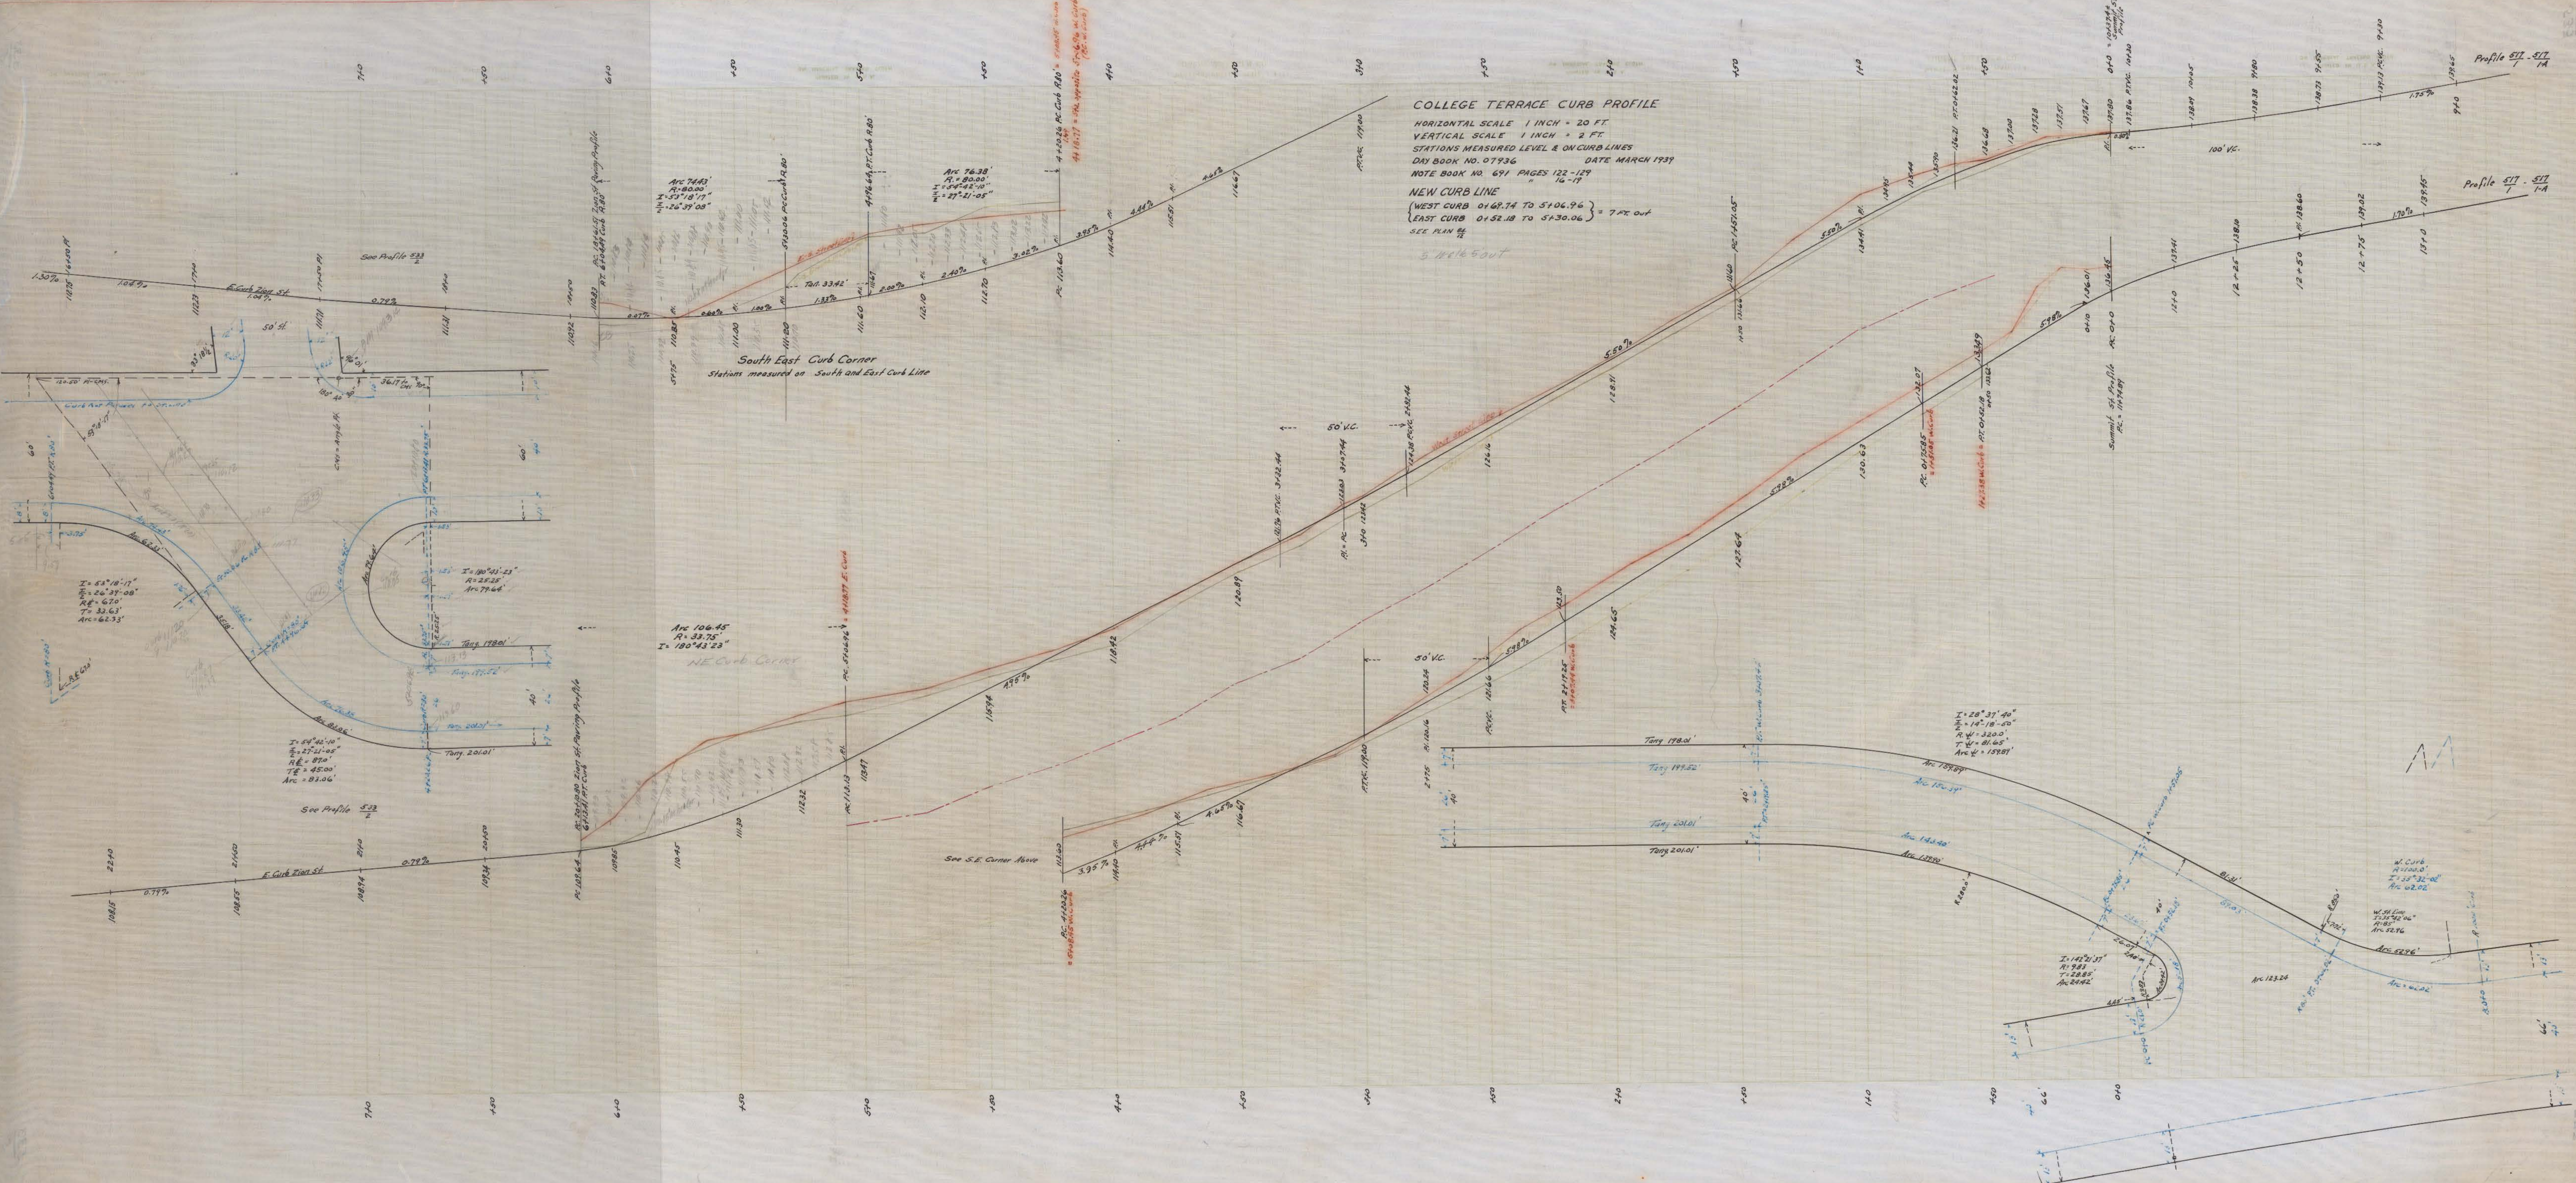

COLLEGE TERRACE CURB PROFILE

HORIZONTAL SCALE 1 INCH = 20 FT
VERTICAL SCALE 1 INCH = 2 FT
STATIONS MEASURED LEVEL & ON CURB LINES
DAY BOOK NO. 07936 DATE MARCH 1937
NOTE BOOK NO. 691 PAGES 122-129
NEW CURB LINE
(WEST CURB 0167.74 TO 5106.96)
(EAST CURB 0152.18 TO 5130.06) = 7 FT OUT
SEE PLAN 84

South East Curb Corner
Stations measured on South and East Curb Line

NE Curb Corner
Arc 106.45
R = 33.75
I = 180°43'23"

I = 28°37'40"
R = 14'18'-50"
R.W. = 32.00'
T.W. = 81.00'
Arc = 158.89'

W. Curb
I = 33°32'00"
R = 62.62'
W. S. Line
I = 22°32'00"
R = 80'
Arc = 52.76'