
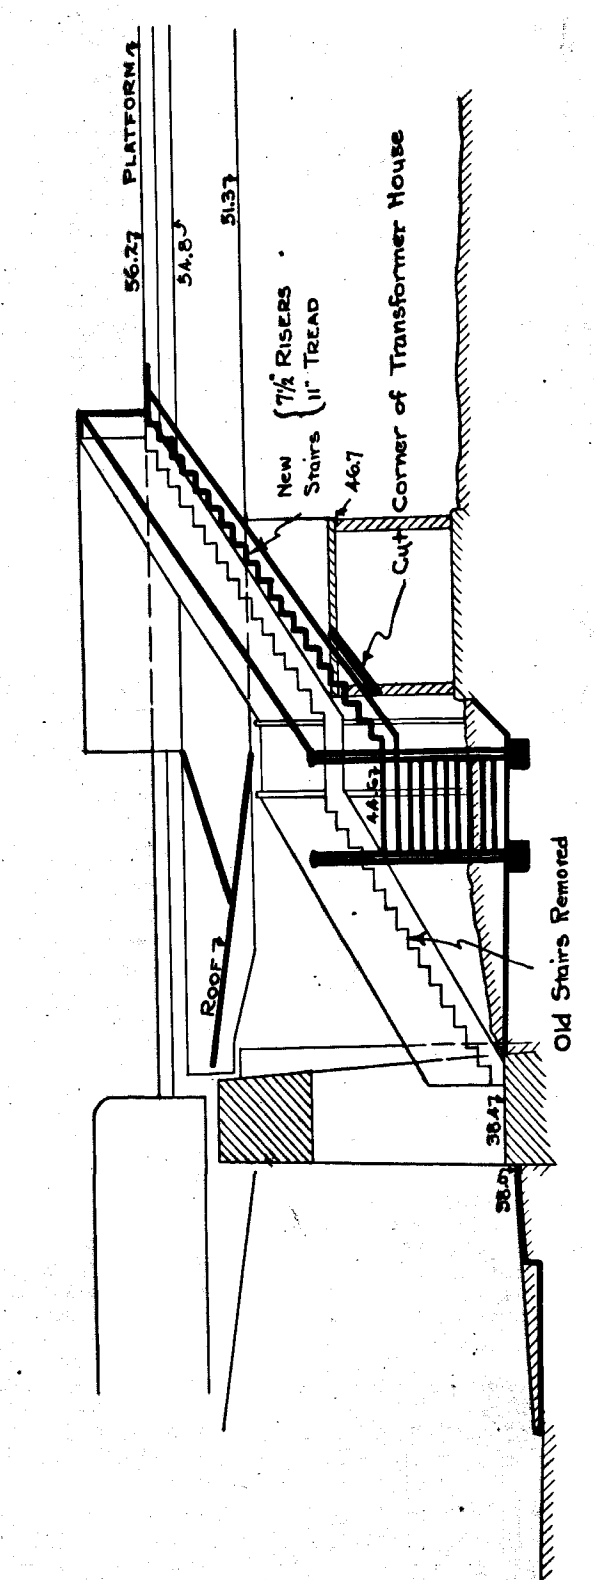


Advised by proposed widening of 15' to 20' on north side

Advised by proposed widening of 15' to 20' on north side

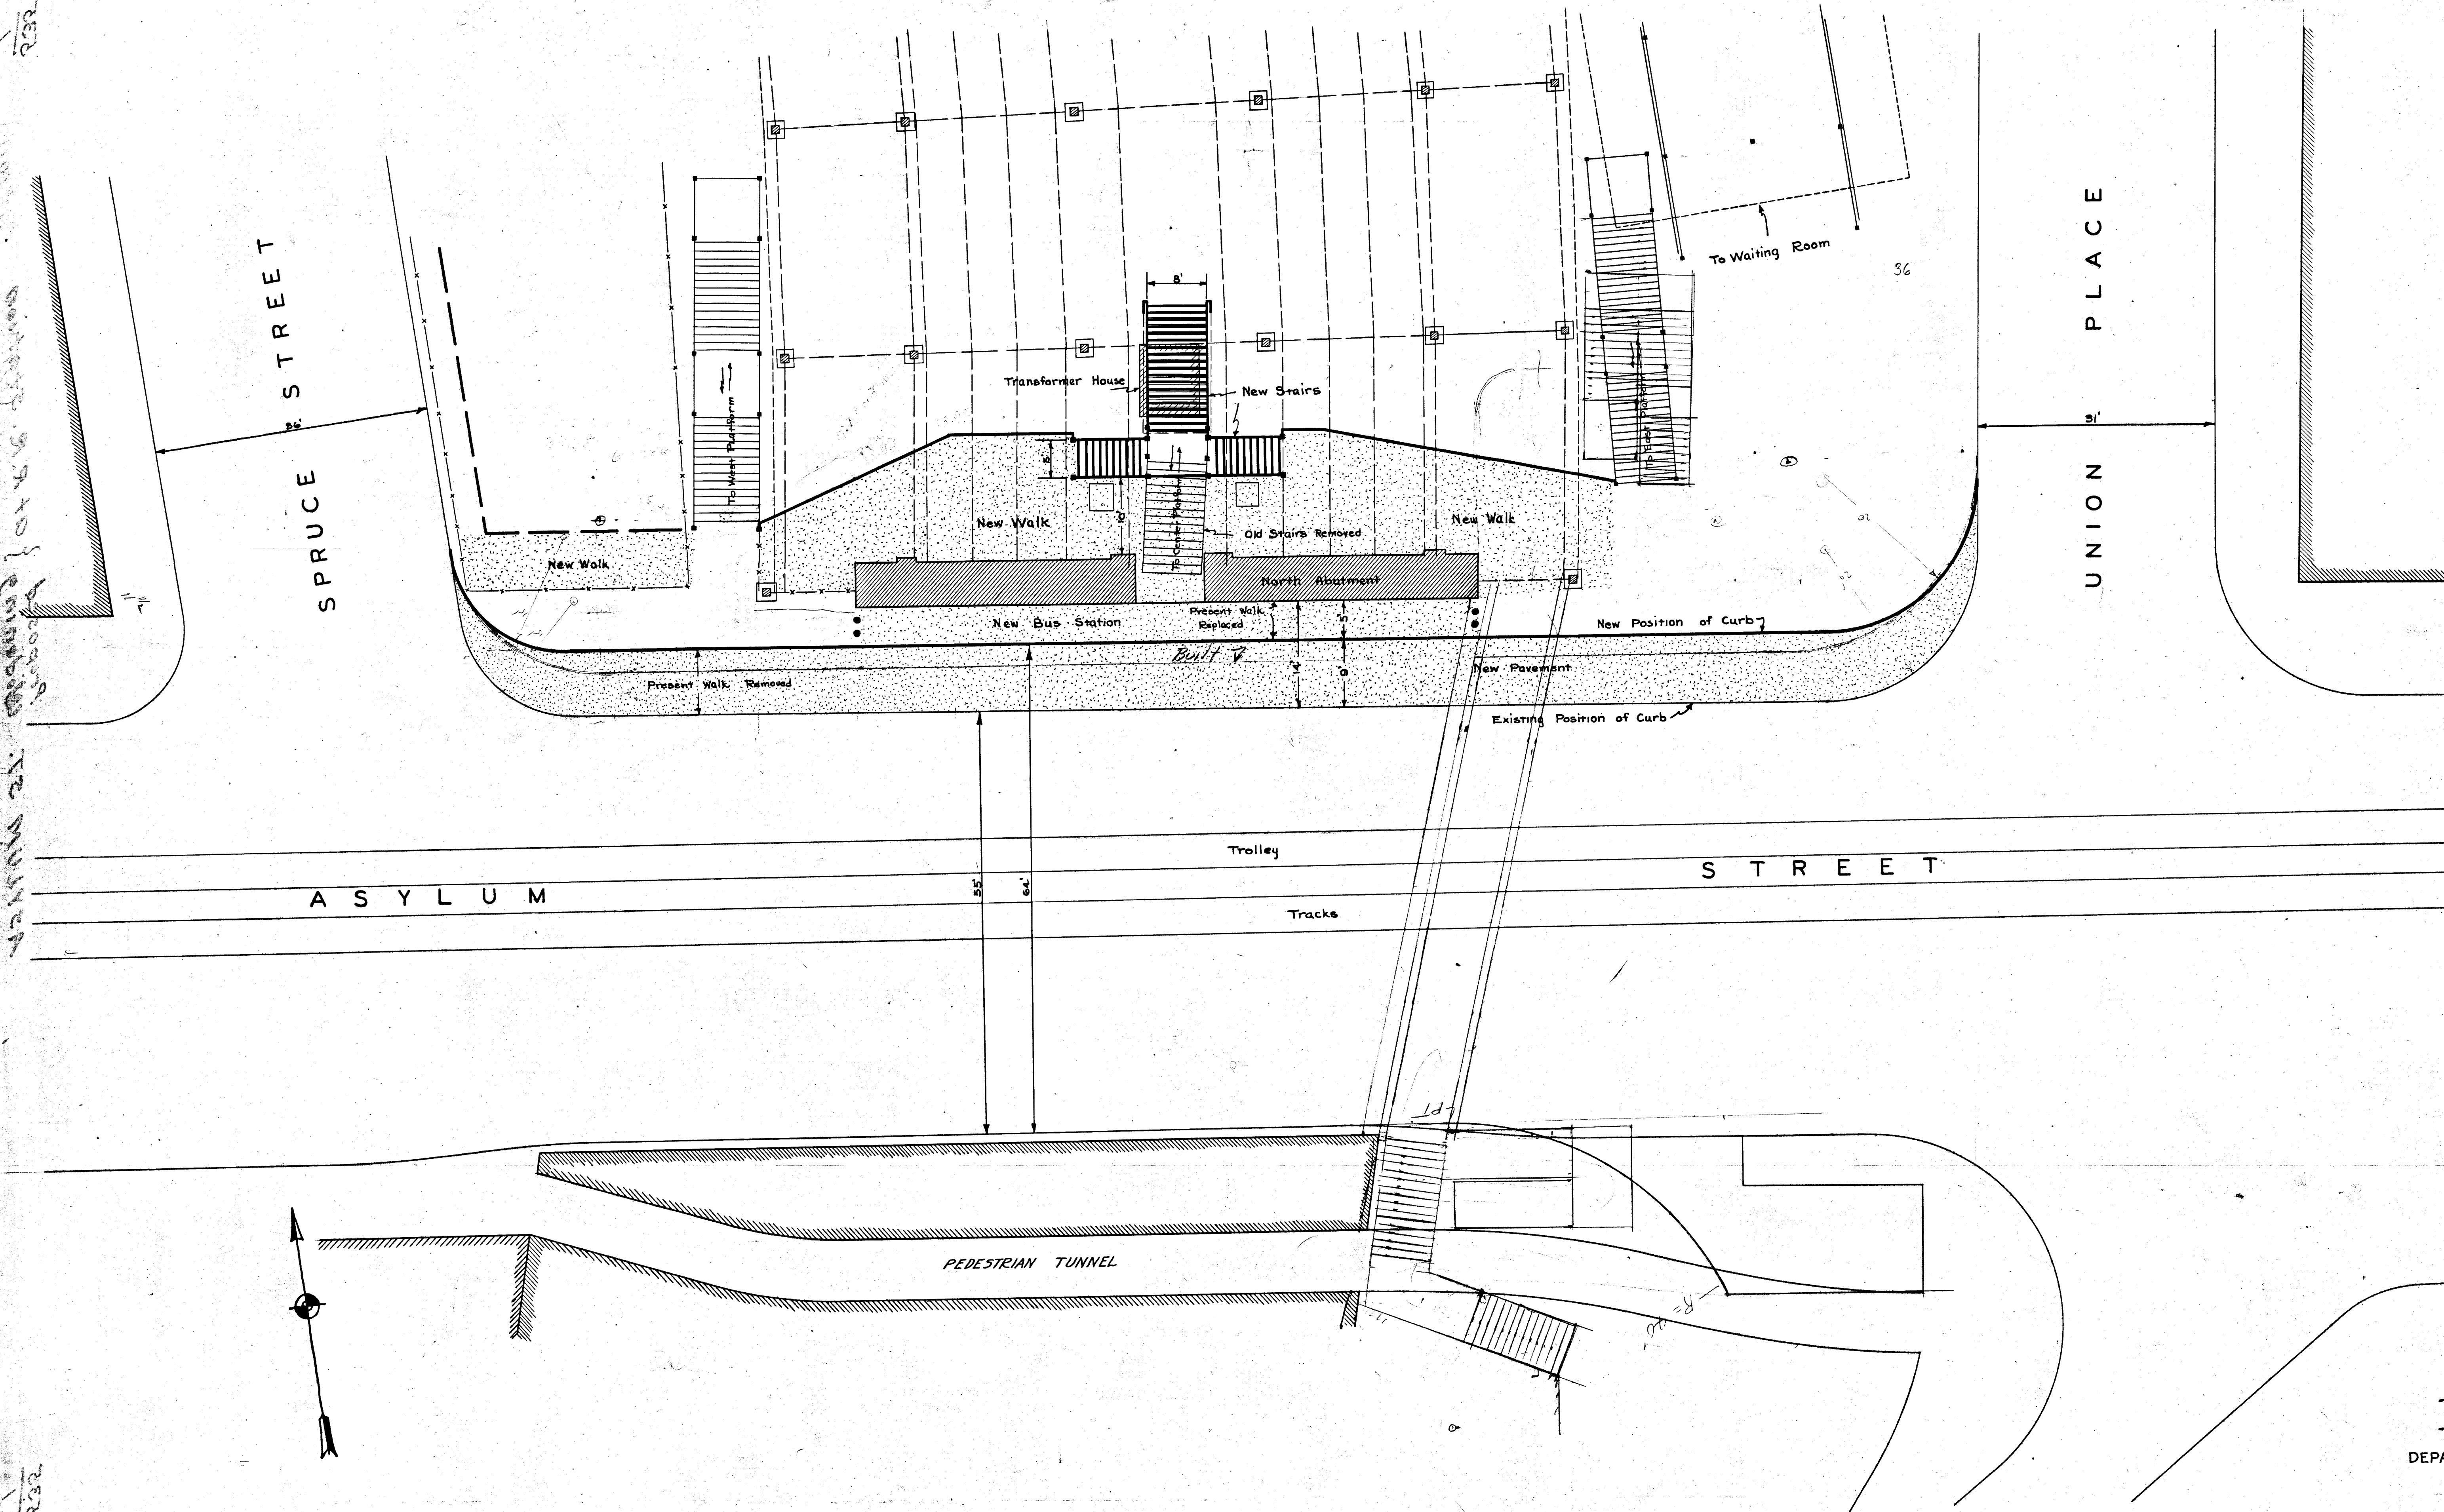

See Temporary Curb + Walk Changes
Plan by D.I.T. of Sept. 15, 1941
in D.I.T. file
See 274-16 & 17 for Pedestrian Underpass
North side
See 567-2 dated 1944 for curbwork in 1945
CITY OF HARTFORD
DEPARTMENT OF ENGINEERING
SCALE 1"=10'
Daybook No. 07939