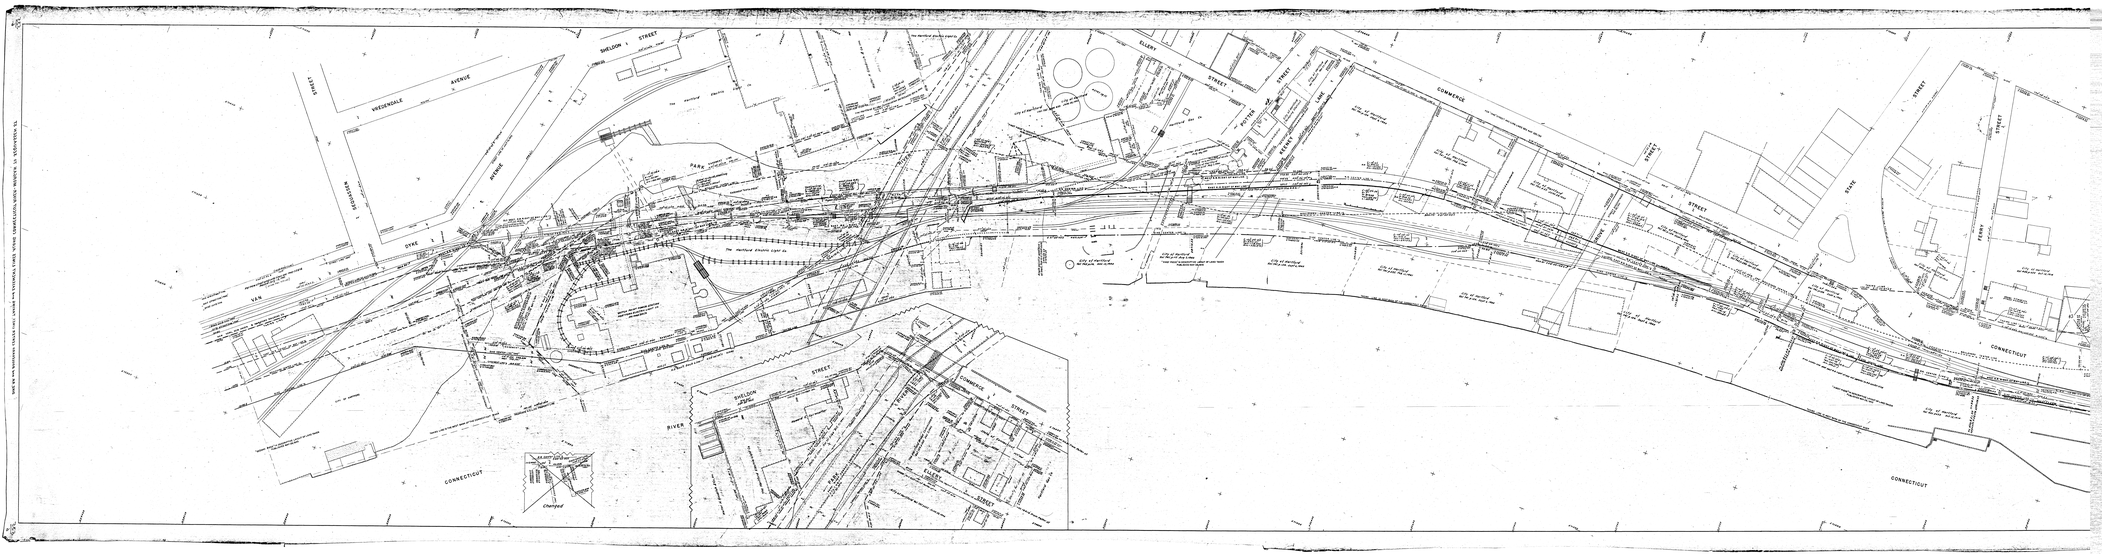
SHELDON STREET
VREDENDALE AVENUE
WATERSIDE STREET
DYKE AVENUE
PARK AVENUE
ELLERY STREET
PUTNAM STREET
COMMERCE STREET
PARK AVENUE
FERRY STREET
CONNECTICUT RIVER
CONNECTICUT
CONNECTICUT
CONNECTICUT
Changed