


ASU M. BARNARD
ON CORNER IN 1924

ENGINE DIVISION CO.
PERFECT, CHART, SECTION 10X10

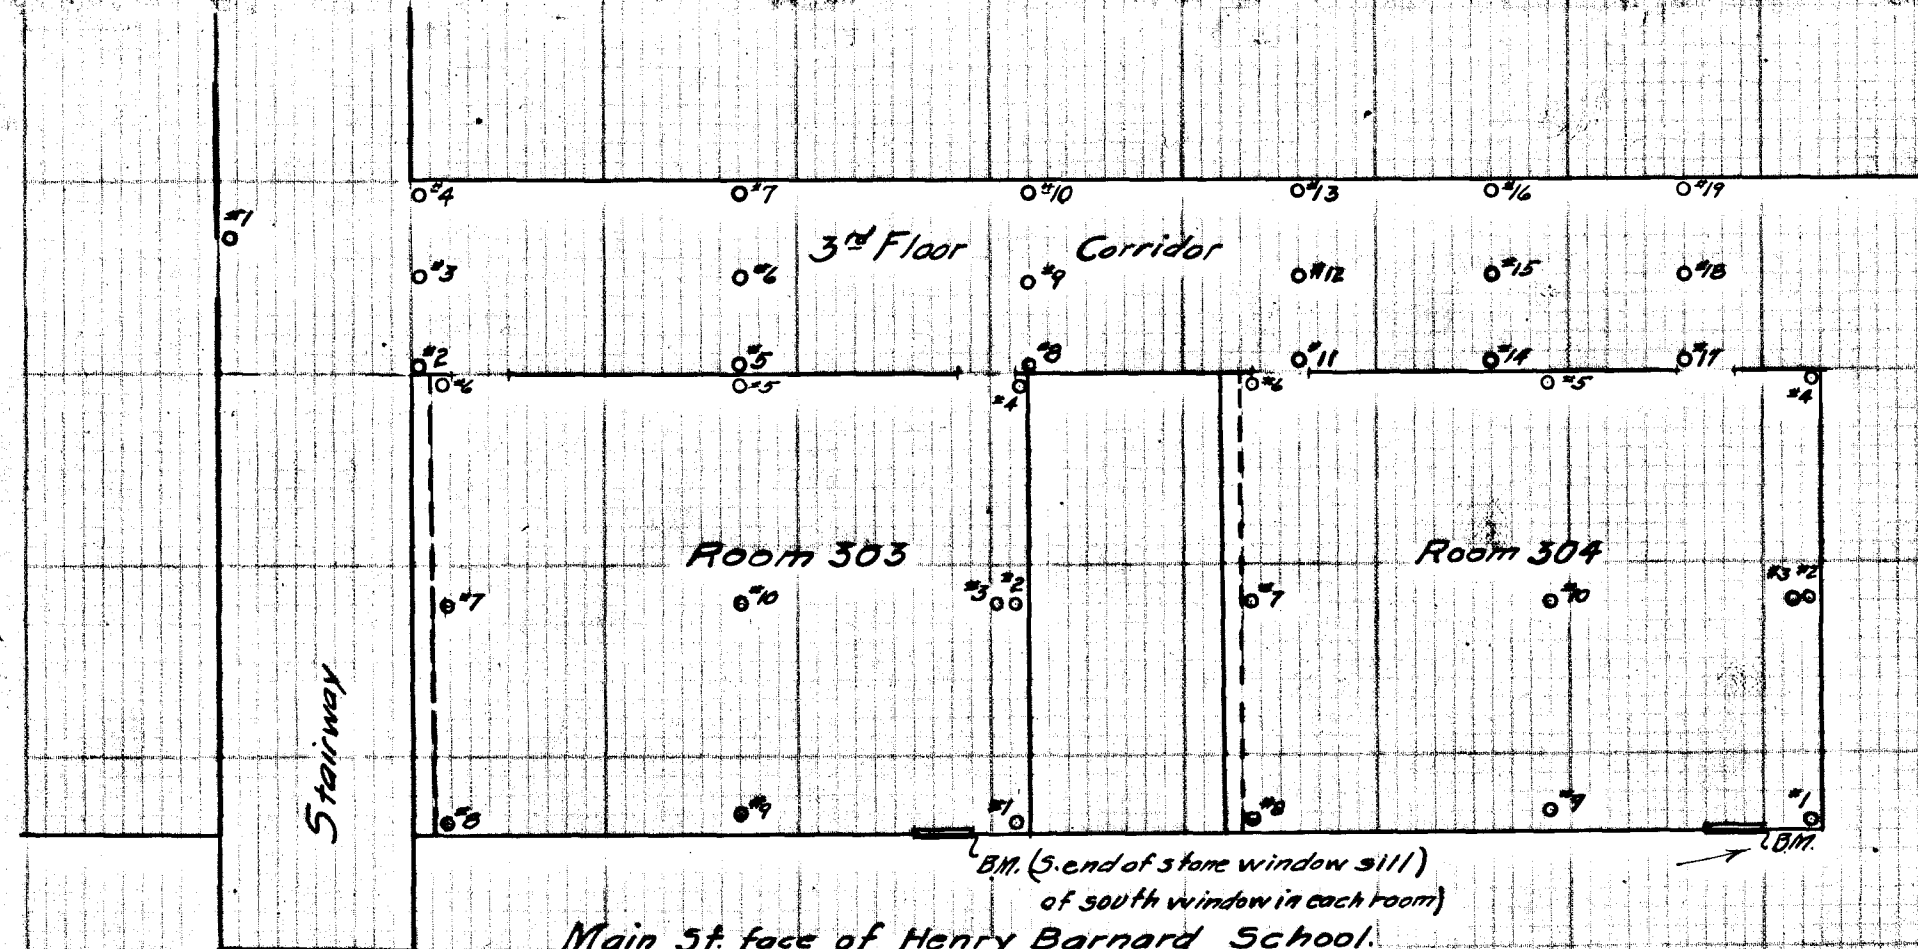


Main St. face of Henry Barnard School.

Note: Points are steel tacks driven into floor at points indicated by numbers.
Note Book 346 P. 12

Room 303			
Point No.	ELEVATIONS		
B.M. Assumed elev. 100.	8/21/37	12/27/39	7/11/40
1	97.442	97.442	97.442
2	376	375	375
3	371	335	336
4	444	439	442
5	457	450	454
6	416	409	415
7	421	411	421
8	444	440	443
9	369	363	365
10	292	27.280	270

Room 304			
Point No.	ELEVATIONS		
B.M. Assumed elev. 100.	8/21/37	12/27/39	7/11/40
1	97.439	97.438	97.437
2	341	340	339
3	303	303	303
4	431	425	429
5	419	411	421
6	412	402	413
7	313	306	314
8	452	450	454
9	391	386	393
10	253	27.247	253

3rd Floor Corridor			
Point No.	ELEVATIONS		
B.M. on sill in room 304	8/21/37	12/27/39	7/11/40
1	97.431	97.424	97.429
2	433	428	431
3	448	430	444
4	450	449	449
5	468	464	467
6	458	448	459
7	448	440	446
8	475	469	473
9	473	466	471
10	513	505	508
11	411	407	408
12	411	406	413
13	386	380	385
14	413	424	429
15	428	422	427
16	415	408	411
17	443	442	441
18	440	432	440
19	406	404	406

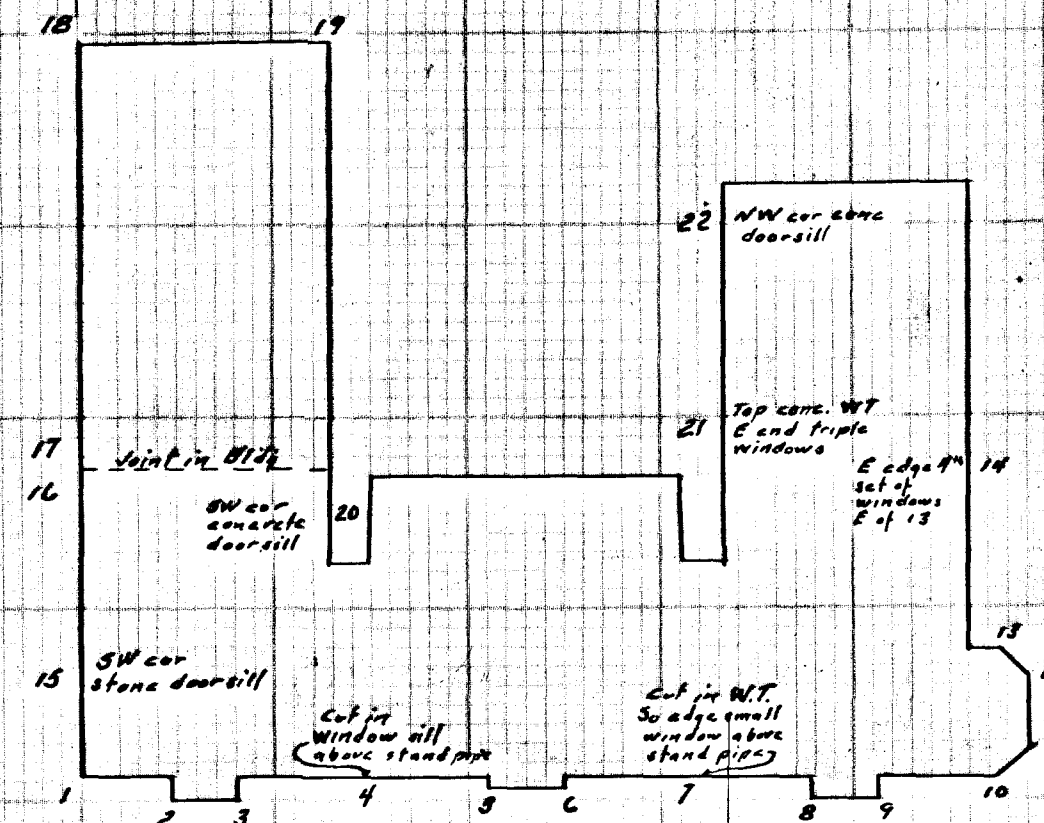

Note: Points at which elevations were taken are cuts in water table, unless otherwise noted in sketch.

B.M. 100.0 (assumed) Top of iron guard at NE cor bldg #1293 Main St., W side driveway Bidwell Hardware Co.

NB 346 123 95.262 Top brown stone coping against iron fence at extreme E end of fence around Keney Memorial.

Point No.	8/21/37	12/27/39	7/11/40
1	102.017	102.007	102.017
2	101.993	101.976	101.977
3	102.015	102.001	102.009
4	101.947	101.936	101.937
5	102.012	101.994	101.999
6	102.021	102.002	102.010
7	102.015	101.994	102.005
8	102.053	102.035	102.045
9	102.070	102.060	102.061
10	102.105	102.104	102.099
11	102.064	102.061	102.063
12	102.086	102.079	102.077
13	102.062	102.055	102.053
14	102.132	102.131	102.122
15	99.669	99.649	99.663
16	102.021	101.996	102.012
17	102.059	102.035	102.051
18	102.081	102.081	102.081
19	102.019	102.005	102.016
20	98.677	98.671	98.670
21	102.109	102.109	102.111
22	98.552	98.551	98.548