


PROPERTY OF
CITY OF HARTFORD
IN
WETHERSFIELD AND ROCKY HILL
SCALE: 1"=200' MAY 1959

July 31, 1959- NOTE: Orchard Street as shown below renamed
Charter Road by Town of Rocky Hill on Sept. 4, 1948.

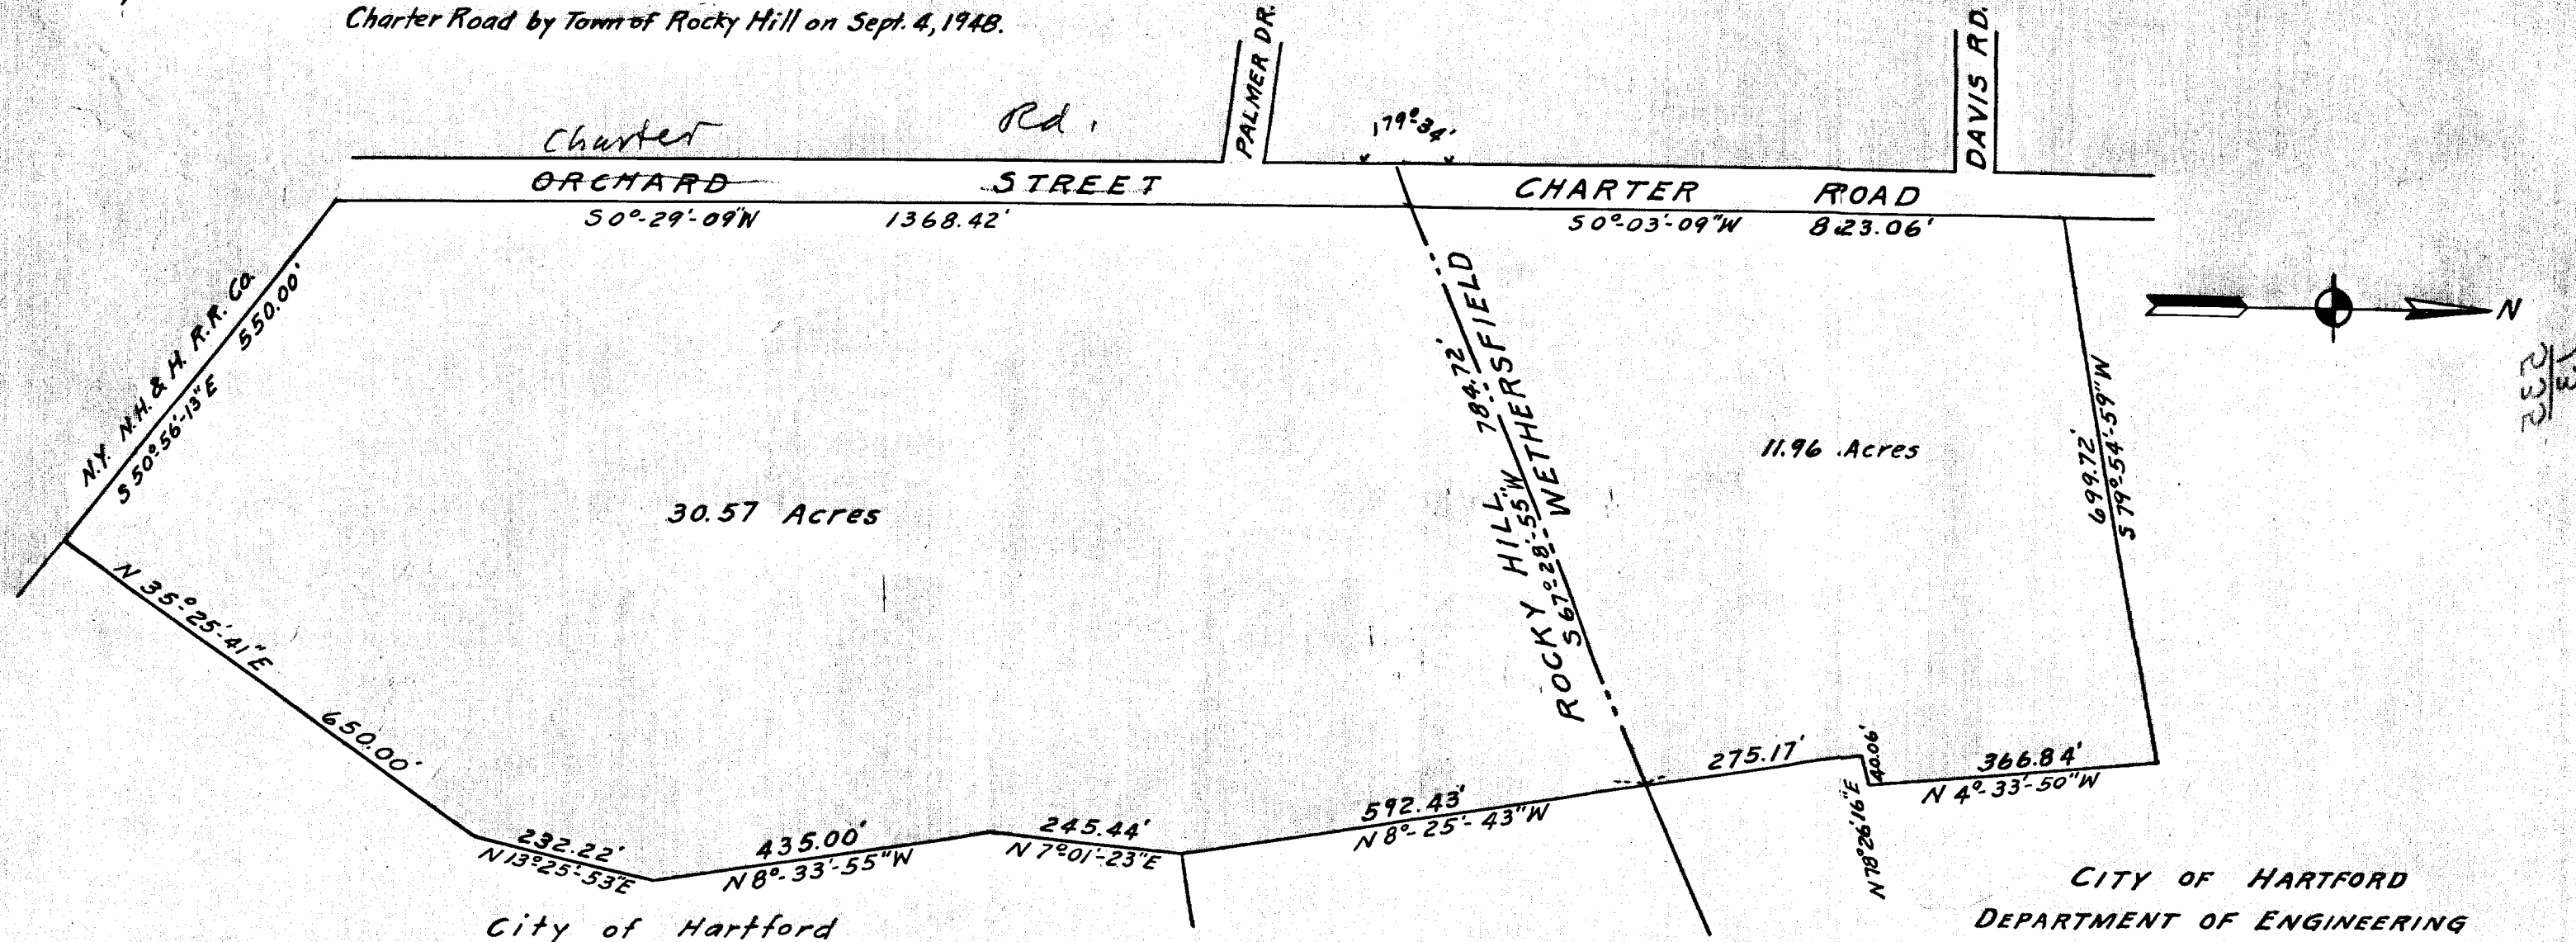

CITY OF HARTFORD
DEPARTMENT OF ENGINEERING
DAYBOOK No. 09579