


PROPERTY OF
CITY OF HARTFORD
IN
WETHERSFIELD AND ROCKY HILL
SCALE: 1"=200' MAY 1959

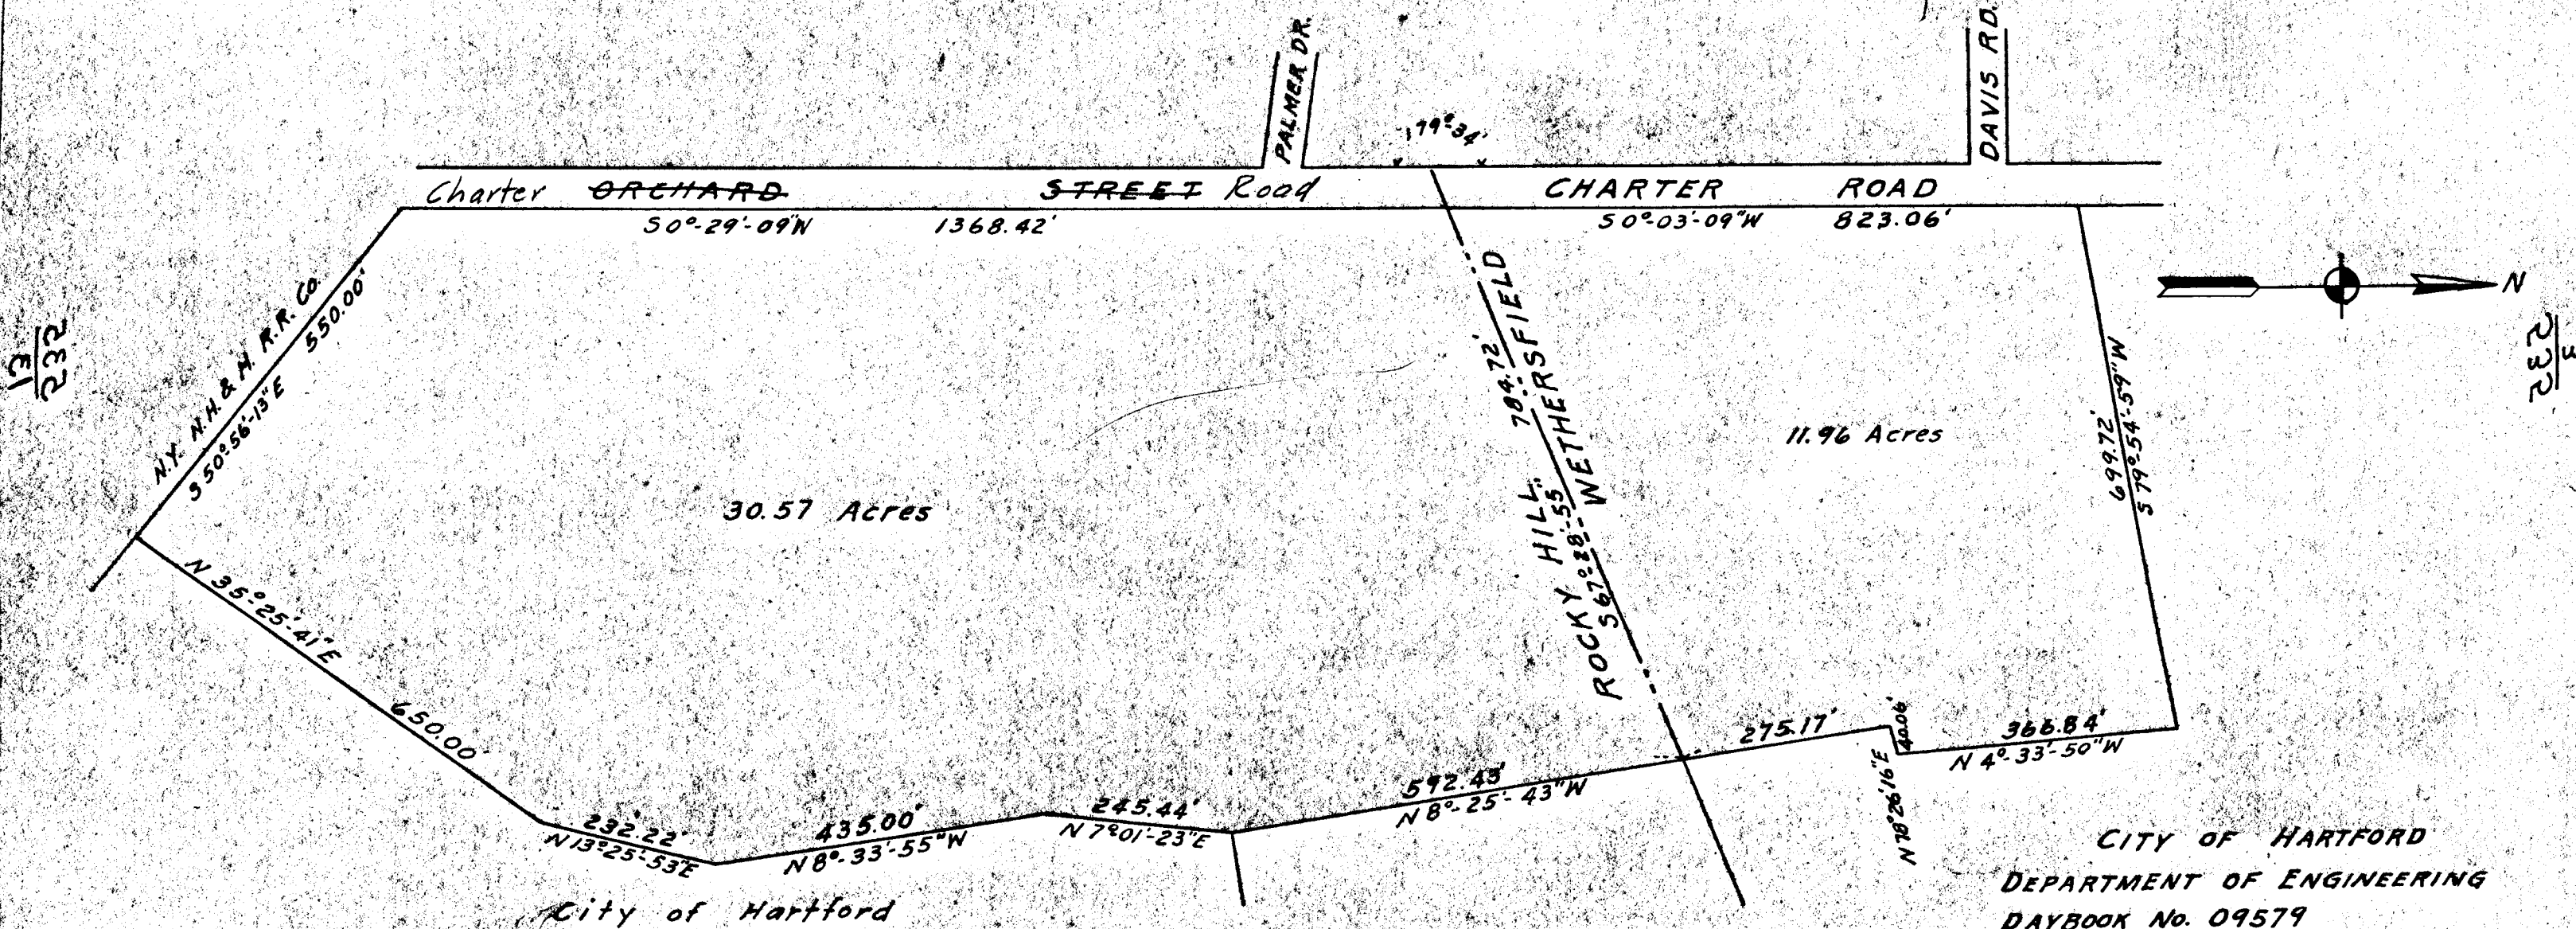

CITY OF HARTFORD
DEPARTMENT OF ENGINEERING
DAYBOOK No. 09579