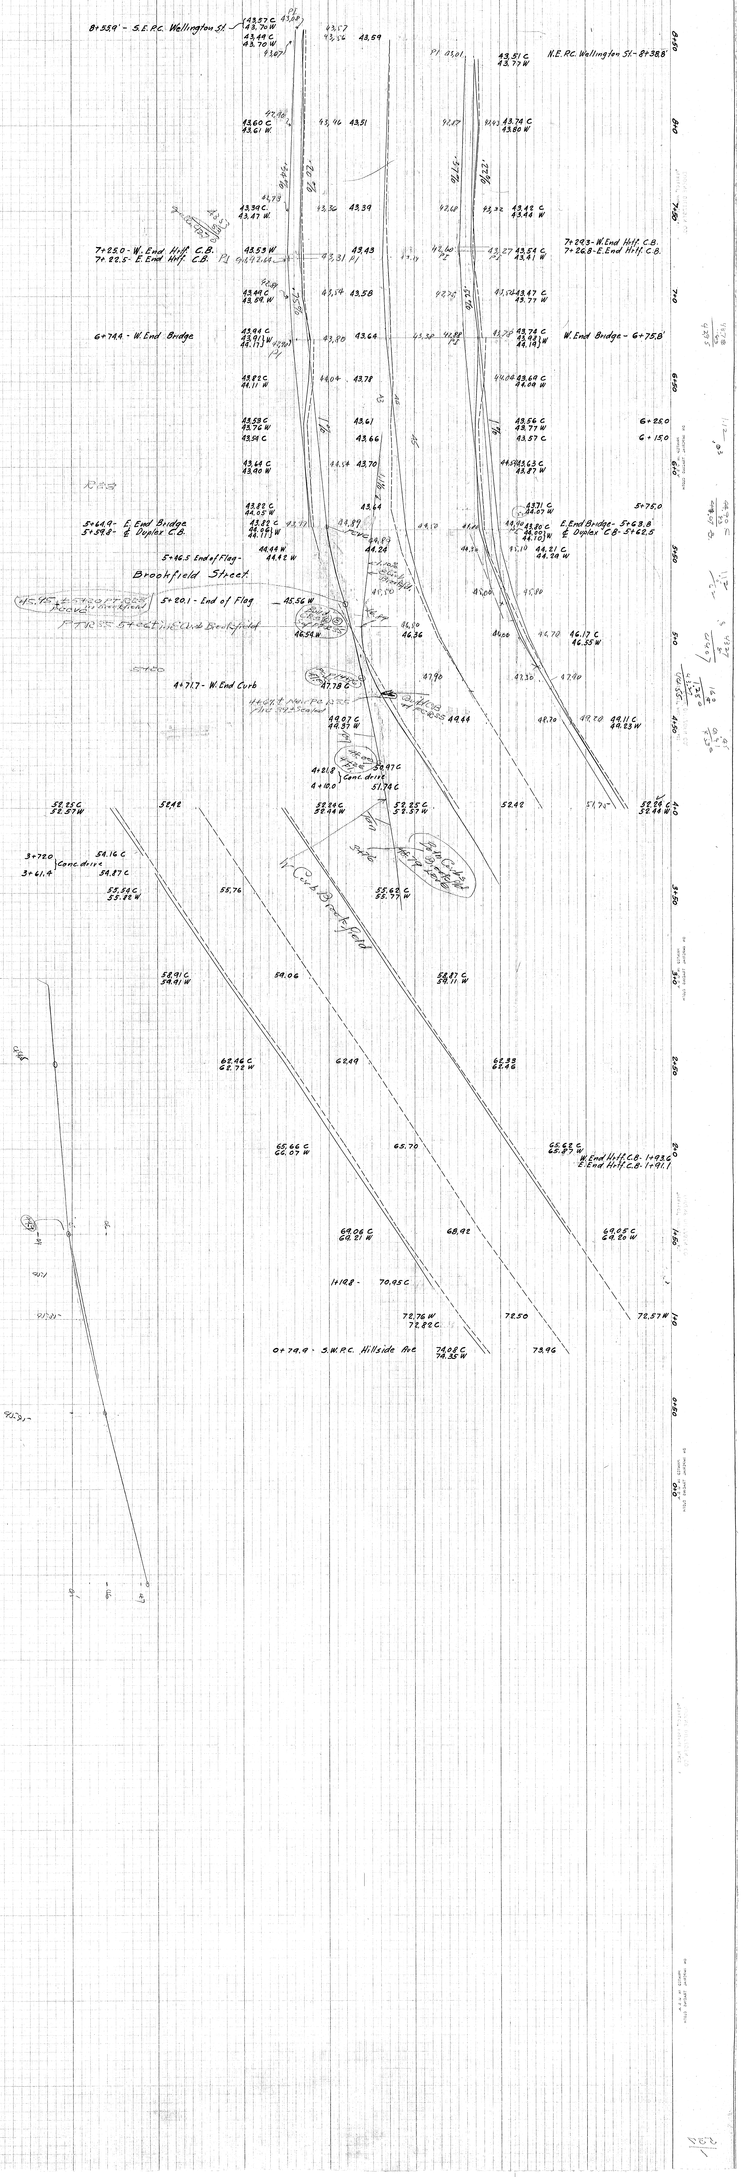
8+33.9' - S.E.R.C. Wellington St.
N.E.R.C. Wellington St.- 8+38.8'
7+28.0 - W. End Hiff. C.B.
7+22.5 - E. End Hiff. C.B.
7+29.3 - W. End Hiff. C.B.
7+26.8 - E. End Hiff. C.B.
6+74.4 - W. End Bridge
W. End Bridge - 6+75.8'
5+64.9 - E. End Bridge
5+59.8 - E. Duplex C.B.
E. End Bridge - 5+63.8
E. Duplex C.B. - 5+62.5
5+46.5 End of Flag -
Brookfield Street
5+80.1 - End of Flag
4+71.7 - W. End Curb
3+72.0 Conc. dirt
3+61.4
Curb of Brookfield
0+74.4 - S.W.R.C. Hillside Ave.
W. End Hiff. C.B. 1+93.0
E. End Hiff. C.B. 1+91.1