
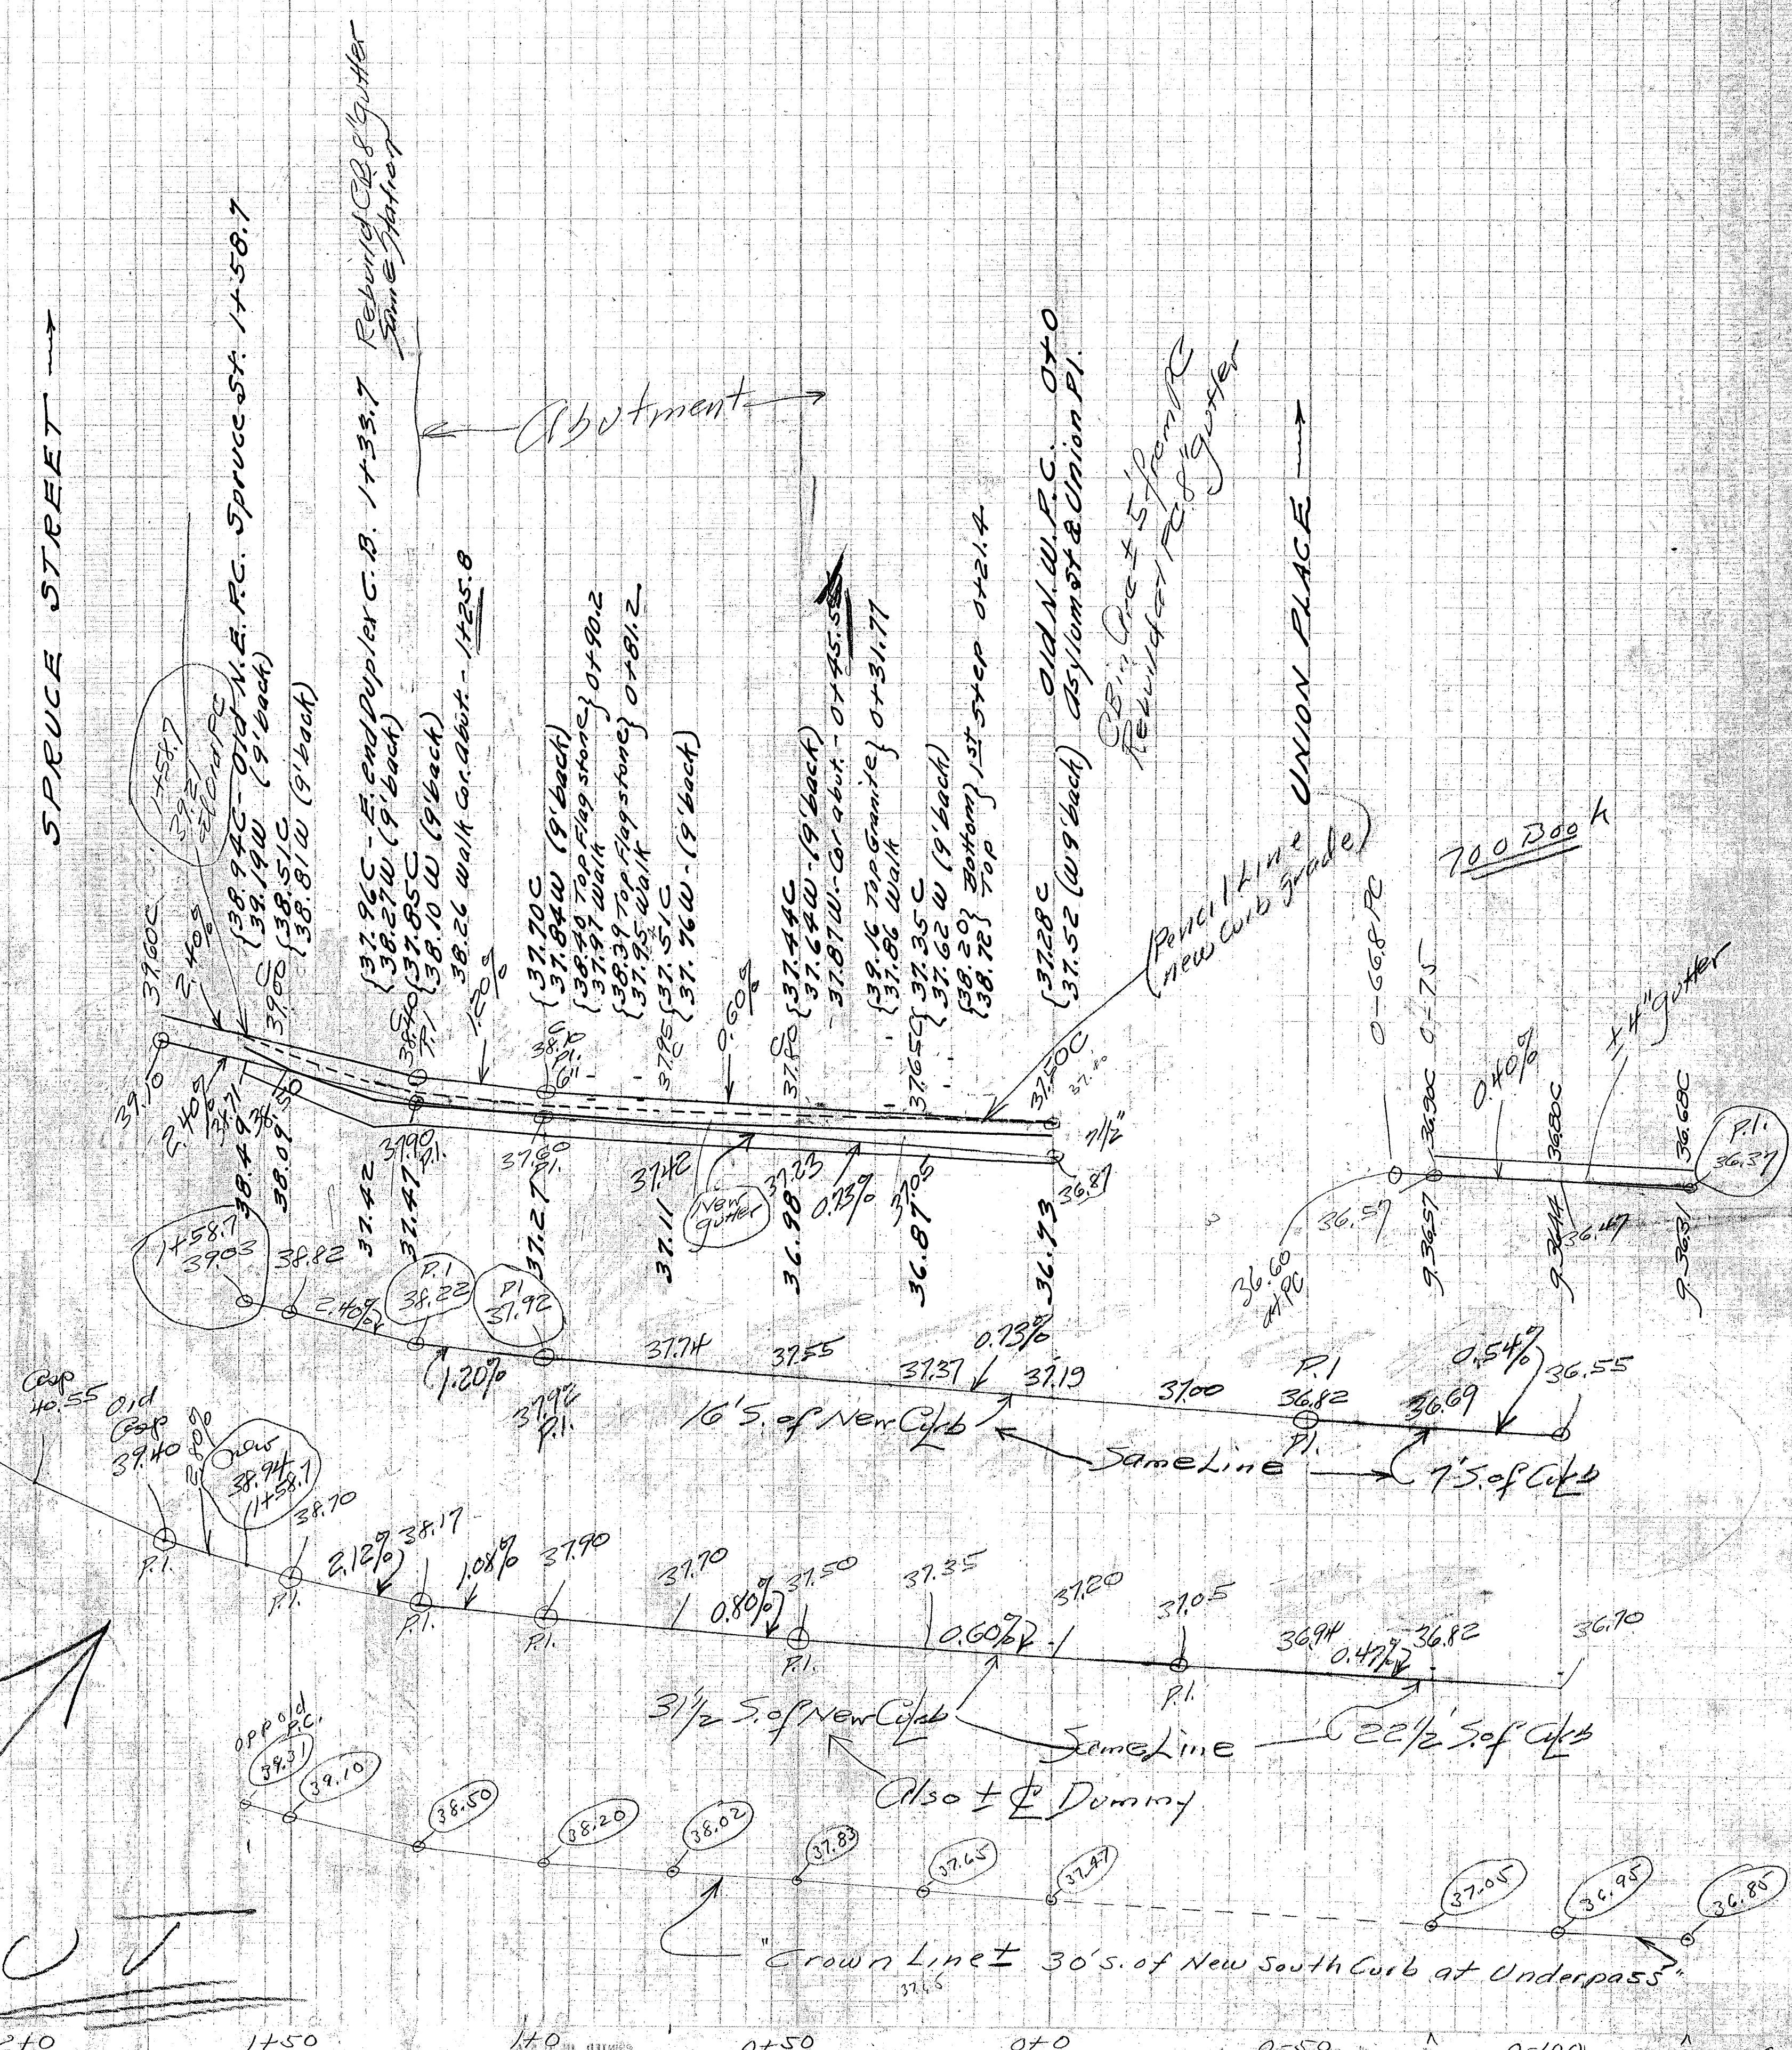


See new Plan
and Profile drawn
Jan - 1944
W.H.B.

ASYLUM STREET
UNION PLACE TO SPRUCE STREET

CURB PROFILE
HOR SCALE 1" = 10'
VER SCALE 1" = 1'

Stations measured on old North Curb and on slope.
Day Book No. Note Book # 209.

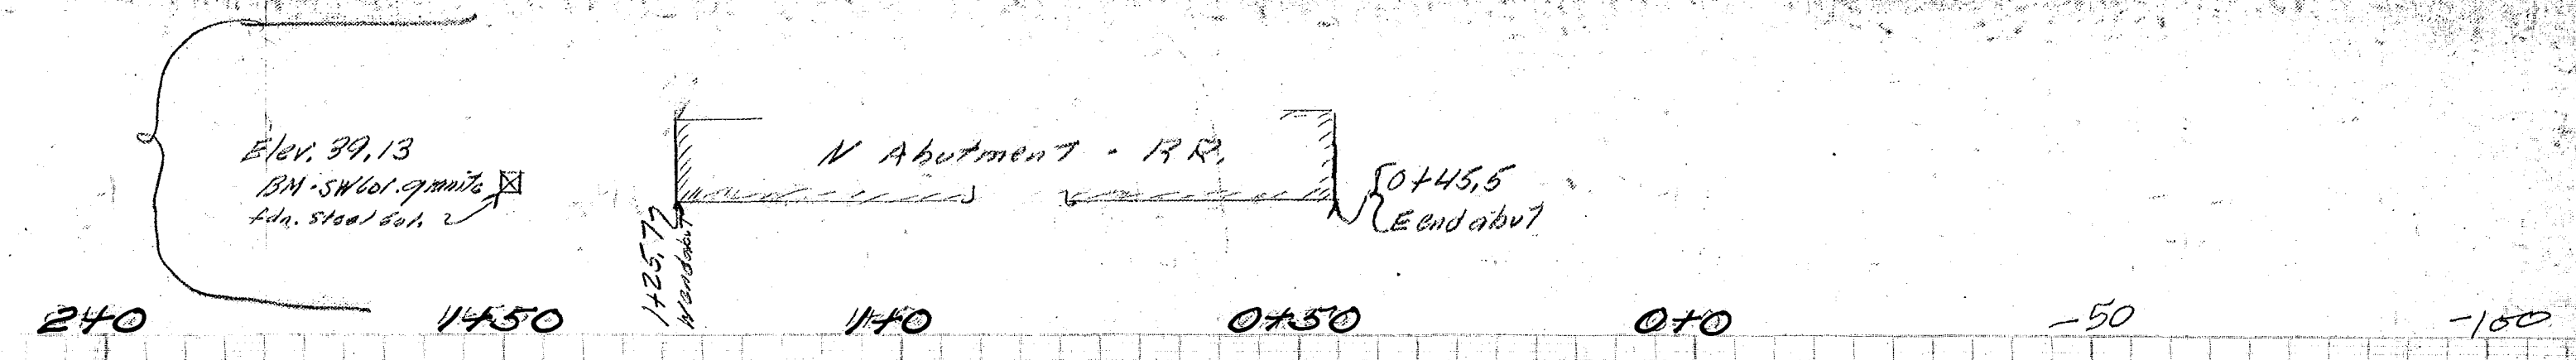

Note
See new Plan
& Profile
Drawn Jan 1944
W.H.B.

See new Plan and Profile drawn
Jan - 1944
W.H.B.