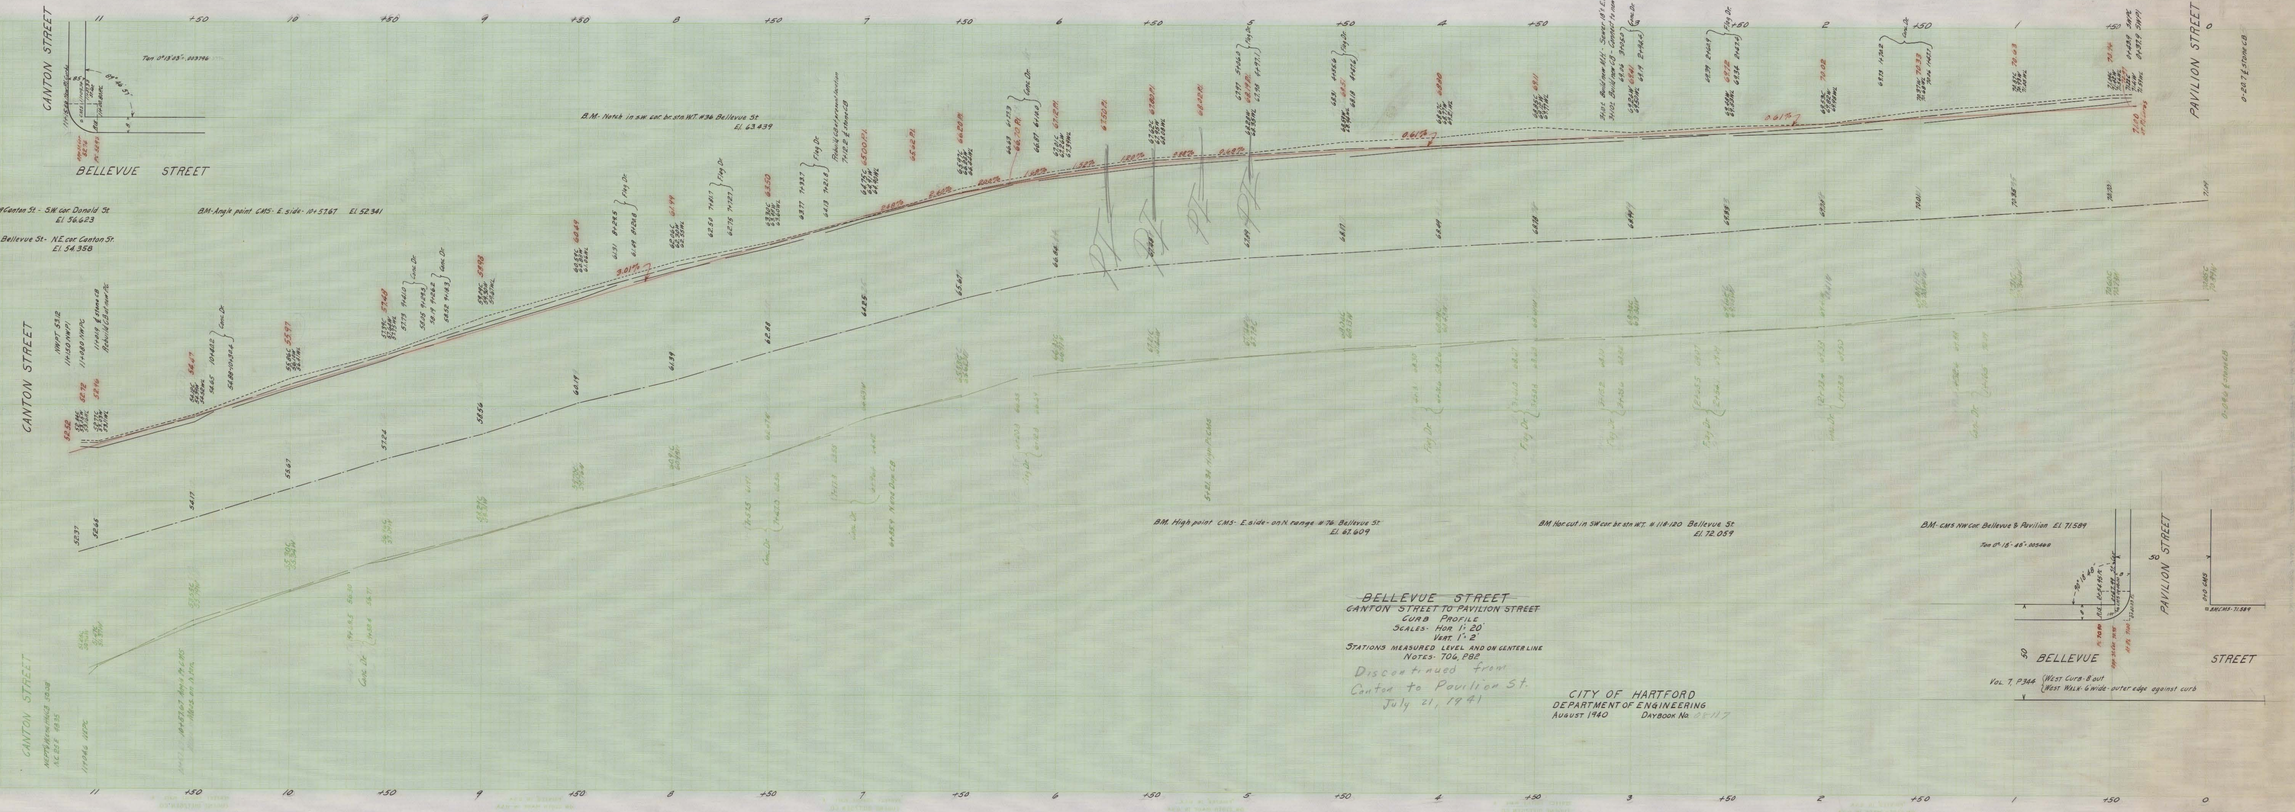
CANTON STREET
BELLEVUE STREET
PAVILION STREET
B.M.- N.W. cor. bc stn. fn. #14 Canton St. - S.W. cor. Donald St.
El. 56.623
B.M.- S.E. cor. bc stn. fn. #2 Bellevue St. - N.E. cor. Canton St.
El. 54.358
B.M.- Angle point CMS- E. side- 16+57.6T. El. 52.341
B.M.- Notch in s.w. cor. bc stn. WT. #36 Bellevue St.
El. 63.439
B.M. High point CMS- E. side- on N. range #76 Bellevue St.
El. 61.609
B.M. Hor. cut in S.W. cor. bc stn. WT. #118-120 Bellevue St.
El. 72.059
B.M.- CMS N.W. cor. Bellevue & Pavilion El. 71.589
BELLEVUE STREET
CANTON STREET TO PAVILION STREET
CURB PROFILE
SCALES- HOR. 1" = 20'
VERT. 1" = 2'
STATIONS MEASURED LEVEL AND ON CENTER LINE
NOTES- 704 PDF
Discontinued from
Canton to Pavilion St.
July 21, 1941
CITY OF HARTFORD
DEPARTMENT OF ENGINEERING
AUGUST 1940
DAYBOOK No.
Vol. 7 P.346
West Curb & out
West Walk 6 wide - outer edge against curb