


LINE 11/17

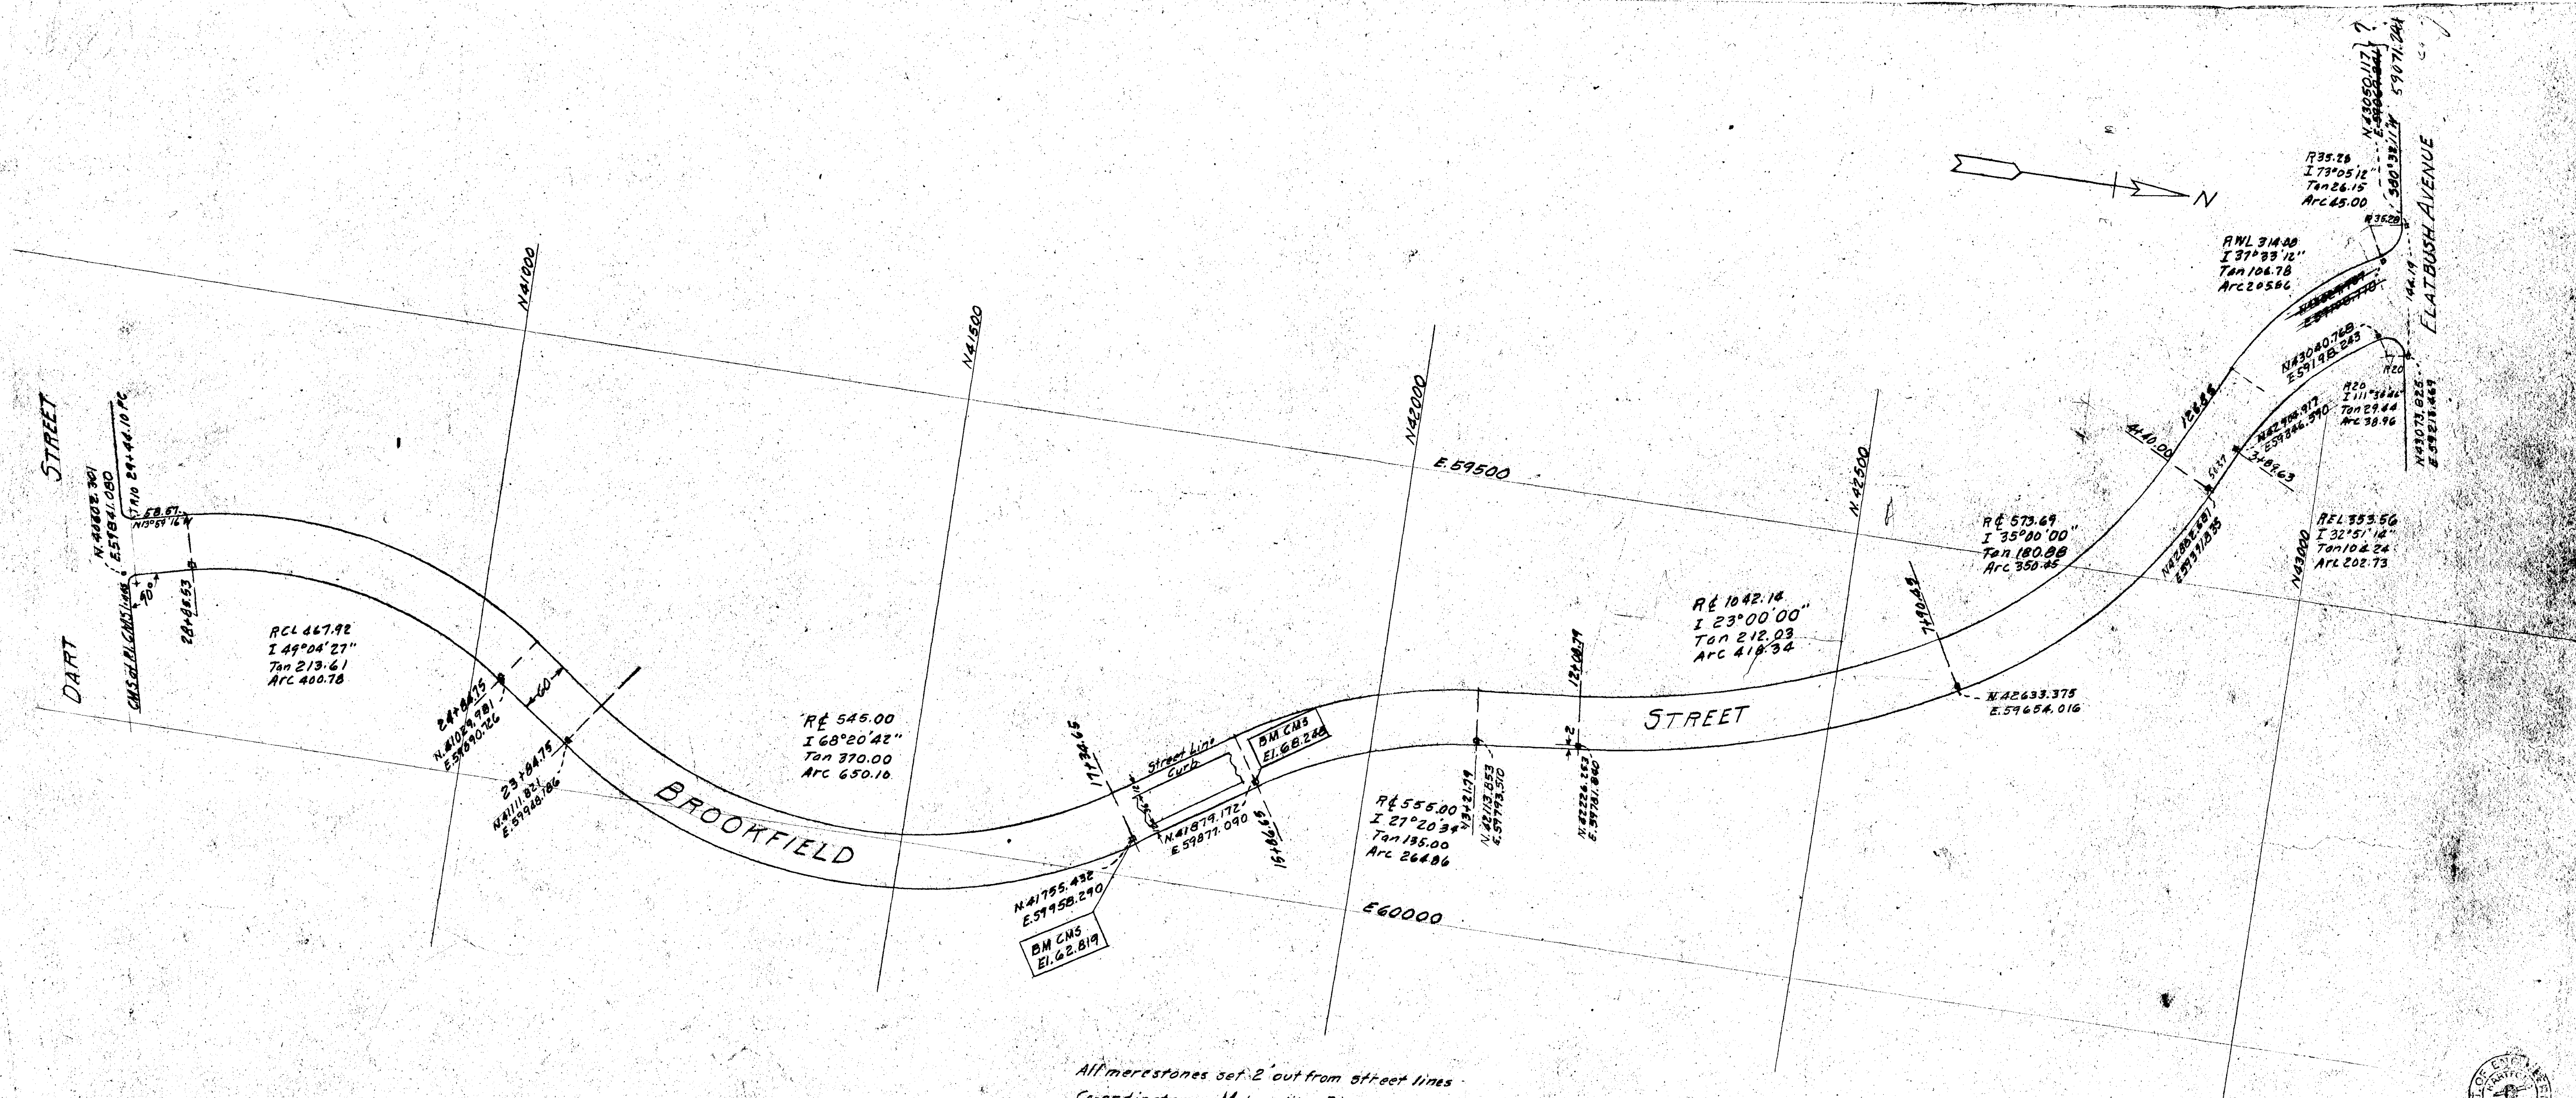

All merestones set 2' out from street lines
Co-ordinates on Metropolitan District system

Scale 1"=100'
November 1962

