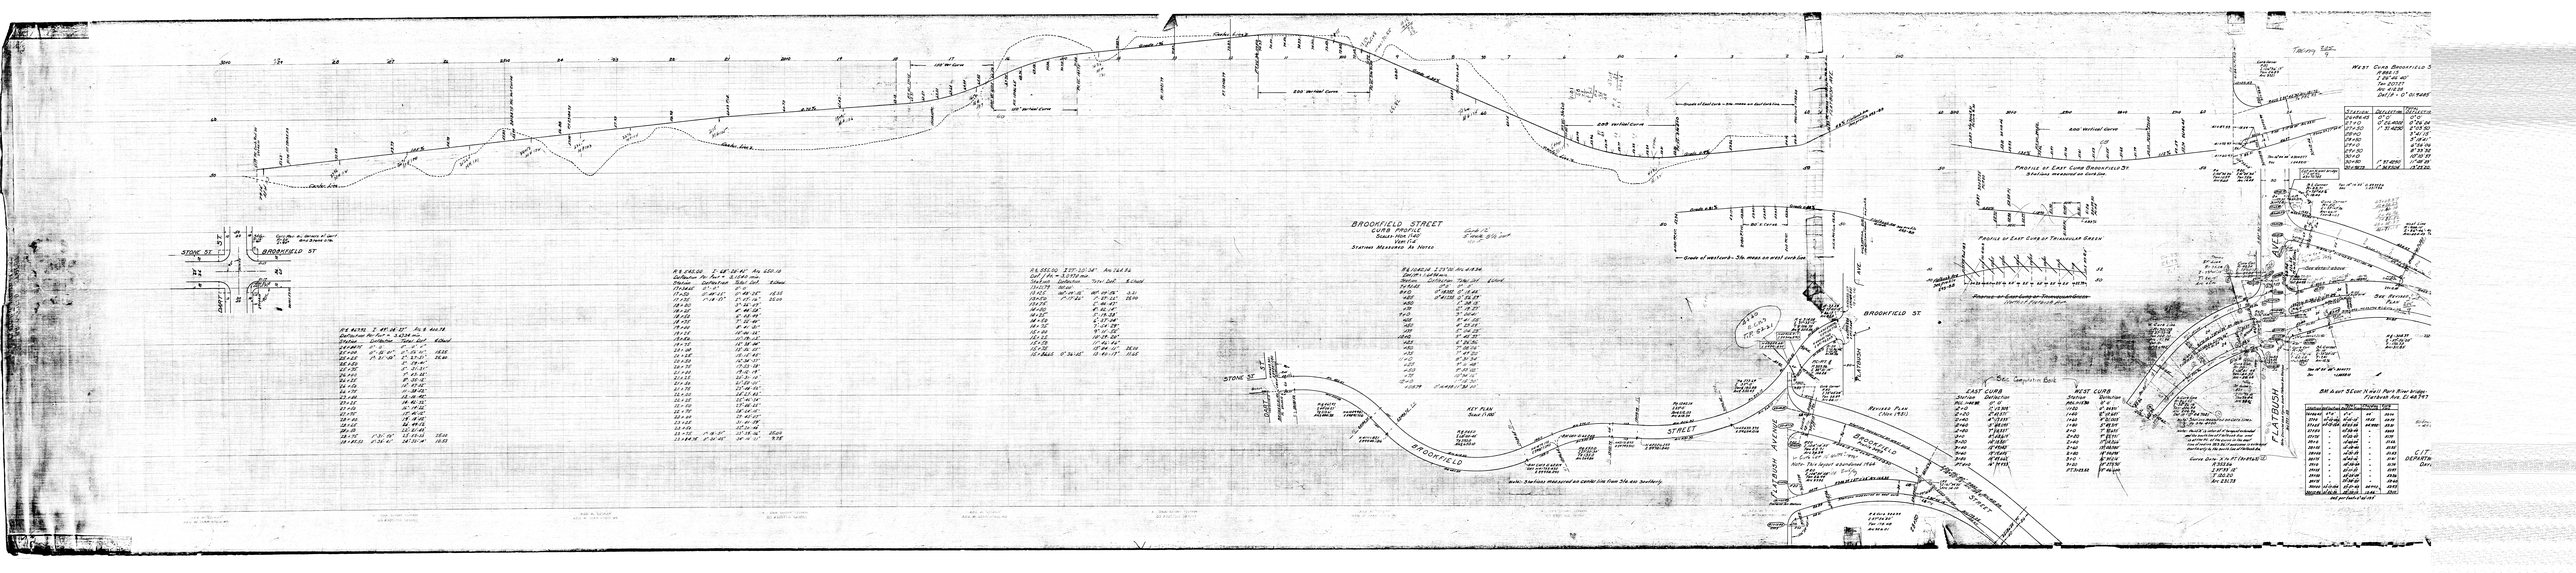
BROOKFIELD STREET
CURB PROFILE
Scale: Hor. 1"=40'
Vert. 1"=4'
Stations Measured In Horiz.
Profile of East Curb Brookfield St
Profile of East Curb of Triangular Green
Brookfield St
Stone St
Flatbush Avenue
Brookfield Street
Key Plan
Revised Plan (Nov. 1930)
Note: This layout abandoned 1940
Bm 6 on E Curb 11 feet N of N Pier Bridge Flatbush Ave. El 46.797
Tracing 227-9
West Curb Brookfield St
Sec. Completion Book
East Curb
West Curb
Station
Deflection
Tang. Bear.
Curve Data
Elevations
Grade of East Curb = 0.4% means an East Curb Fall
Grade of West Curb = 5% means an West Curb Fall
Grade of West Curb = 5% means an West Curb Rise
Curb Lines measured on Center line from Stn. 6+00 Southerly.
