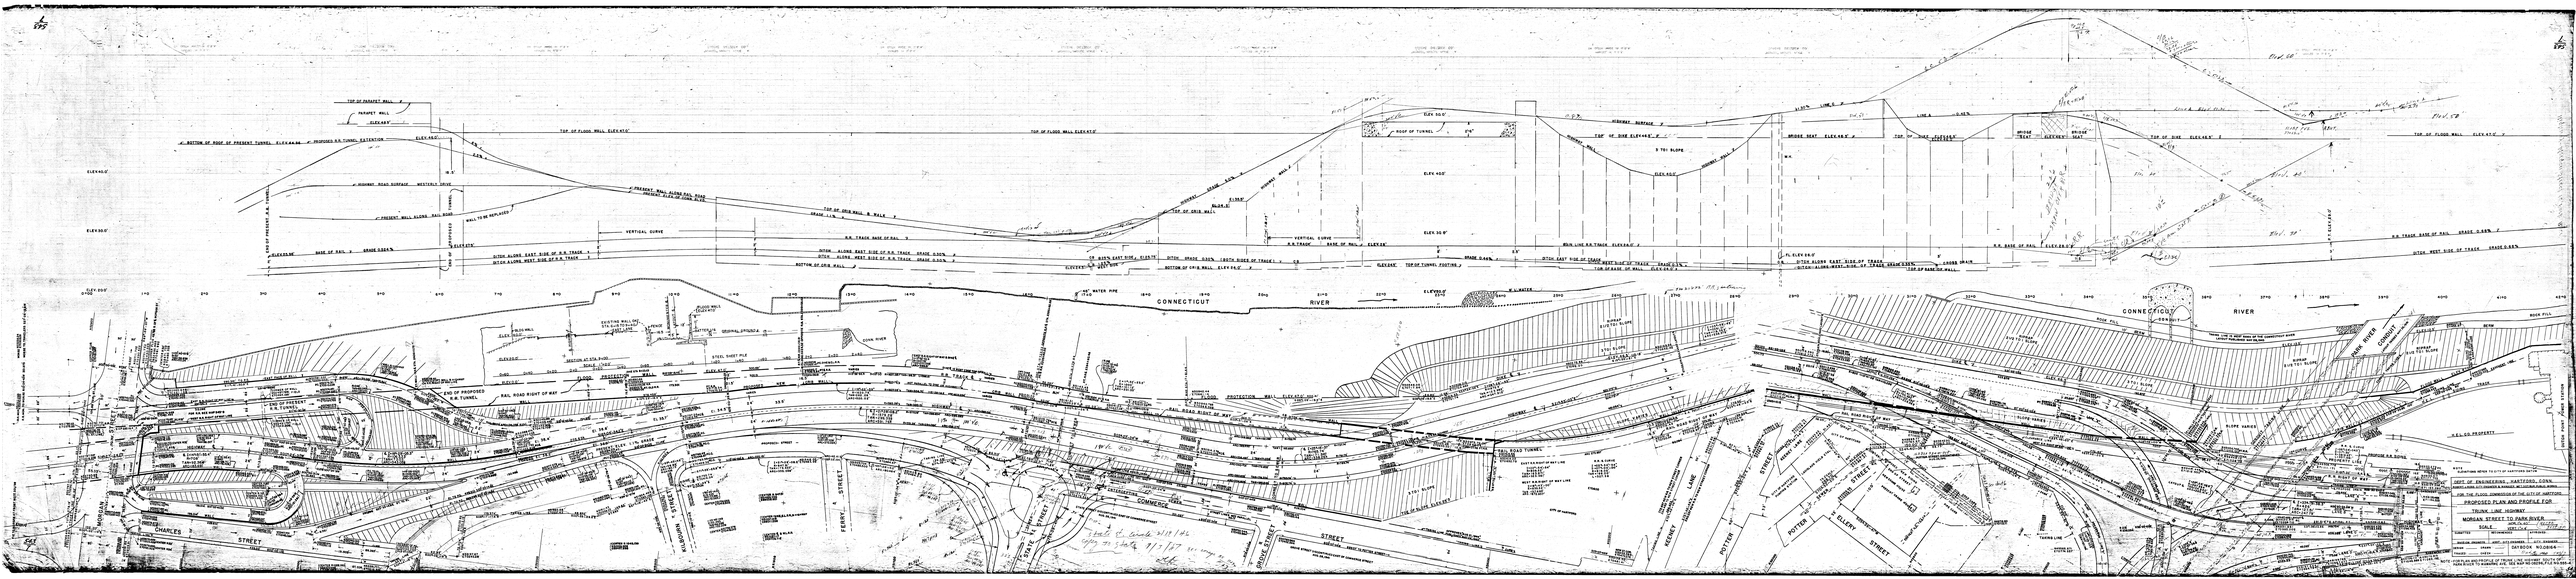
CONNECTICUT RIVER
CONNECTICUT RIVER
PARK RIVER
CHARLES STREET
FERRY STREET
ELLERY STREET
PROPOSED PLAN AND PROFILE FOR
TRUNK LINE HIGHWAY
MORGAN STREET TO PARK RIVER
DEPT. OF ENGINEERING - HARTFORD, CONN.
FOR THE FLOOD COMMISSION OF THE CITY OF HARTFORD
DATEBOOK NO. 2064