


2/2

2/2

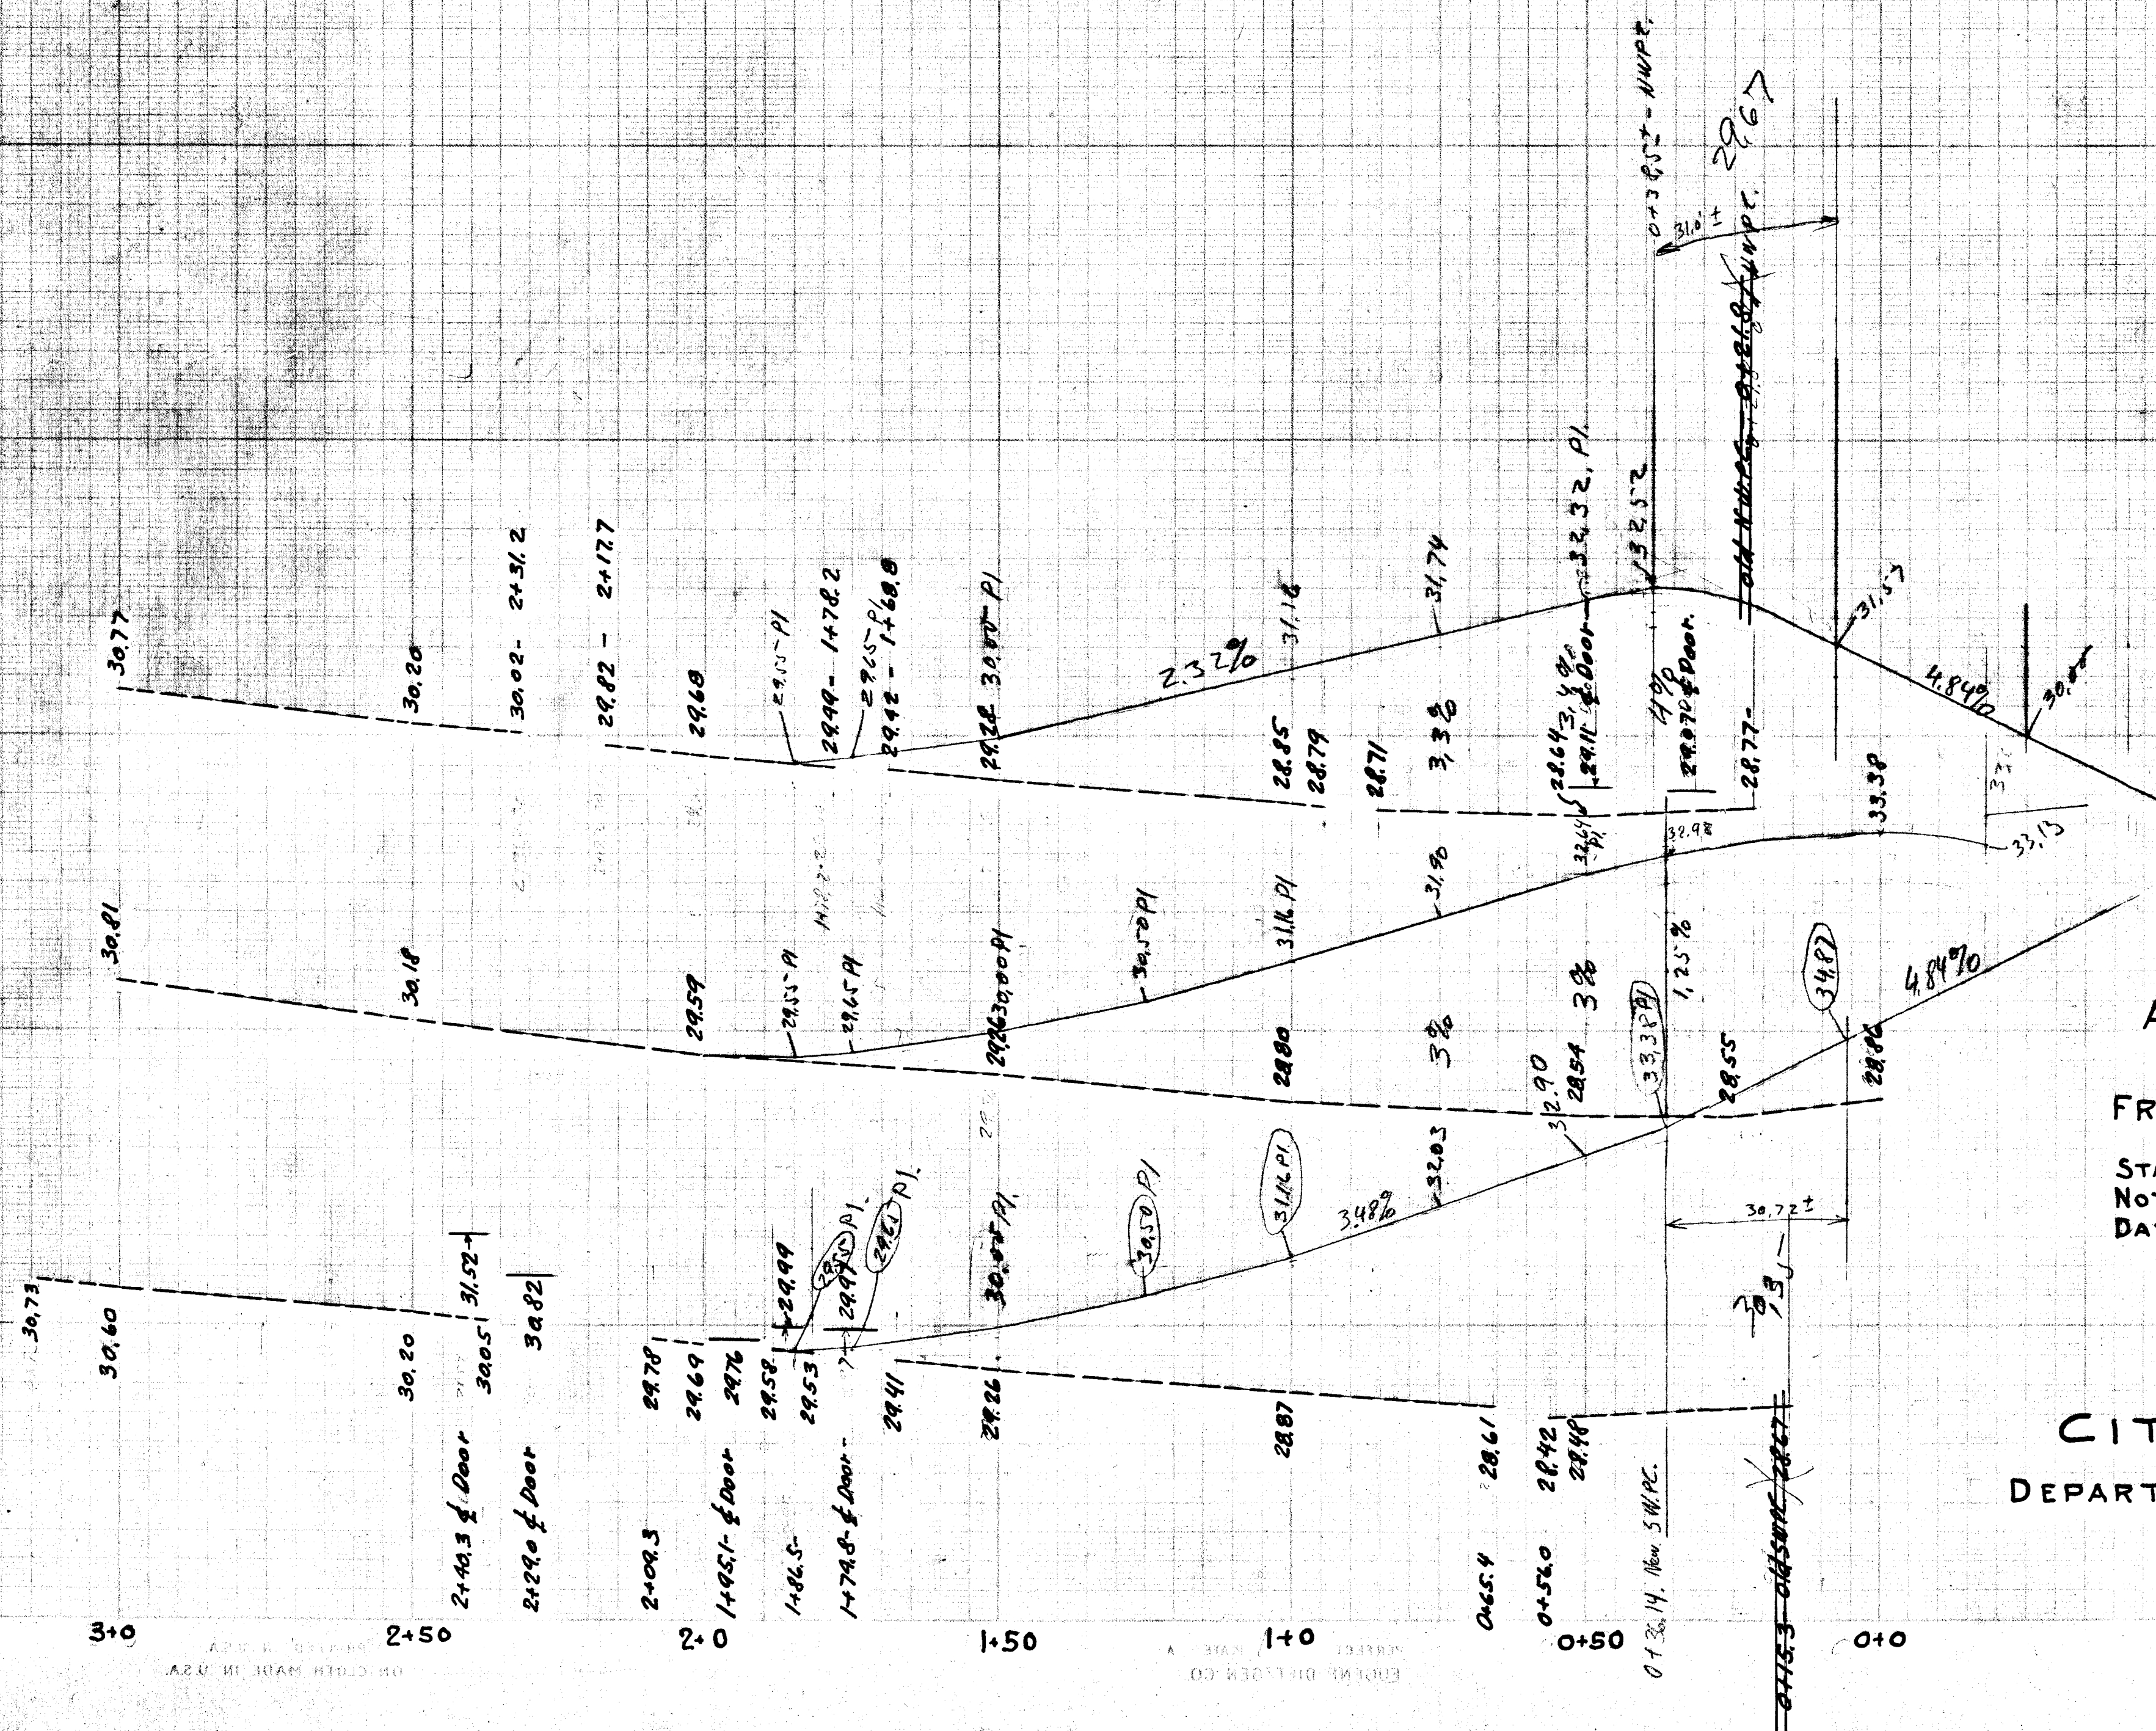

ARCH STREET
CURB PROFILE
FRONT STREET WEST 300'
STATIONS MEASURED LEVEL AND ON E.
NOTE BOOK NO. 708
DAY BOOK NO. 08162.

CITY OF HARTFORD
DEPARTMENT OF ENGINEERING
DECEMBER 1940.

FRONT STREET WEST 300'
CURB PROFILE
ARCH STREET

2/2

2/2