


875
574

Housing Authority of the City of Hartford

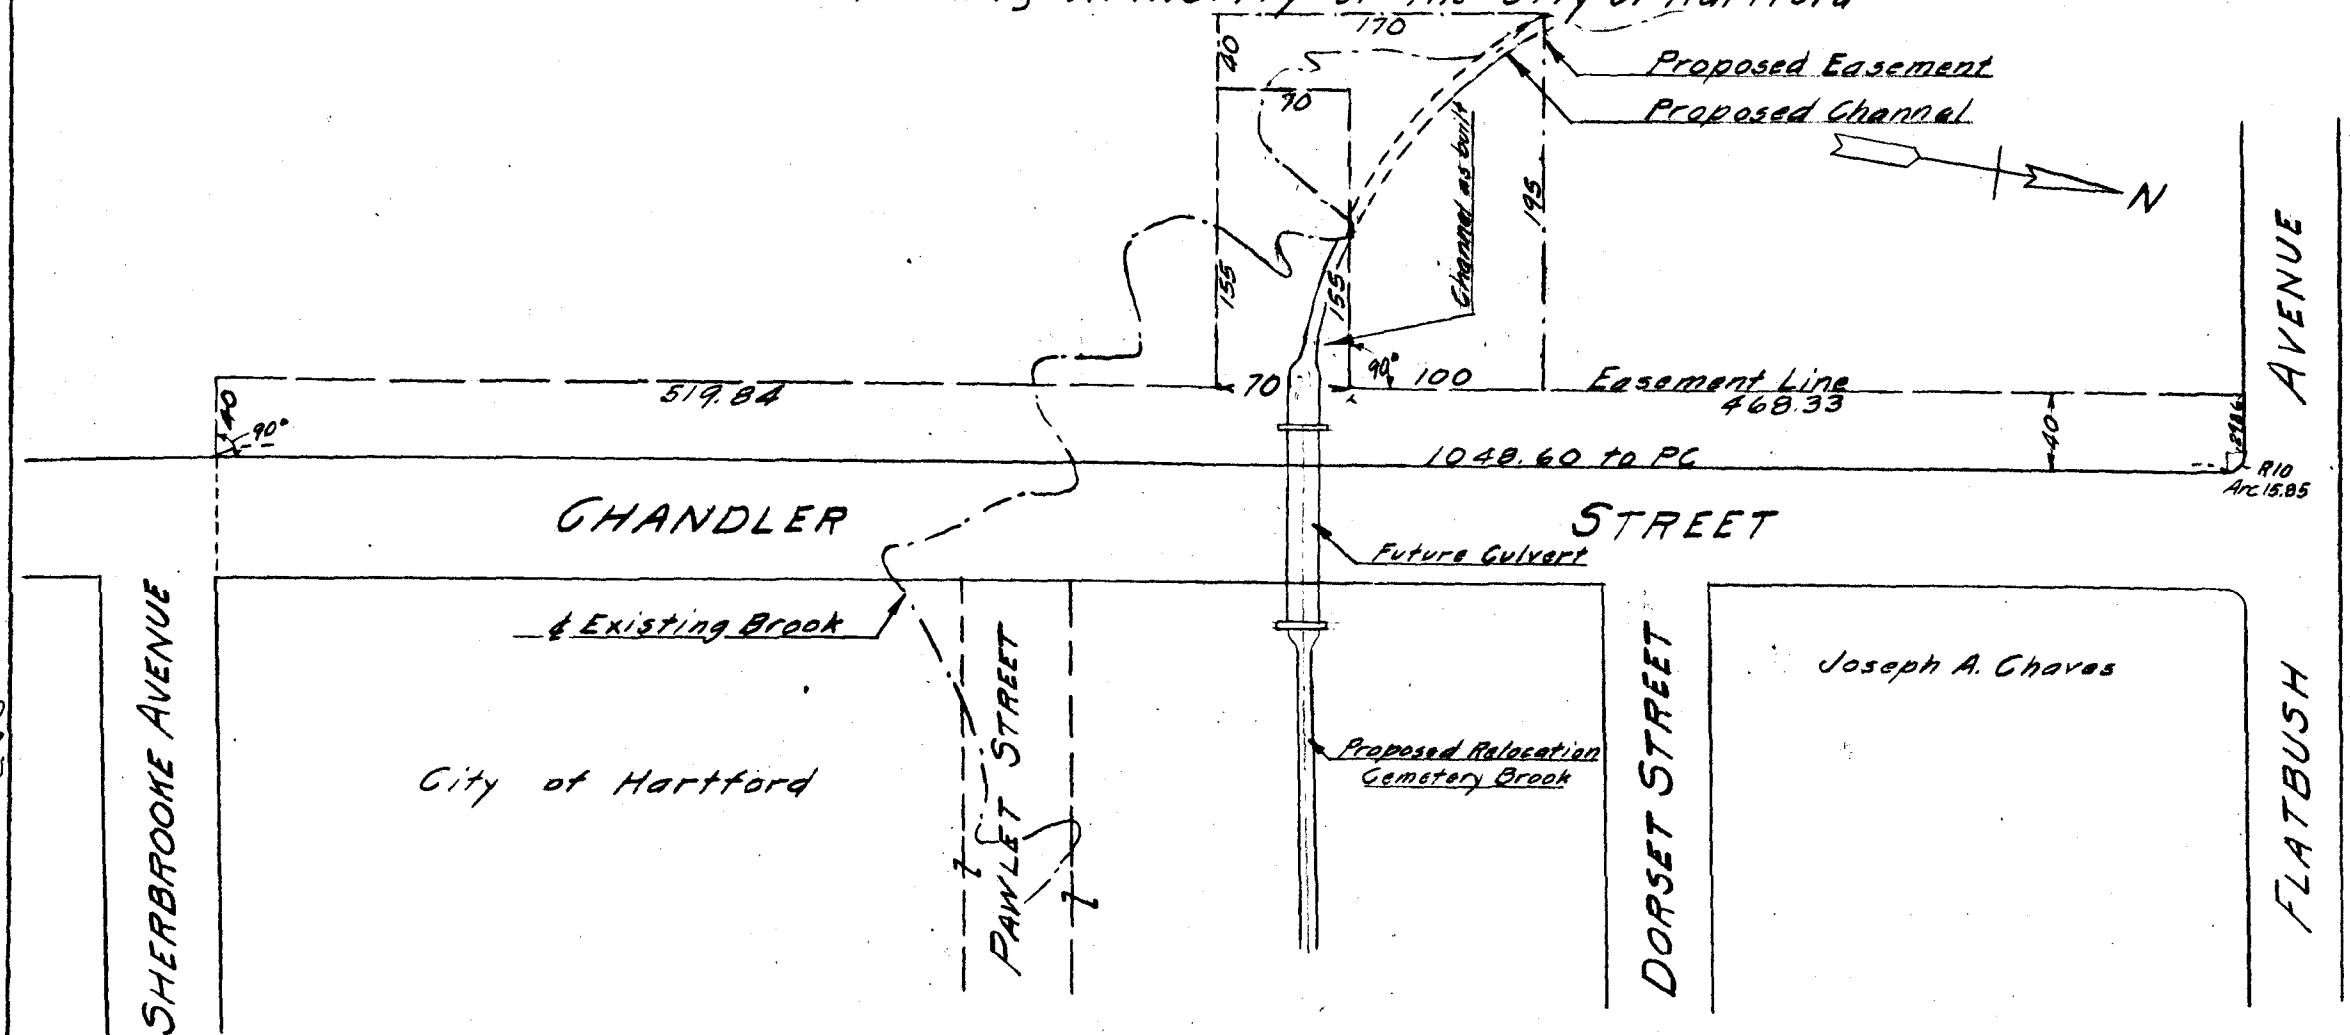

PROPOSED EASEMENT LINE
WEST OF CHANDLER STREET

Revision of December 20, 1950
Proposed easement and proposed
channel added

CITY OF HARTFORD
DEPARTMENT OF ENGINEERING
SCALE - 1"=100' JANUARY 1950

13
242

242
13