


Dec. 5, 1957

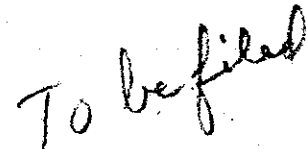

call 9893 Parul (A)

Mark 9892 ¹⁰ sold on 9893

for money Pt. 4903 & Pt. 9892

4903 & 4892 pt. sold see 9823

R. Wilson
SUPERVISOR OF SURVEYS
NY. NH & H RR Co.

**DEPARTMENT OF
ENGINEERING**

DAYBOOK No. 09527

NEW YORK NEW HAVEN & HARTFORD RAILROAD
OFFICE OF ENGINEER - REAL ESTATE SURVEYS
LAND IN HARTFORD, CONN.
TO BE CONVEYED TO
SUISMAN & BLUMENTHAL, INCORPORATED
SCALE: 1 INCH = 100 FEET
OCT. 1977