


See Vol. 1002/468
Dec. 5, 1957

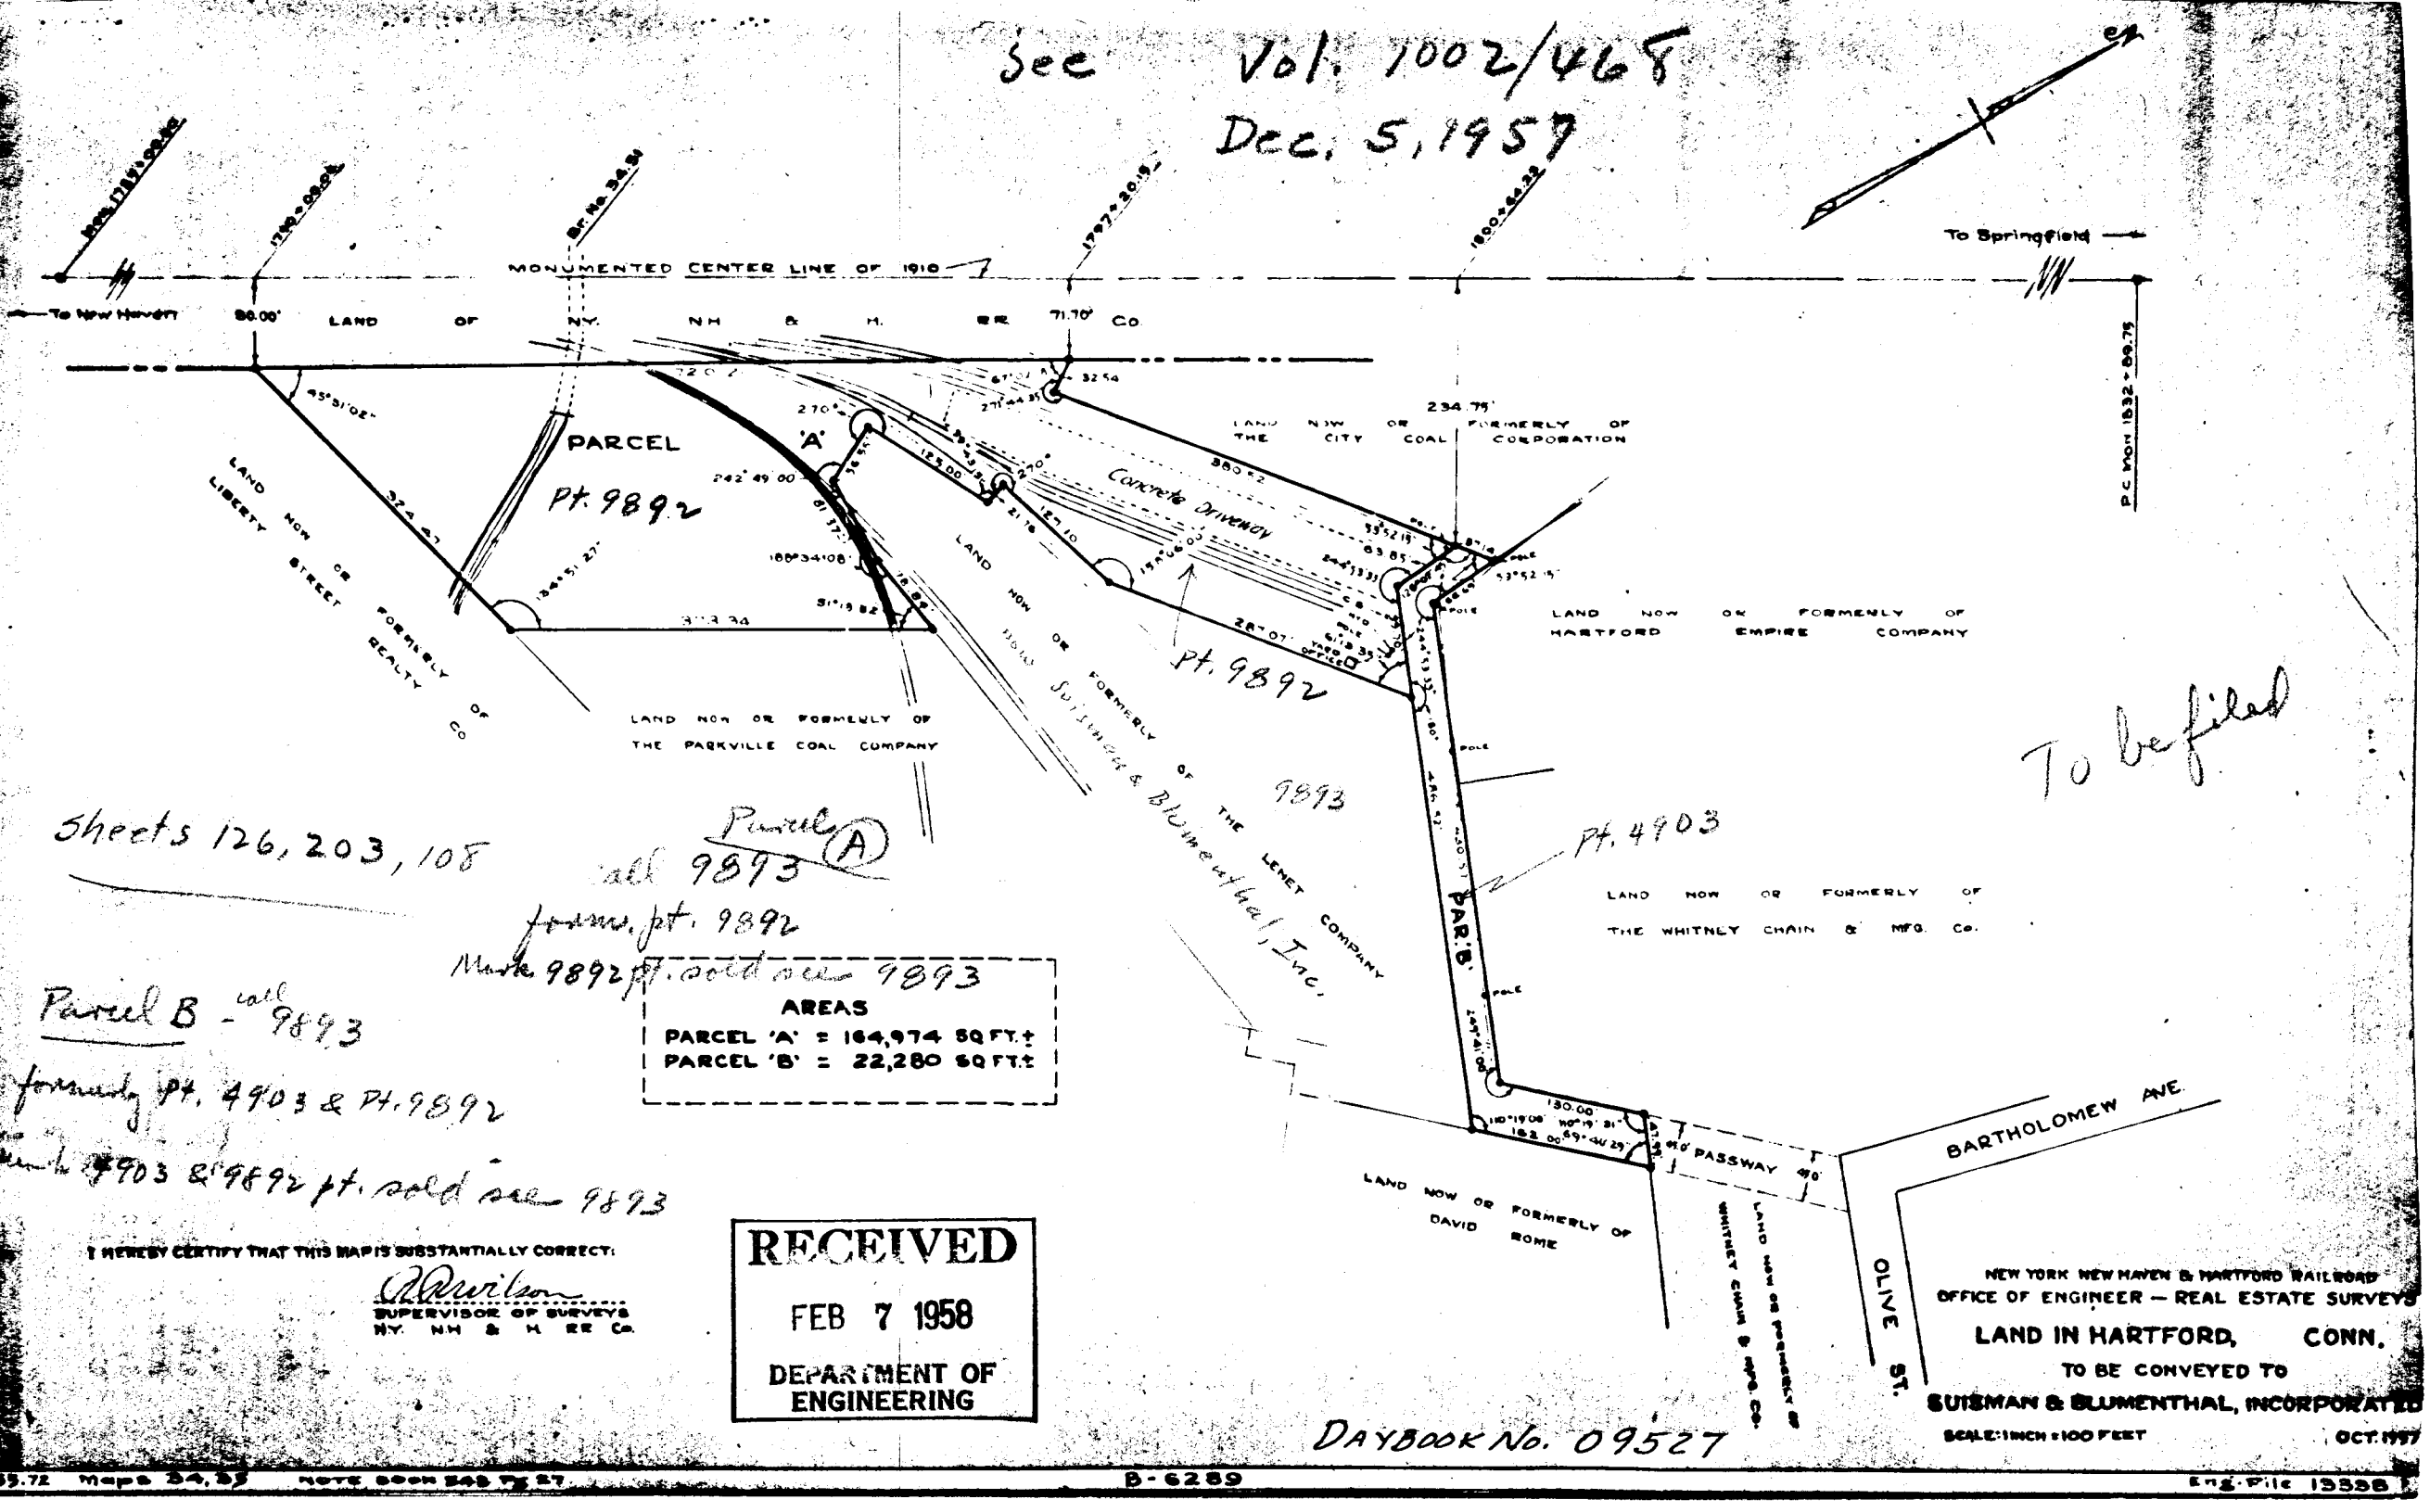

Sheets 126, 203, 108

Parcel B - 9893

formerly Pt. 4903 & Pt. 9892

now Pt. 9893 & 9892 pt. sold see 9893

Parcel A
call 9893

formerly pt. 9892

now 9892 pt. sold see 9893

AREAS
PARCEL 'A' = 164,974 SQ. FT.
PARCEL 'B' = 22,280 SQ. FT.

RECEIVED
FEB 7 1958
DEPARTMENT OF
ENGINEERING

Wilson
SUPERVISOR OF SURVEYS
NY, NH & H. RR CO.

NEW YORK NEW HAVEN & HARTFORD RAILROAD
OFFICE OF ENGINEER - REAL ESTATE SURVEYS
LAND IN HARTFORD, CONN.
TO BE CONVEYED TO
SUTSMAN & BLUMENTHAL, INCORPORATED
SCALE: 1" = 100 FEET
OCT. 1957

DAYBOOK No. 09527