
THE METROPOLITAN DISTRICT

BUREAU OF PUBLIC WORKS

SEWER STANDARDS SHEET P

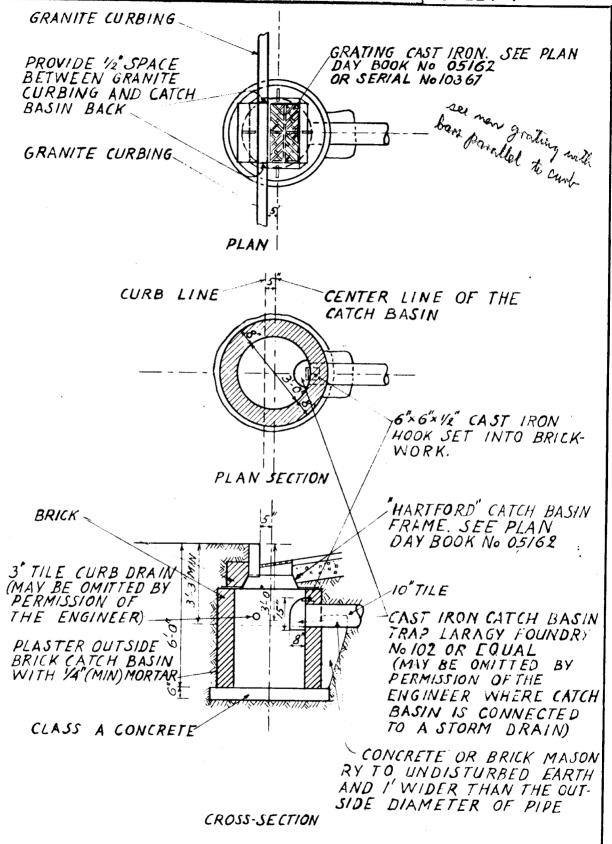

STANDARD CATCH BASIN DETAILS

SCALE: /= 4'