

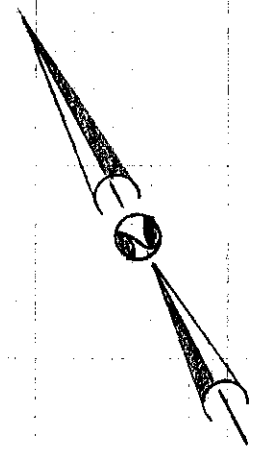


549/33

549/33

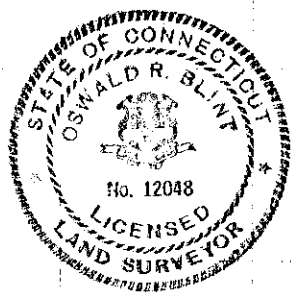

BEDFORD ST.

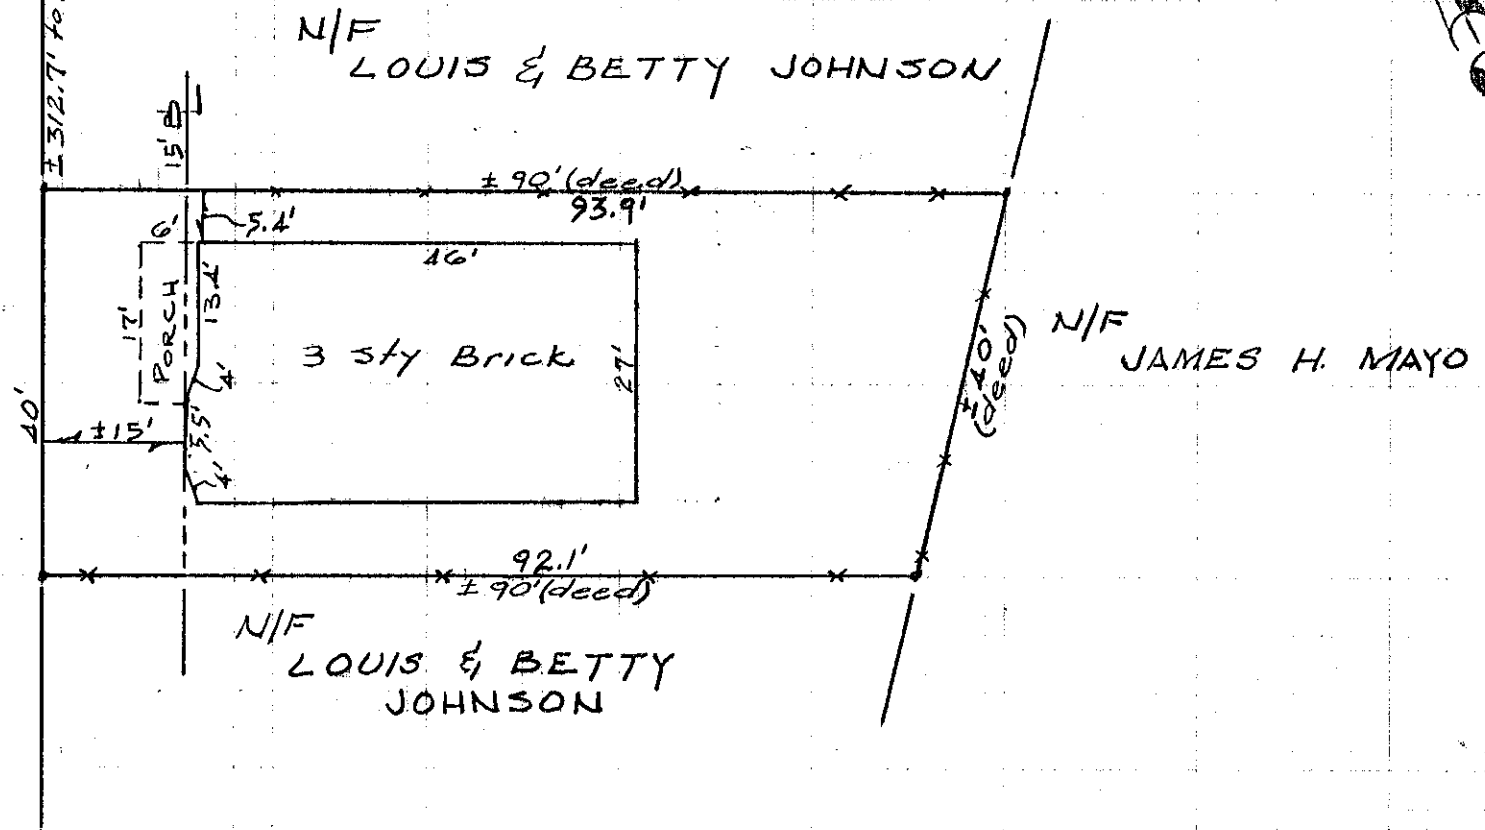

I hereby certify that this map and survey were prepared in accordance with the standards of a Class B survey as defined in the Code of Practice for Standards of Accuracy of Surveys and Maps, adopted December 10, 1975, as amended by the Connecticut Association of Land Surveyors, Inc.

DAYB

549/33

CITY OF HARTFORD, CONNECTICUT DEPARTMENT OF PUBLIC WORKS BUREAU OF ENGINEERING SERVICES		
PLAN OF 40-42 BEDFORD ST. HARTFORD, CONNECTICUT.		
DRAWN <u>OB</u> APPR. _____	SCALE 1" = 40'	DAYBOOK NO. 077029 DATE 3. 26. 86.

549/33