


549/34

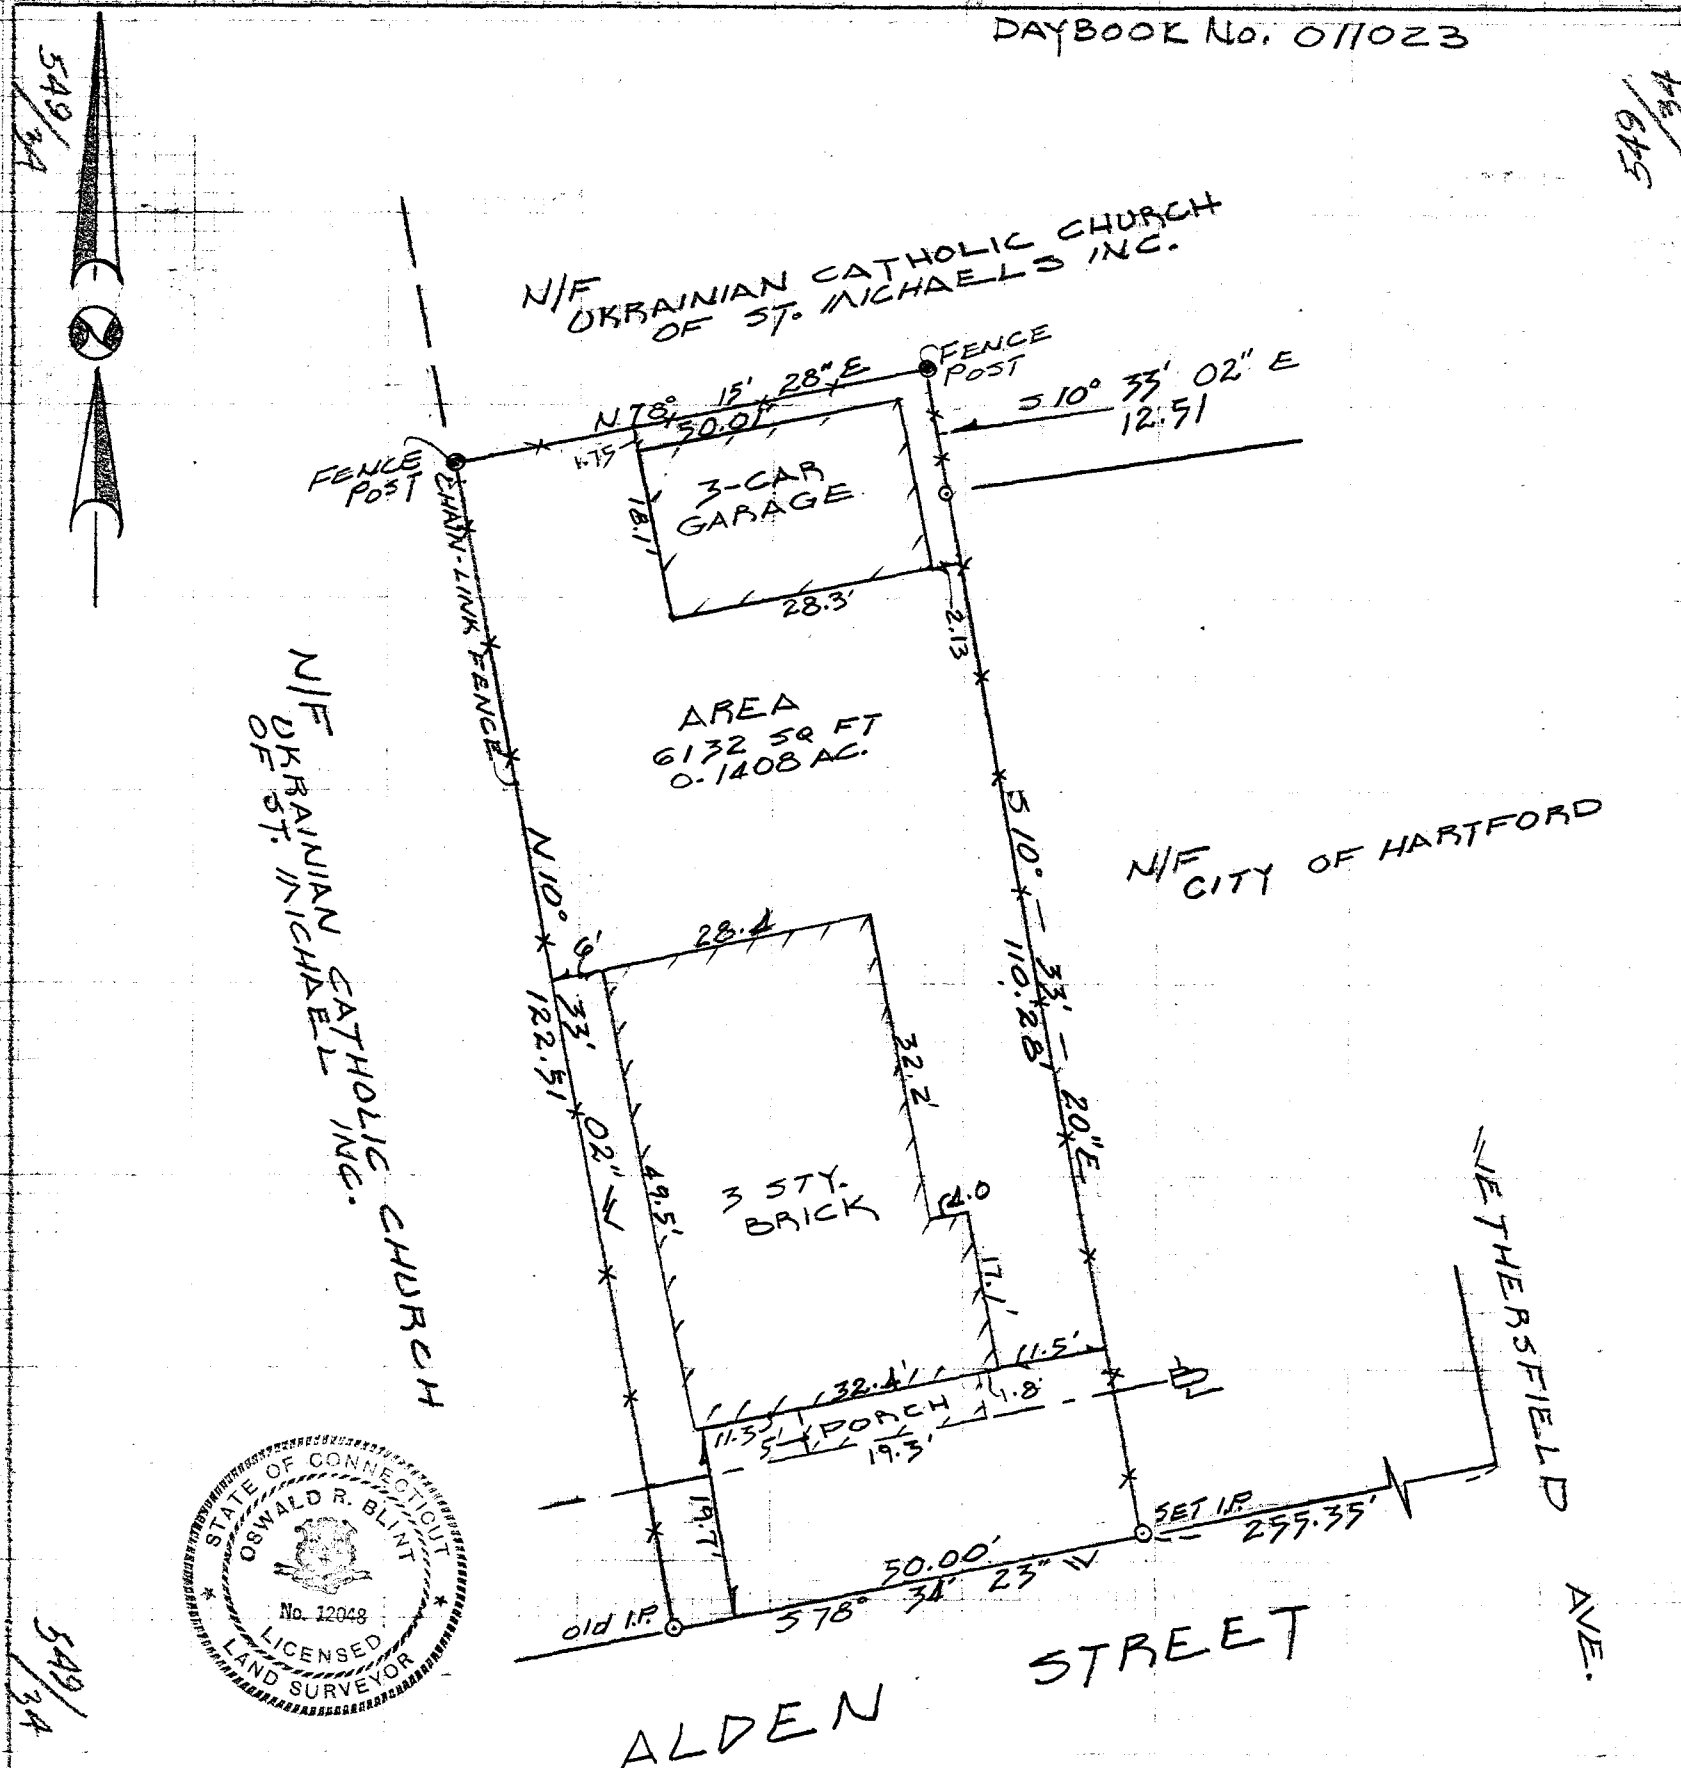

NOTE:

REFERENCE IS HEREBY MADE TO A MAP ENTITLED "CITY OF HARTFORD, CONN. DEPT. OF PUBLIC WORKS, BUREAU OF ENGRG. SERVICES PROPERTY MAP, BLOCKS BOUNDED BY FRANKLIN AVE., MAPLE AVE., WYLLYS ST., WETHERSFIELD AVE. & ANNAPAN ST. CHARTER OAK-SOUTH GREEN SECT. 1 PROJECT HARTFORD, CT. 1"=60', JULY 1977 MICHAEL SCENTI, L.S.

PLOT PLAN
PROPERTY KNOWN AS
24 ALDEN ST.
HARTFORD, CONN.
SCALE: 1"=20'
DATE: JAN. 10, 1985

CERTIFIED SUBSTANTIALLY
CORRECT. *O. Blint*

549/34

549/34