


omit

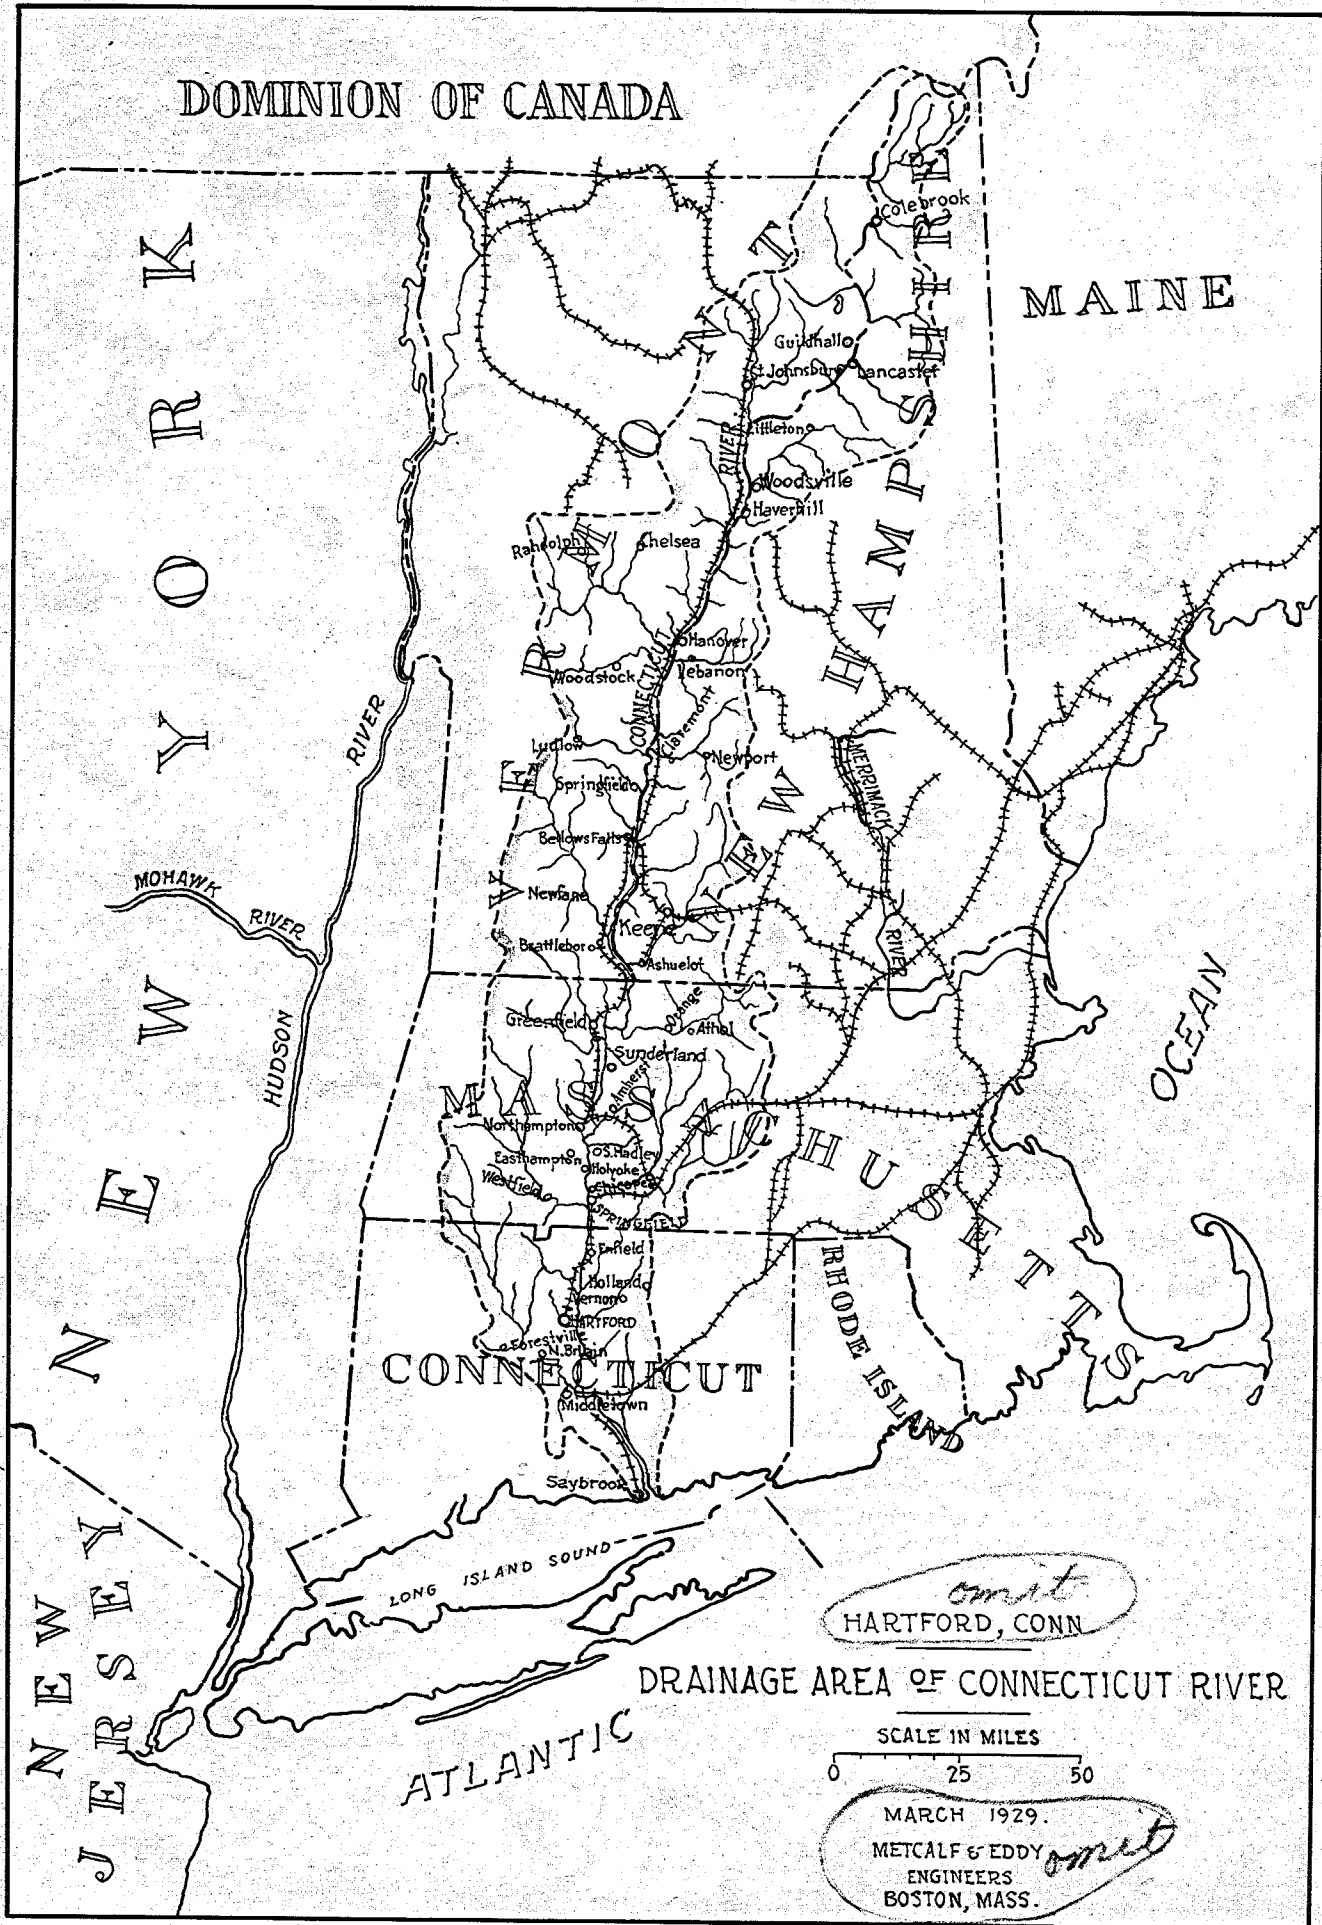

Drainage Area

omit
HARTFORD, CONN

MARCH 1929.
METCALF & EDDY
ENGINEERS
BOSTON, MASS.
omit

Make 4 1/2 in.