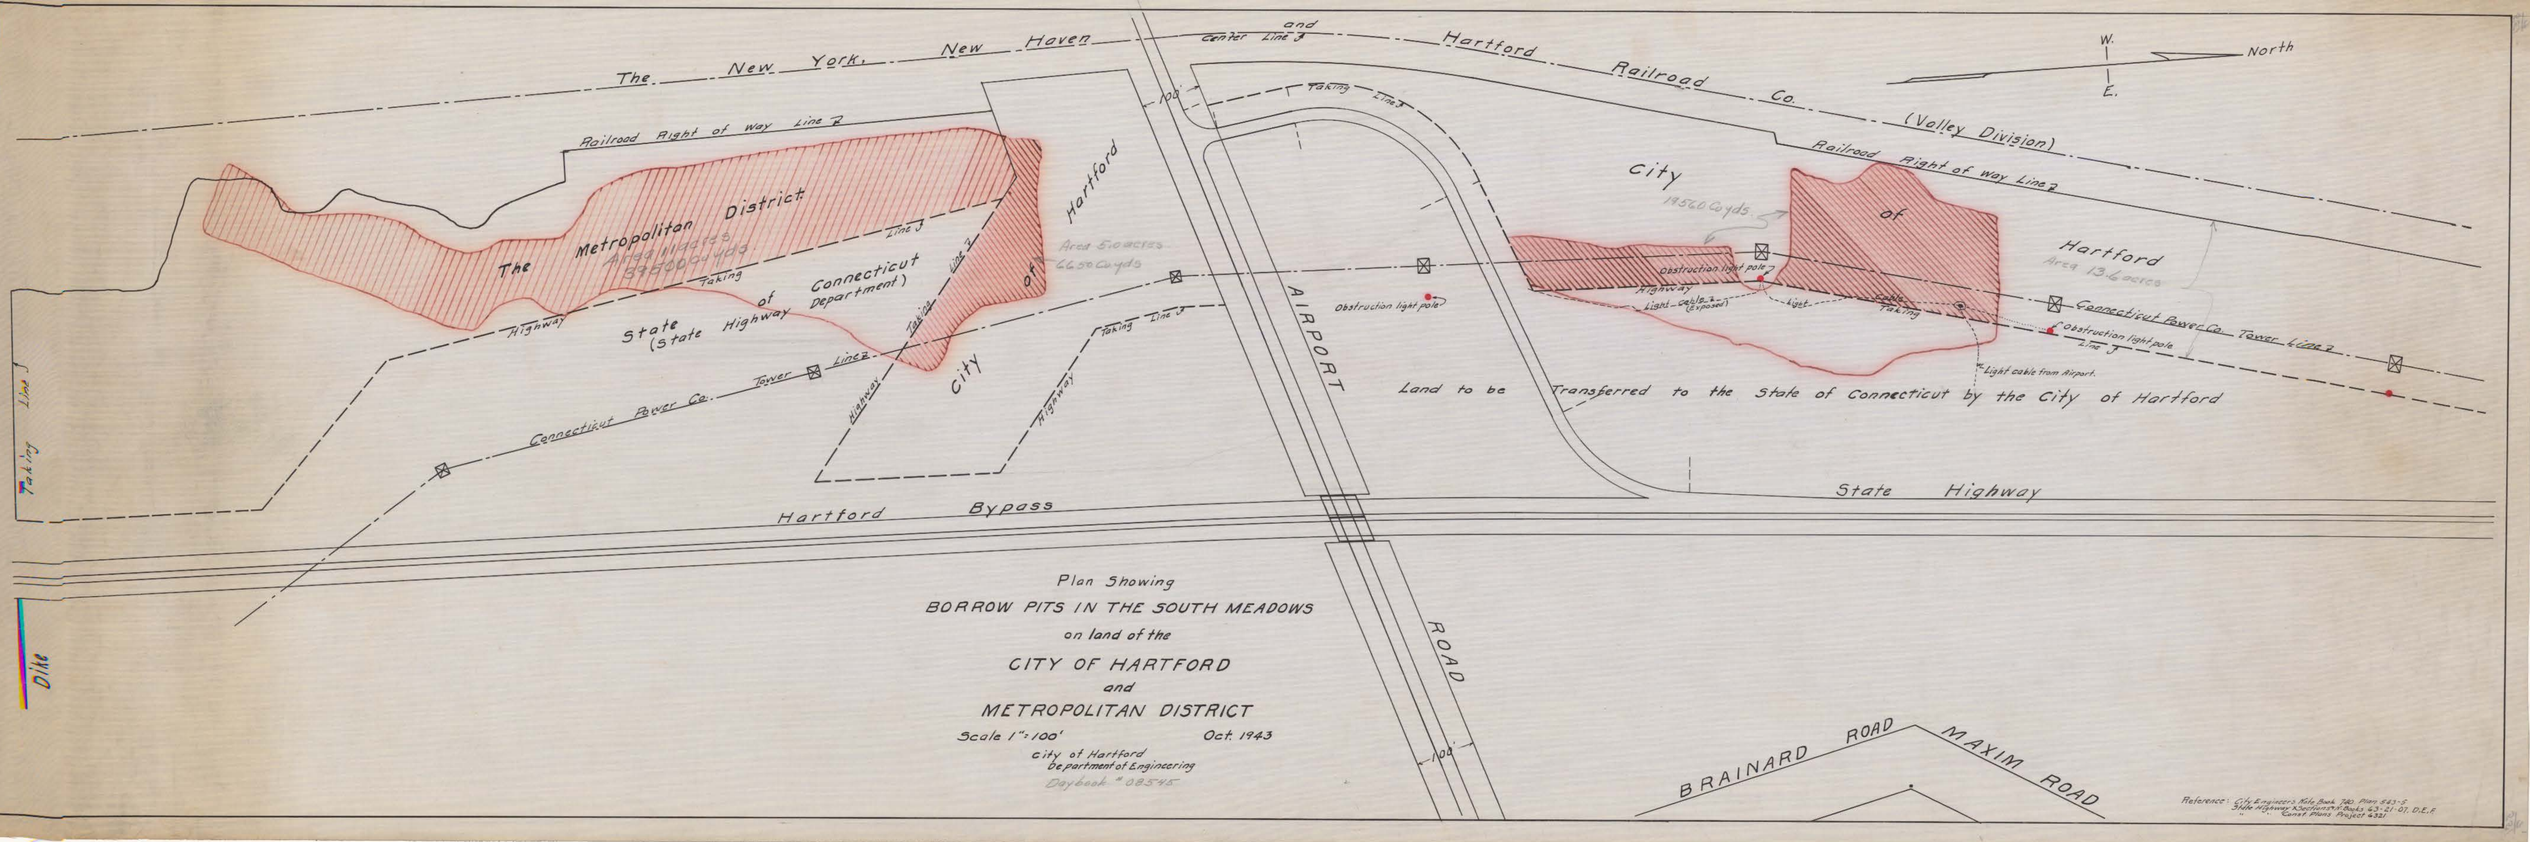

Plan Showing

BORROW PITS IN THE SOUTH MEADOWS

on land of the

CITY OF HARTFORD

and

METROPOLITAN DISTRICT

Scale 1" = 100' Oct. 1943

City of Hartford
Department of Engineering
Daybook # 08545