


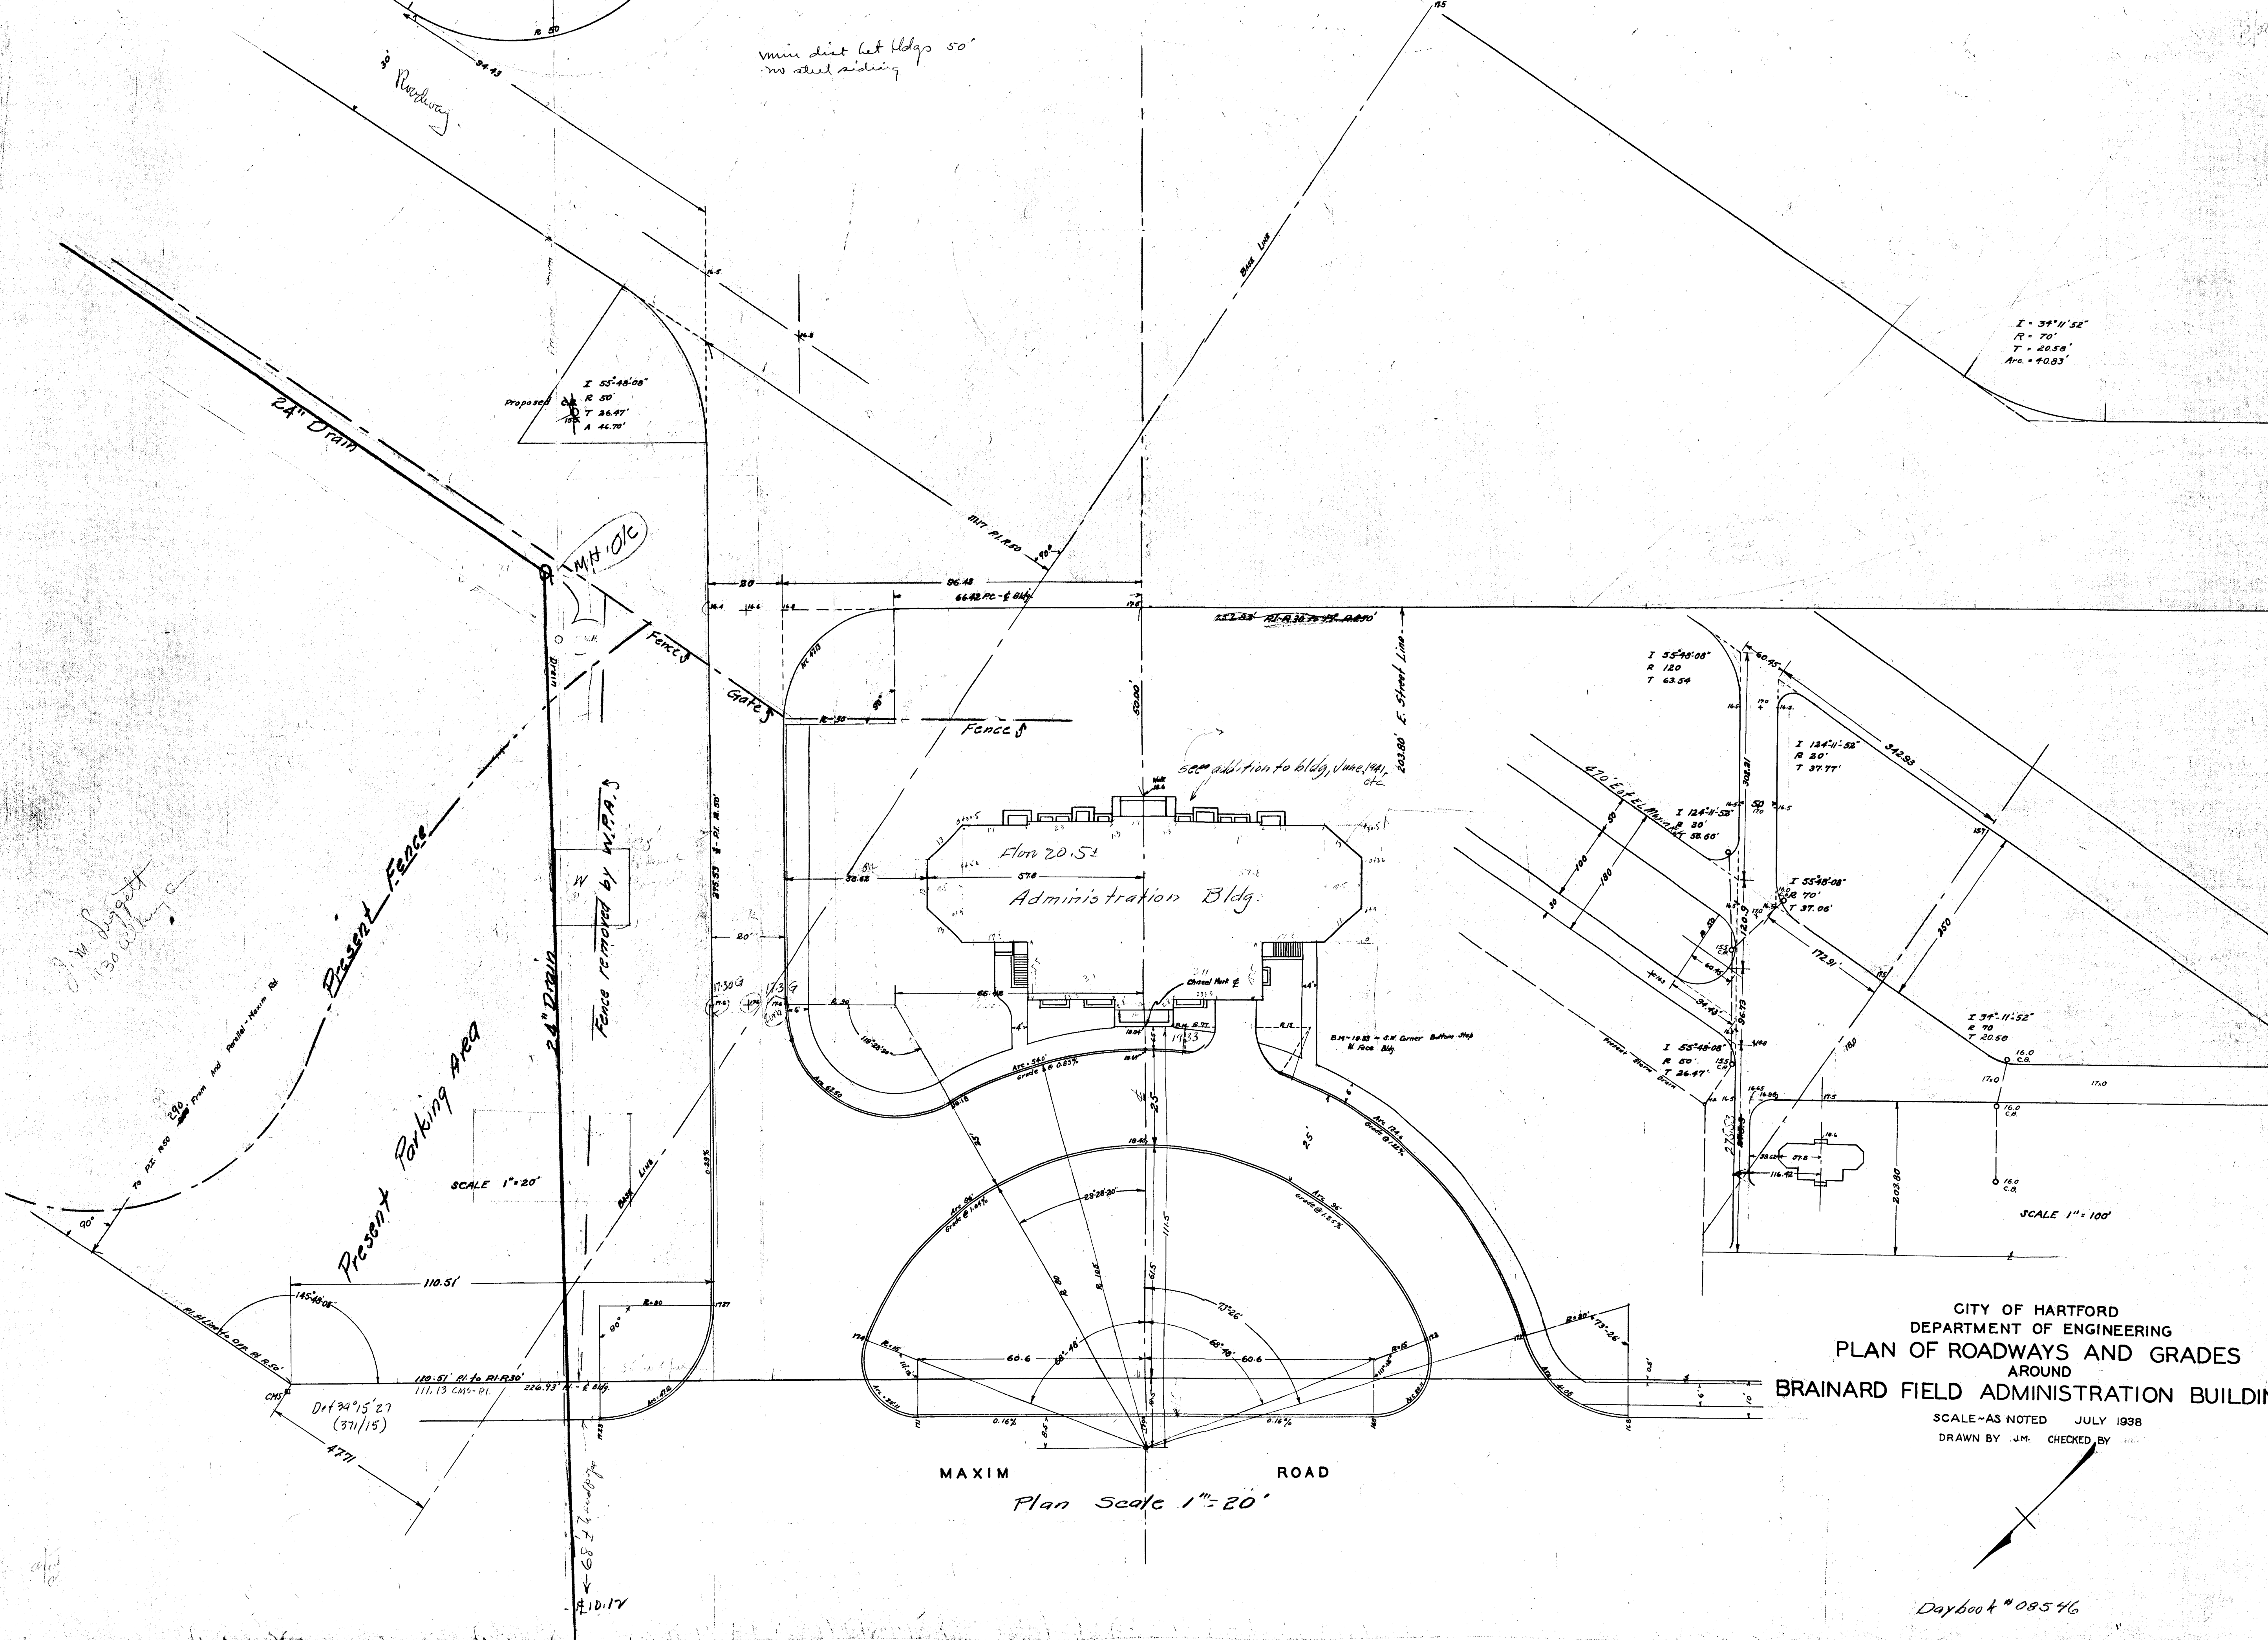

CITY OF HARTFORD
DEPARTMENT OF ENGINEERING
PLAN OF ROADWAYS AND GRADES
AROUND
BRAINARD FIELD ADMINISTRATION BUILDING

SCALE - AS NOTED JULY 1938
DRAWN BY J.M. CHECKED BY

Daybook #08546