

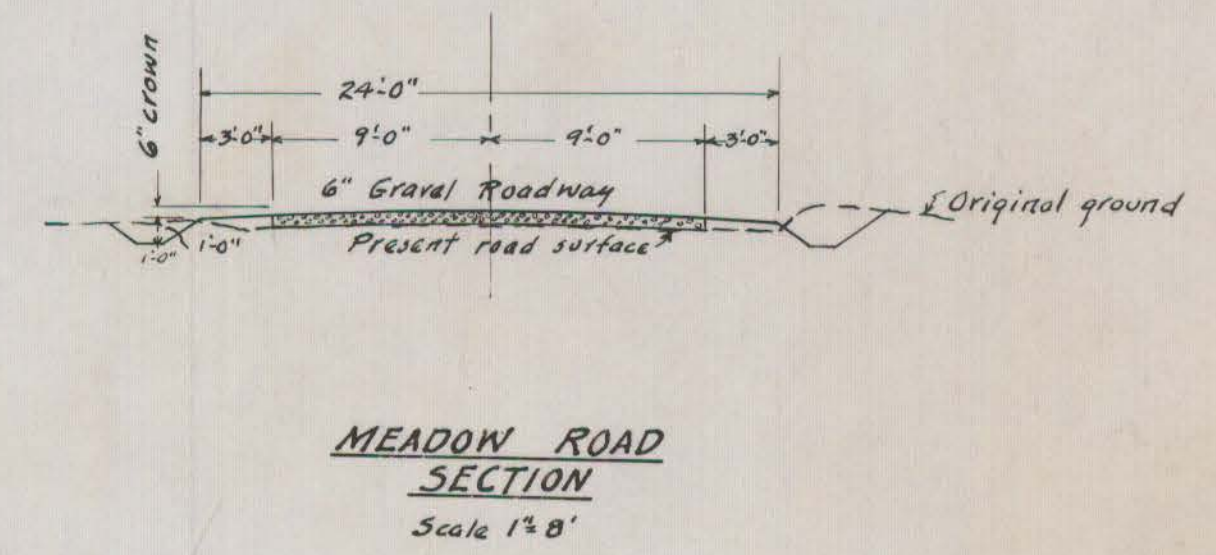
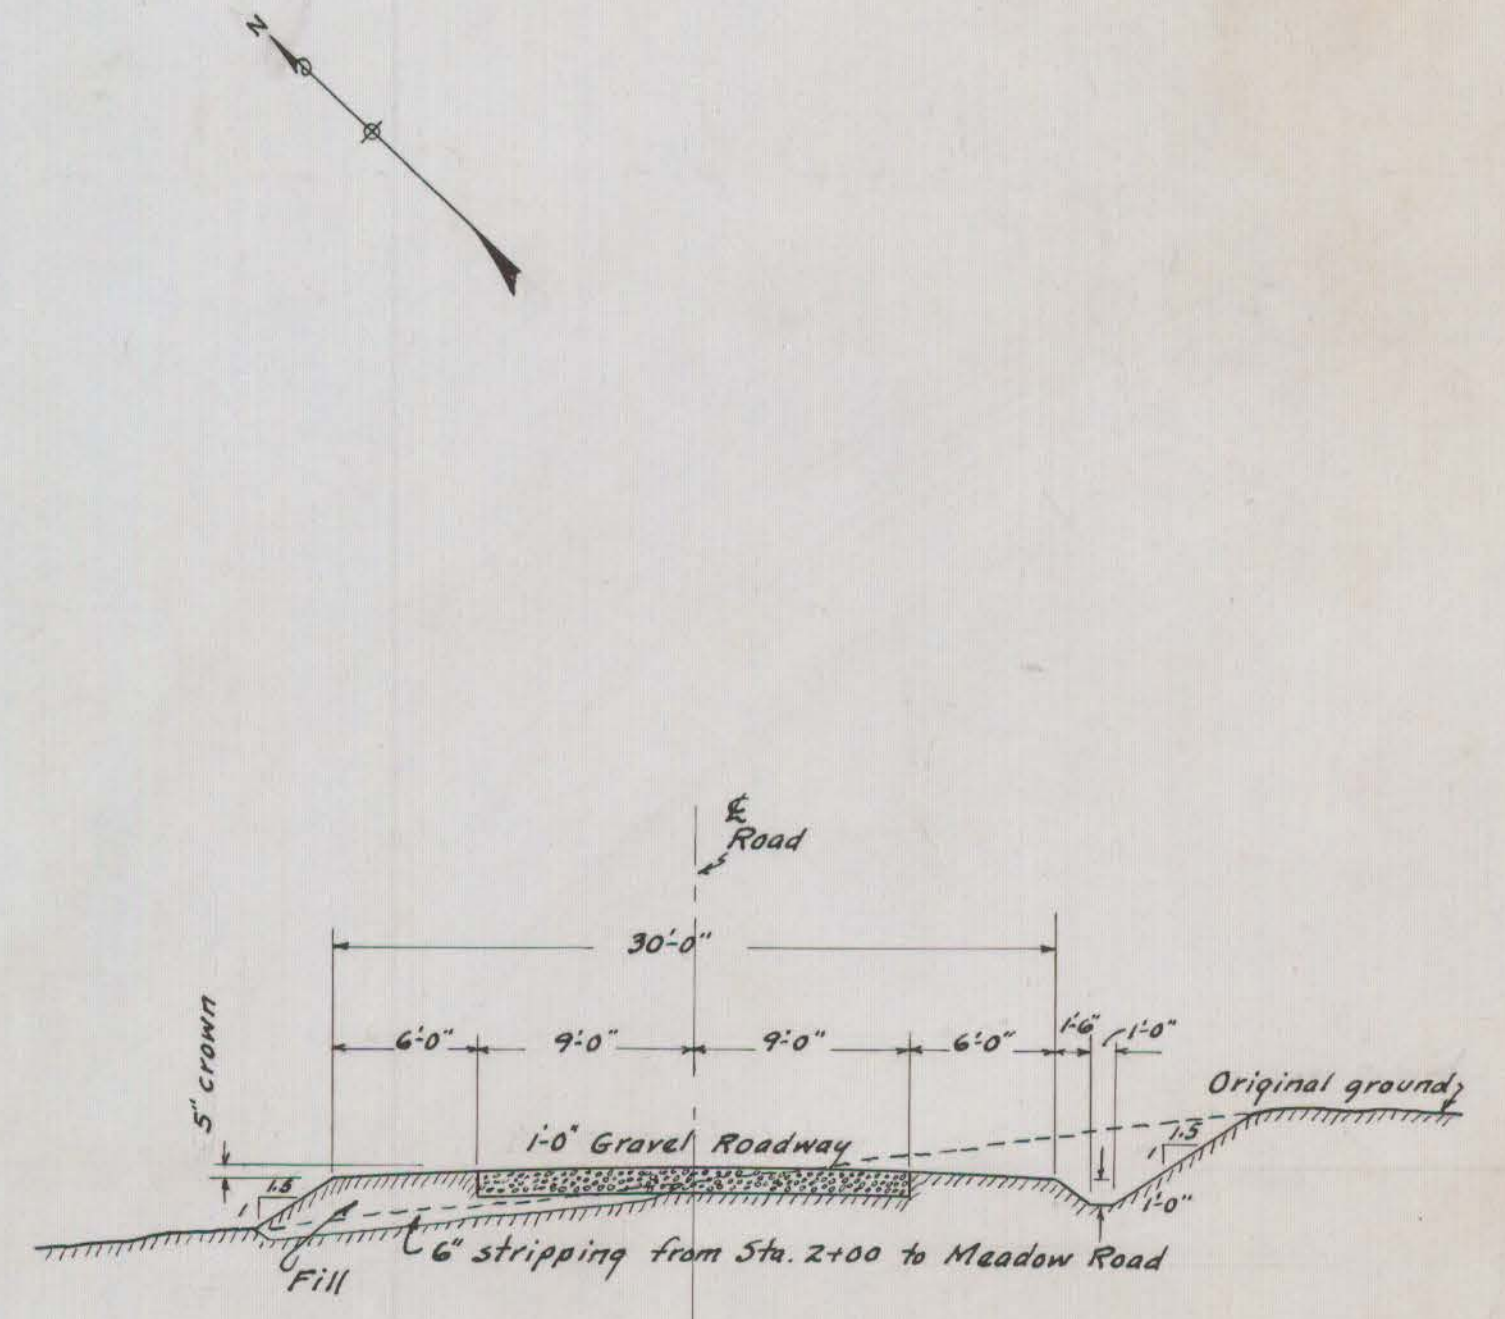


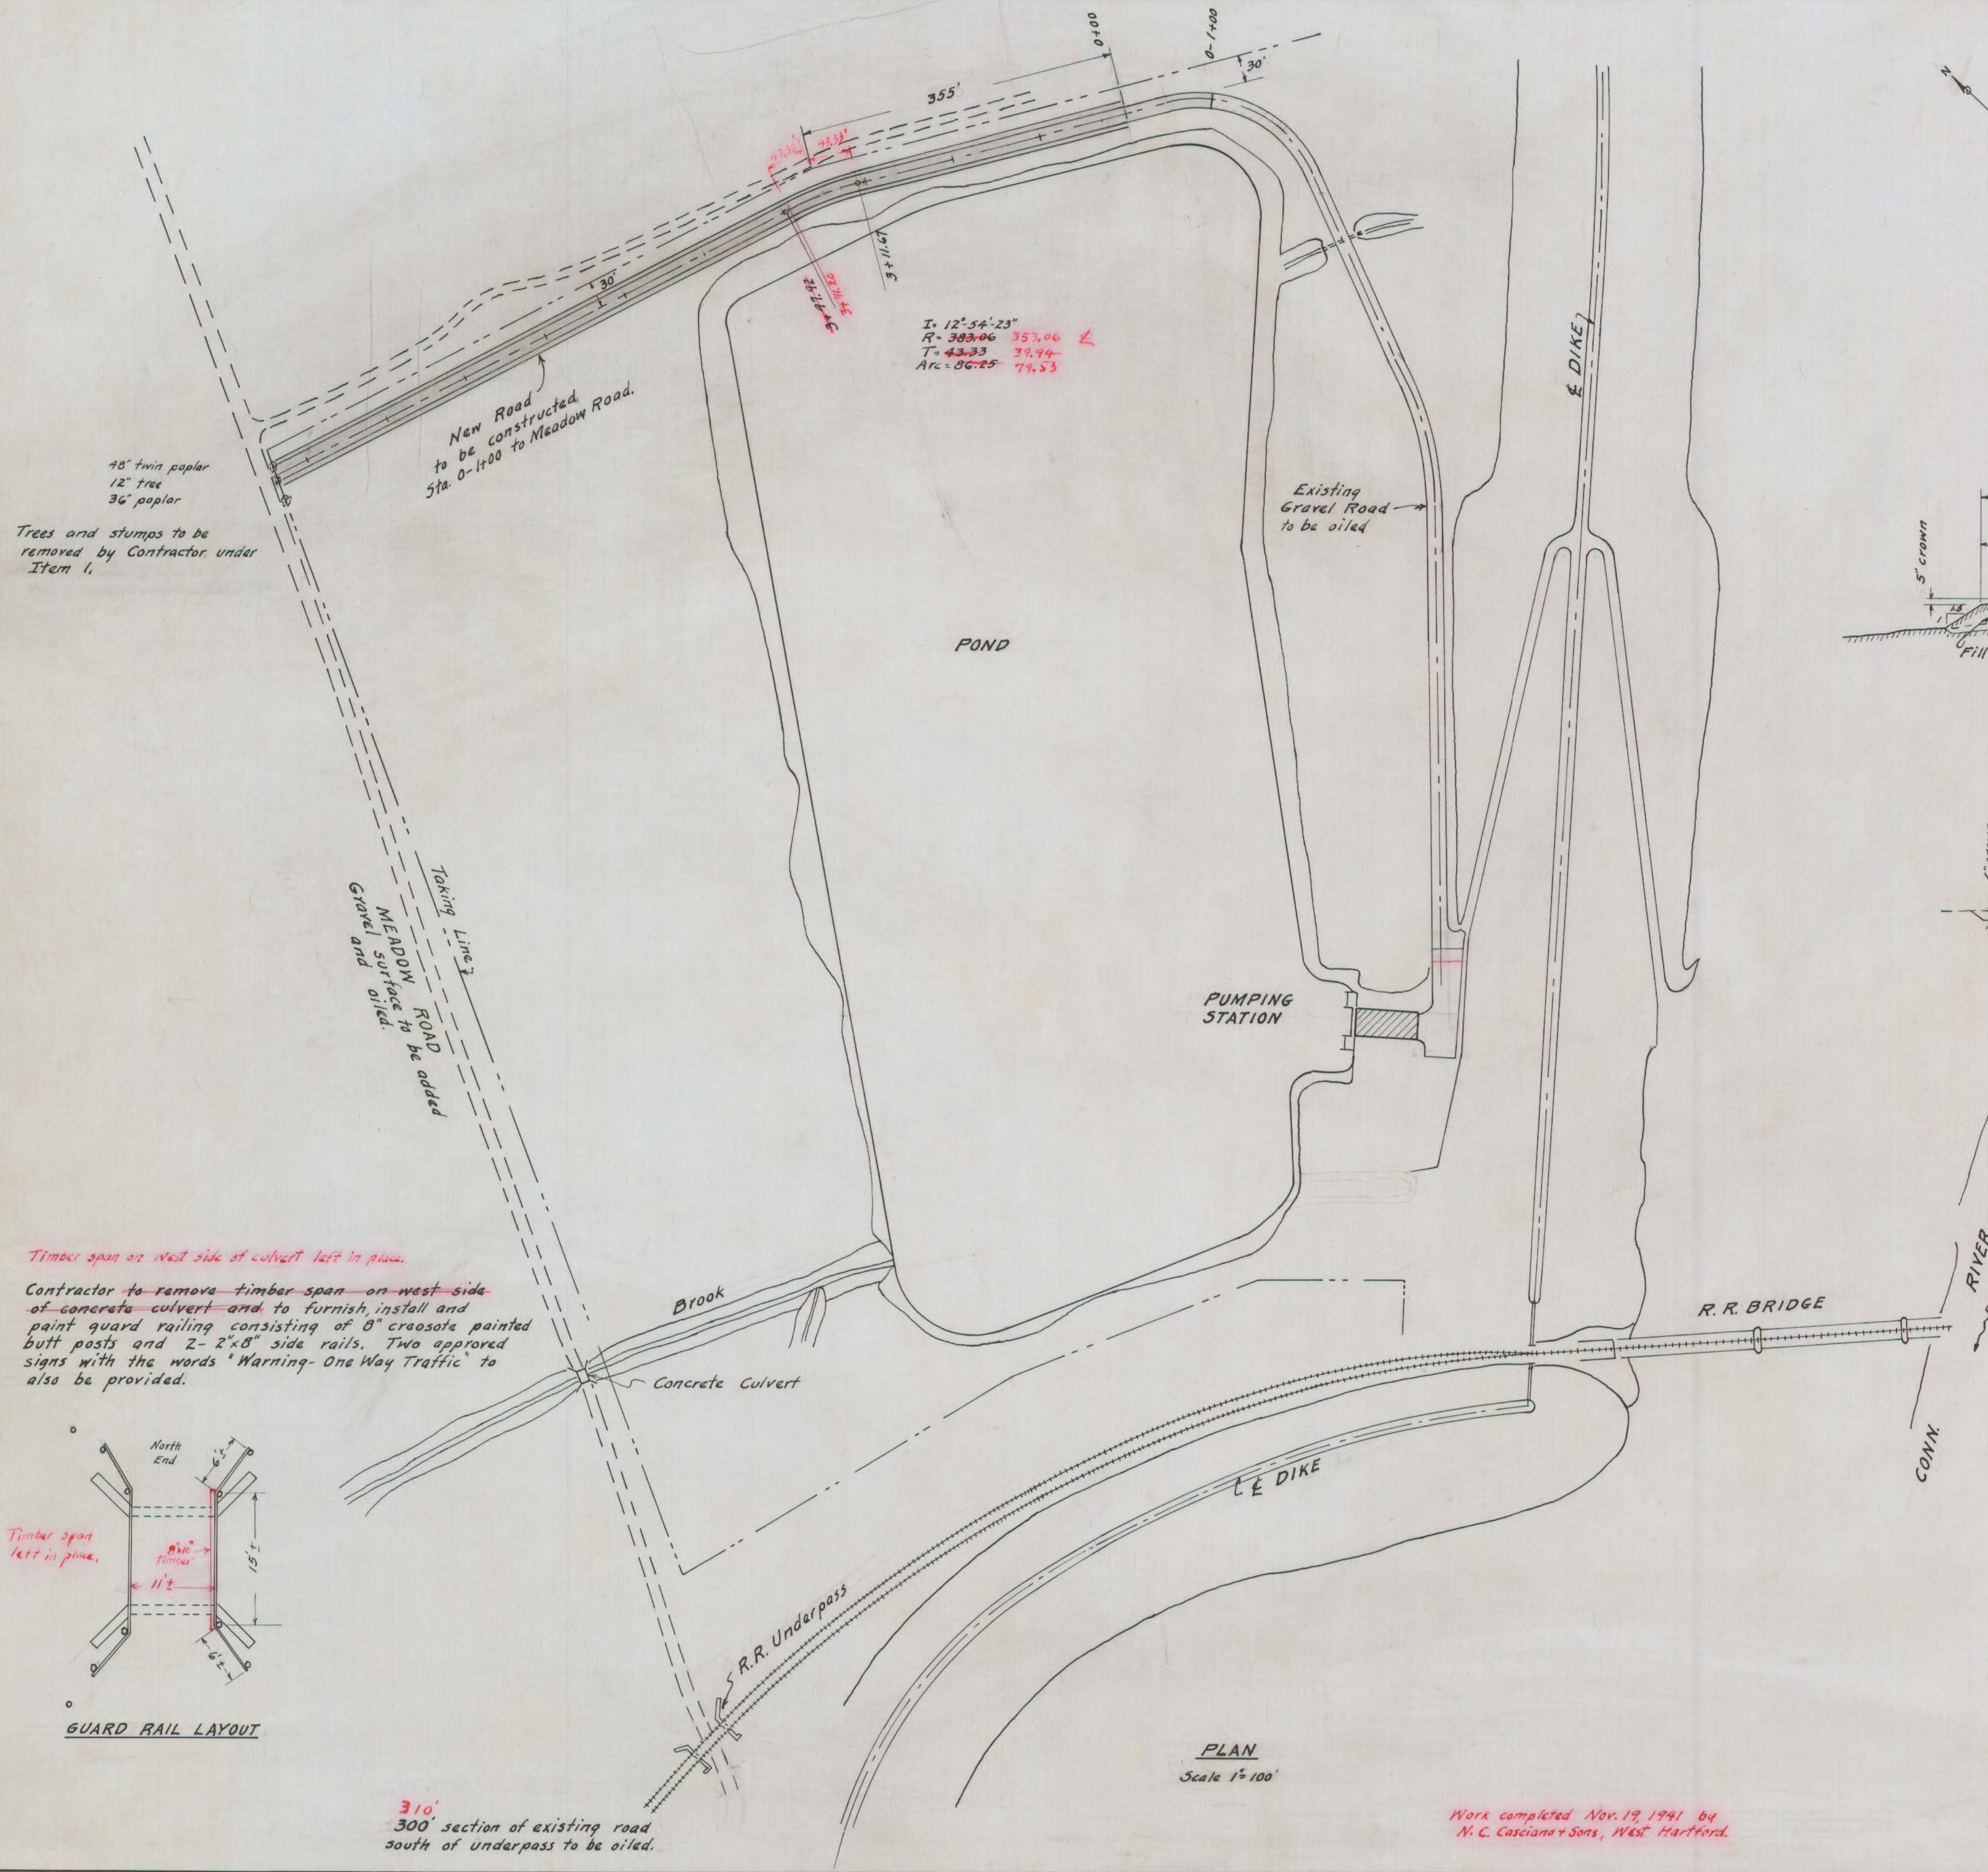

Timber span on west side of culvert left in place.

Contractor to remove timber span on west side of concrete culvert and to furnish, install and paint guard railing consisting of 8" creosote painted butt posts and 2-2"x8" side rails. Two approved signs with the words "Warning- One Way Traffic" to also be provided.

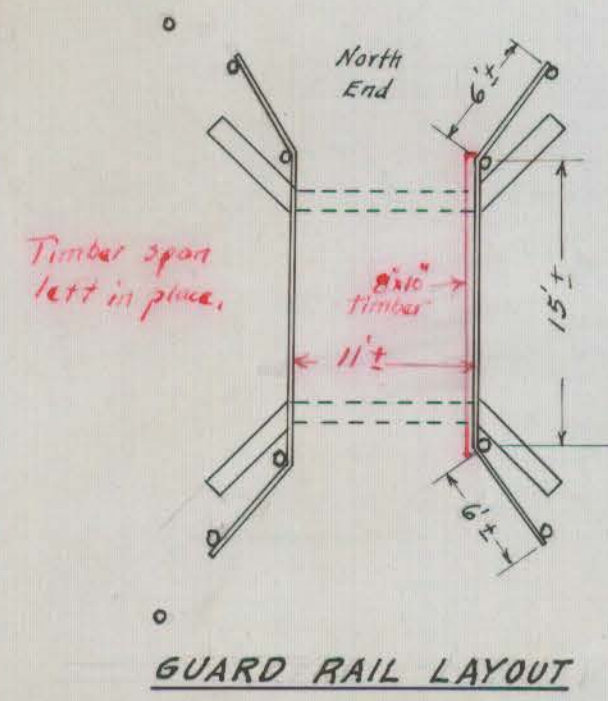

DEPT. OF ENGINEERING, HARTFORD CONN. ROBERT J. ROSS, CITY ENGINEER, & MANAGER, MET. DIST. BUR. PUBLIC WKS.		
FOR THE FLOOD COMMISSION OF THE CITY OF HARTFORD		
CONTRACT DRAWING, CONSTRUCTION OF		
ACCESS ROAD TO NORTH MEADOWS PUMPING STATION		
SCALES AS SHOWN		
SUBMITTED Charles H. Cooke DIVISION ENGINEER	RECOMMENDED NADW ASST. CITY ENG.	APPROVED Robert J. Ross CITY ENGINEER
DRAWN C.C.R.		DAYBOOK NO. 08263
TRACED C.C.R.		CHECK
SEPTEMBER 1941		

SHEET
1
OF 2 SHEETS