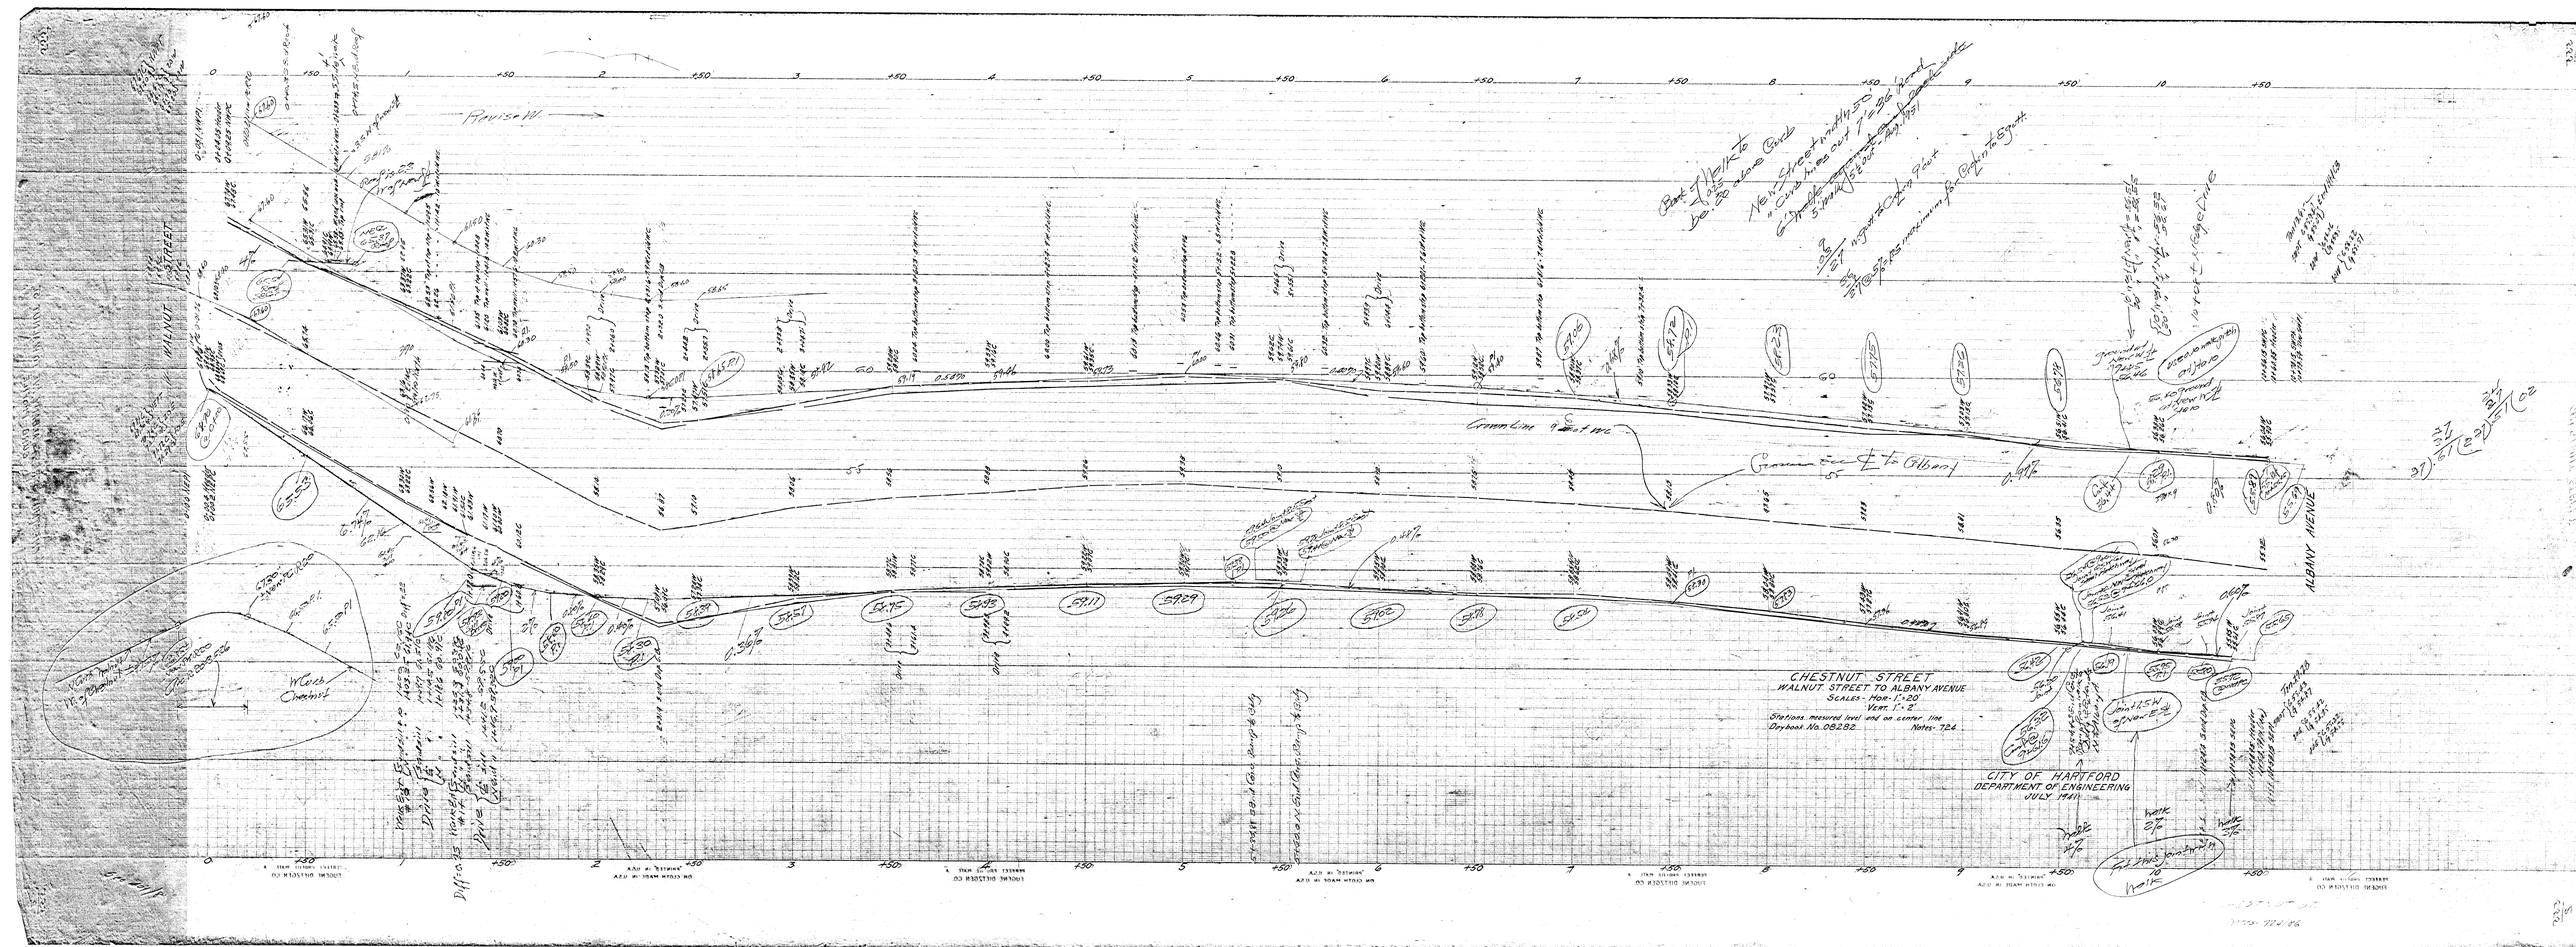
CHESTNUT STREET
WALNUT STREET TO ALBANY AVENUE
SCALES - HOR. 1"=20'
VERT. 1"=2'
Stations measured level and on center line
Orthood No. 08282 Notes- 724
CITY OF HARTFORD
DEPARTMENT OF ENGINEERING
JULY 1941
WALNUT STREET
ALBANY AVENUE
Grade Line E to Albany
Grade Line E to Albany
Grade Line E to Albany