


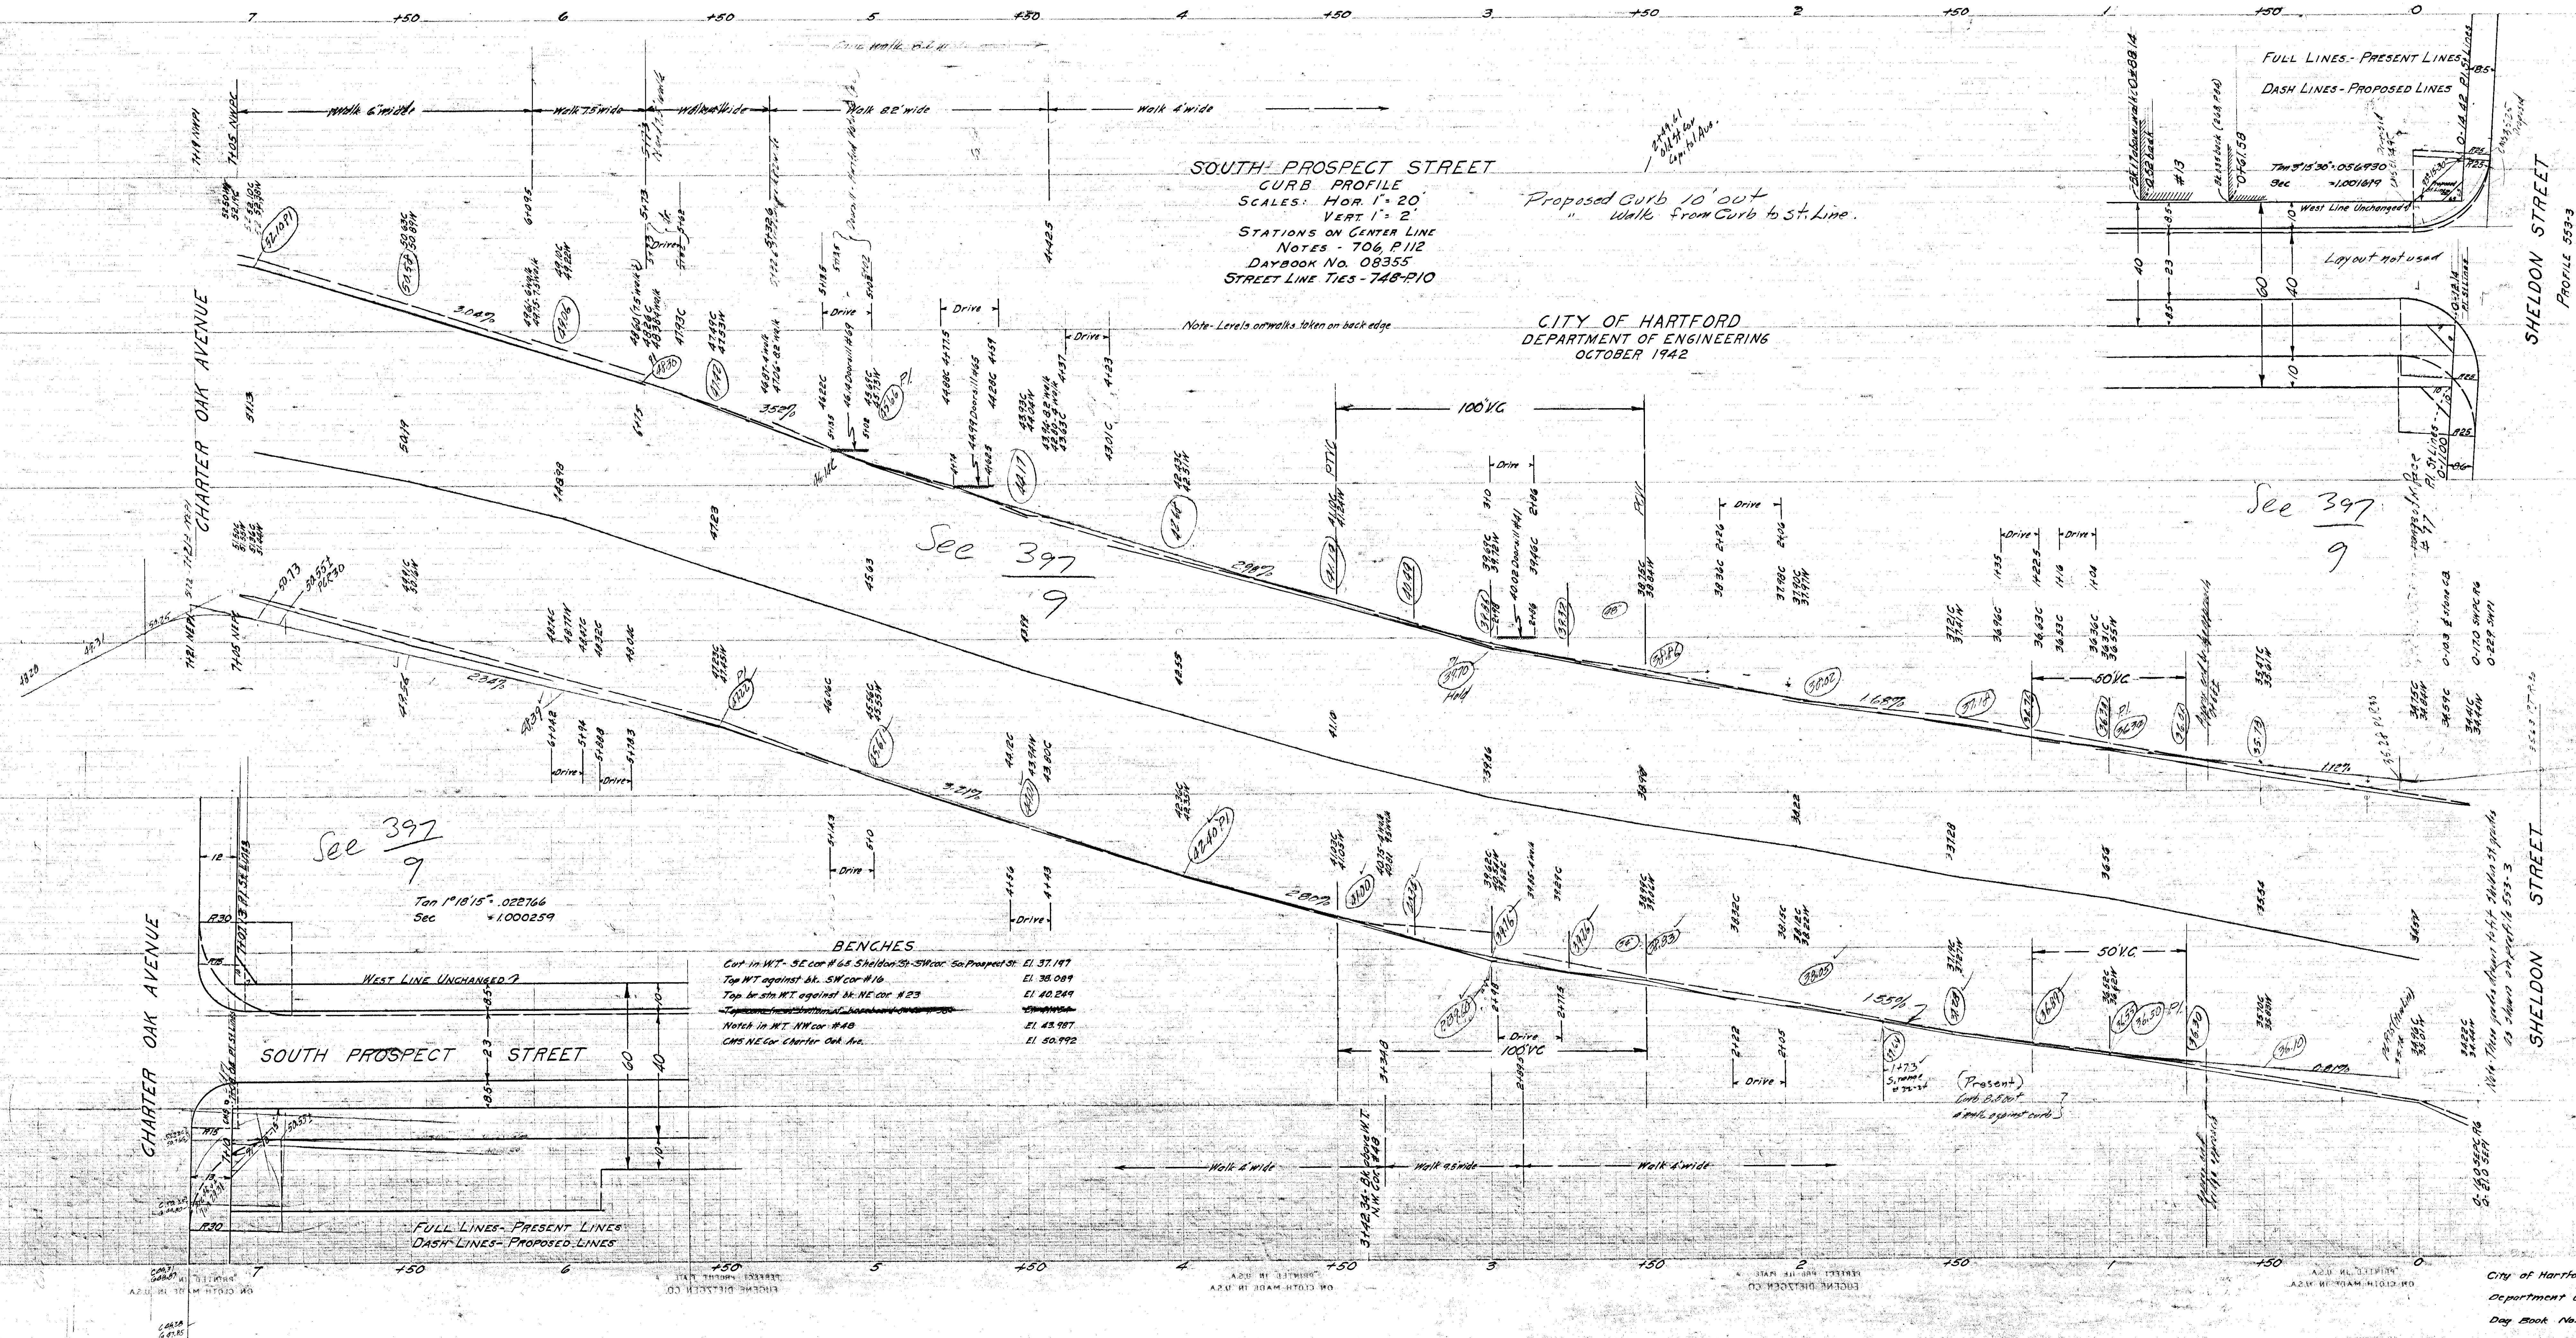

City of Hartford
Department of Engineering
Day Book No. 08355