
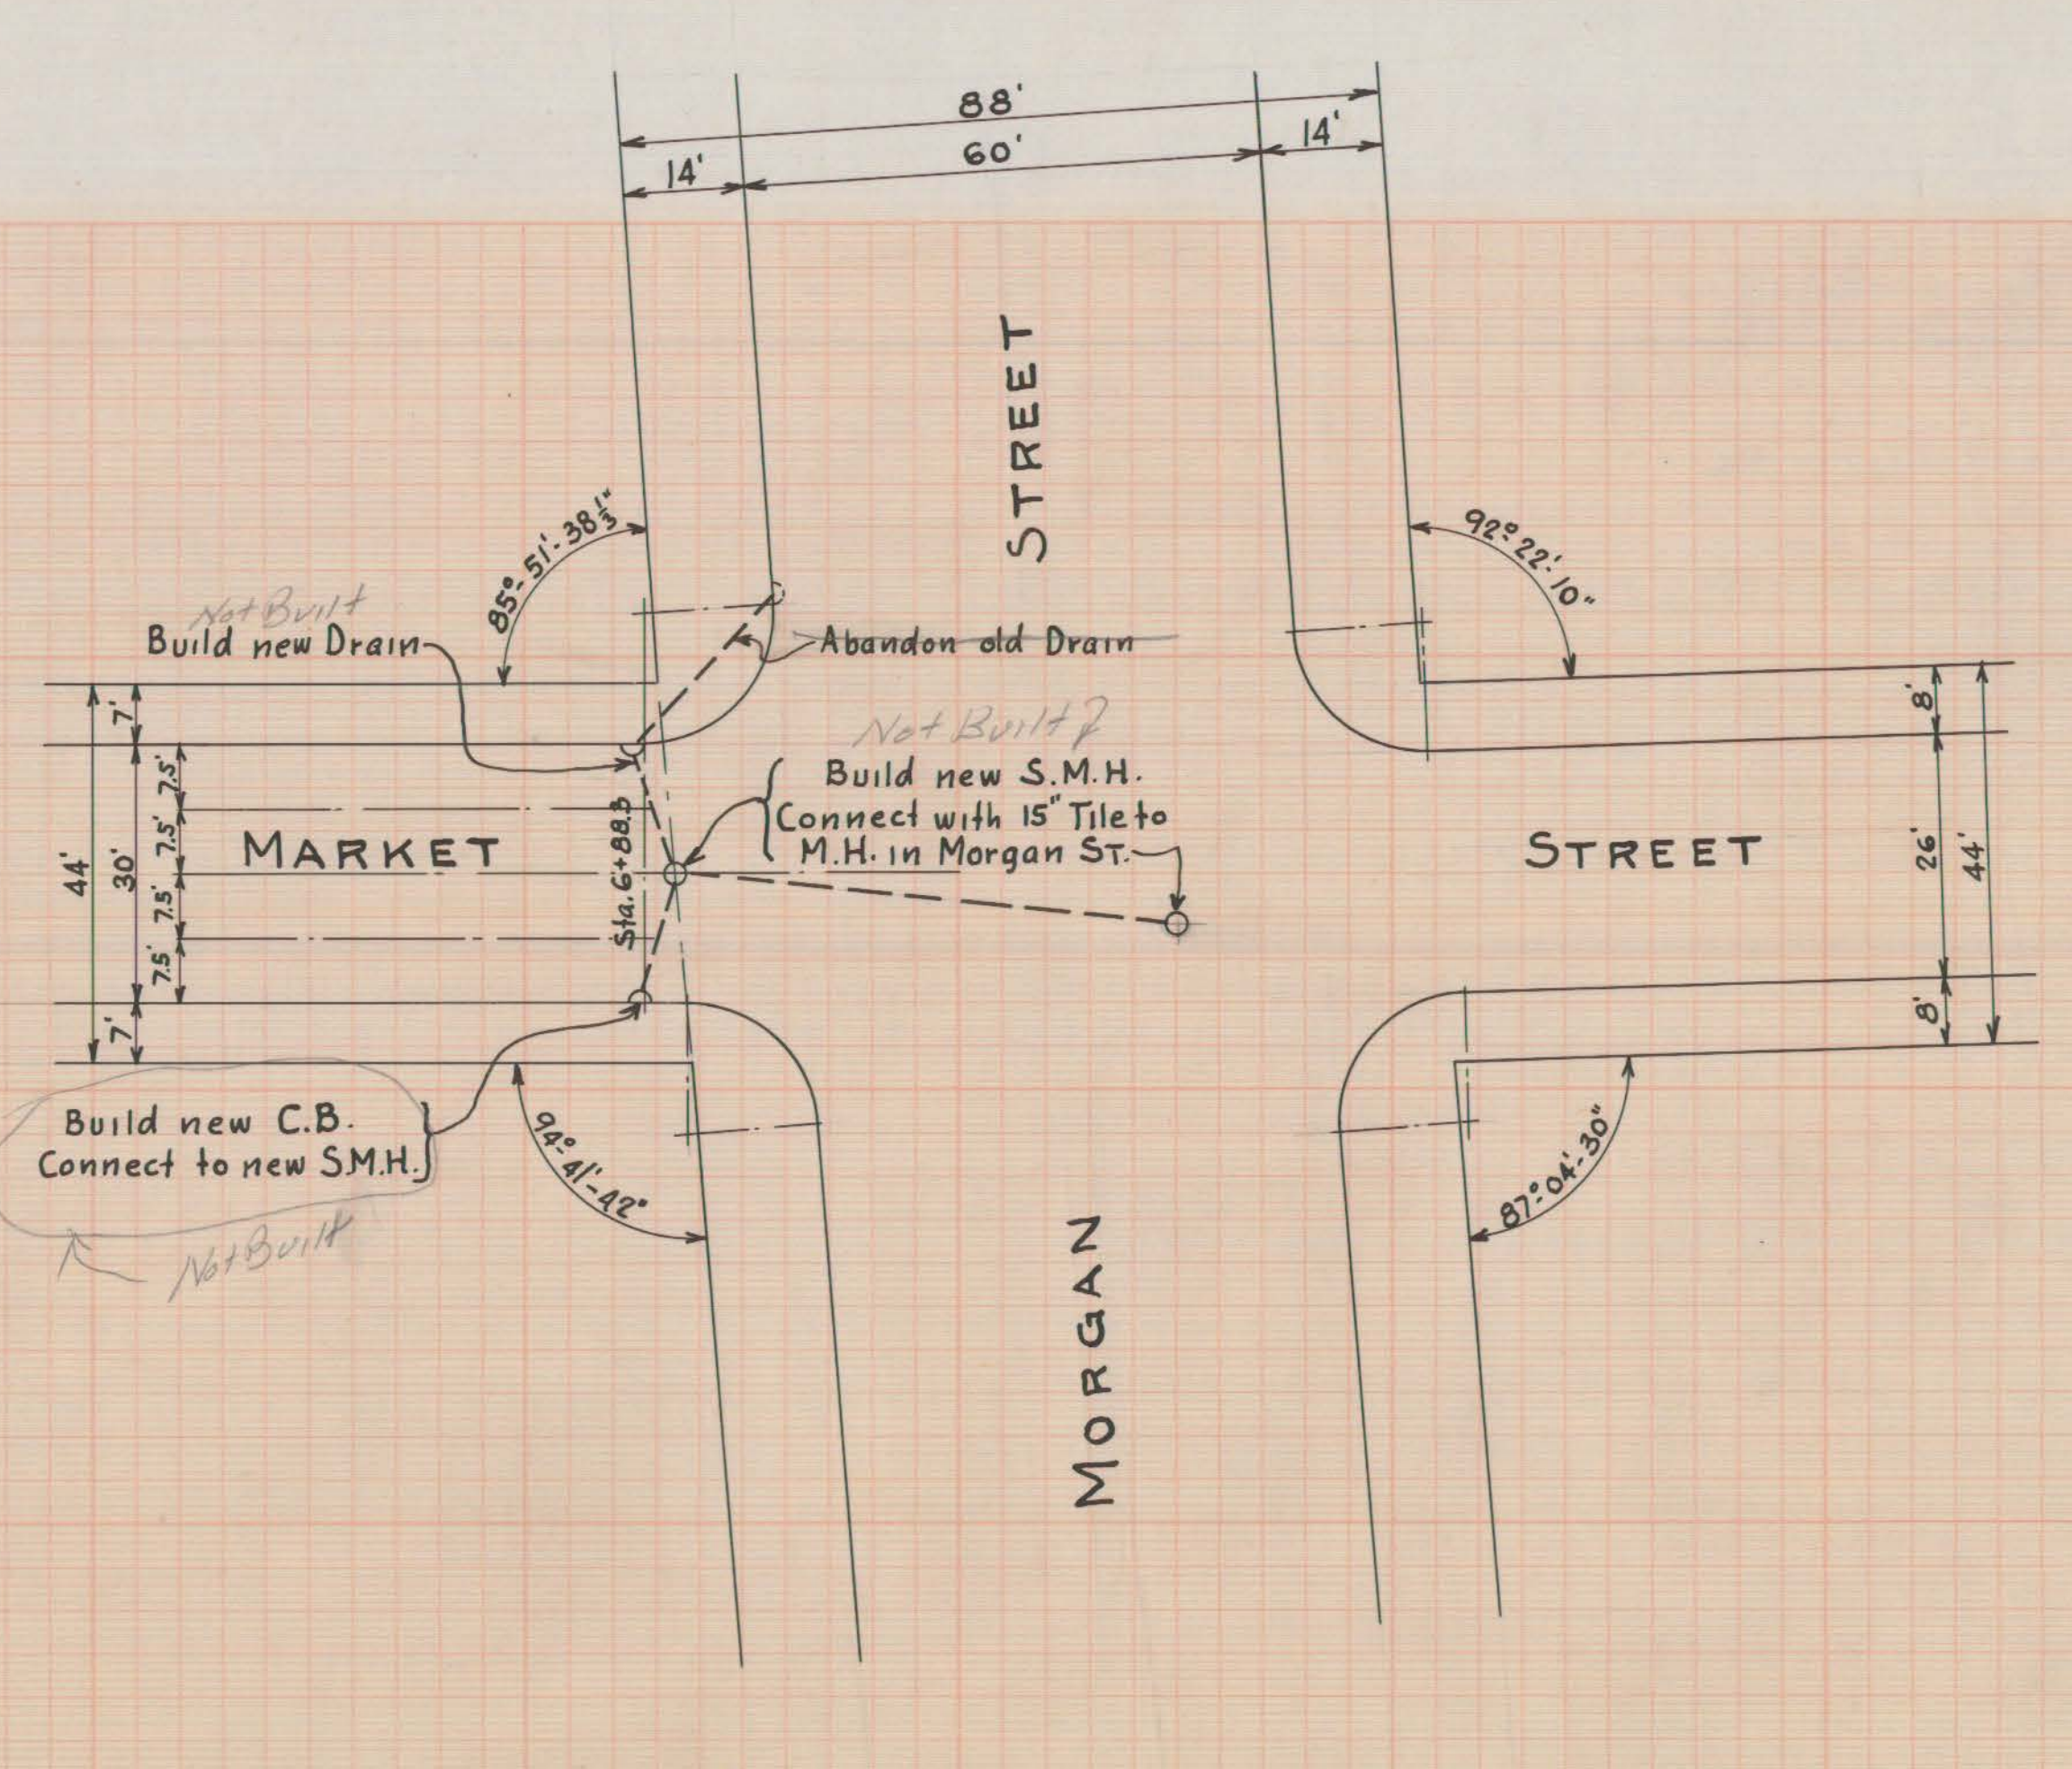
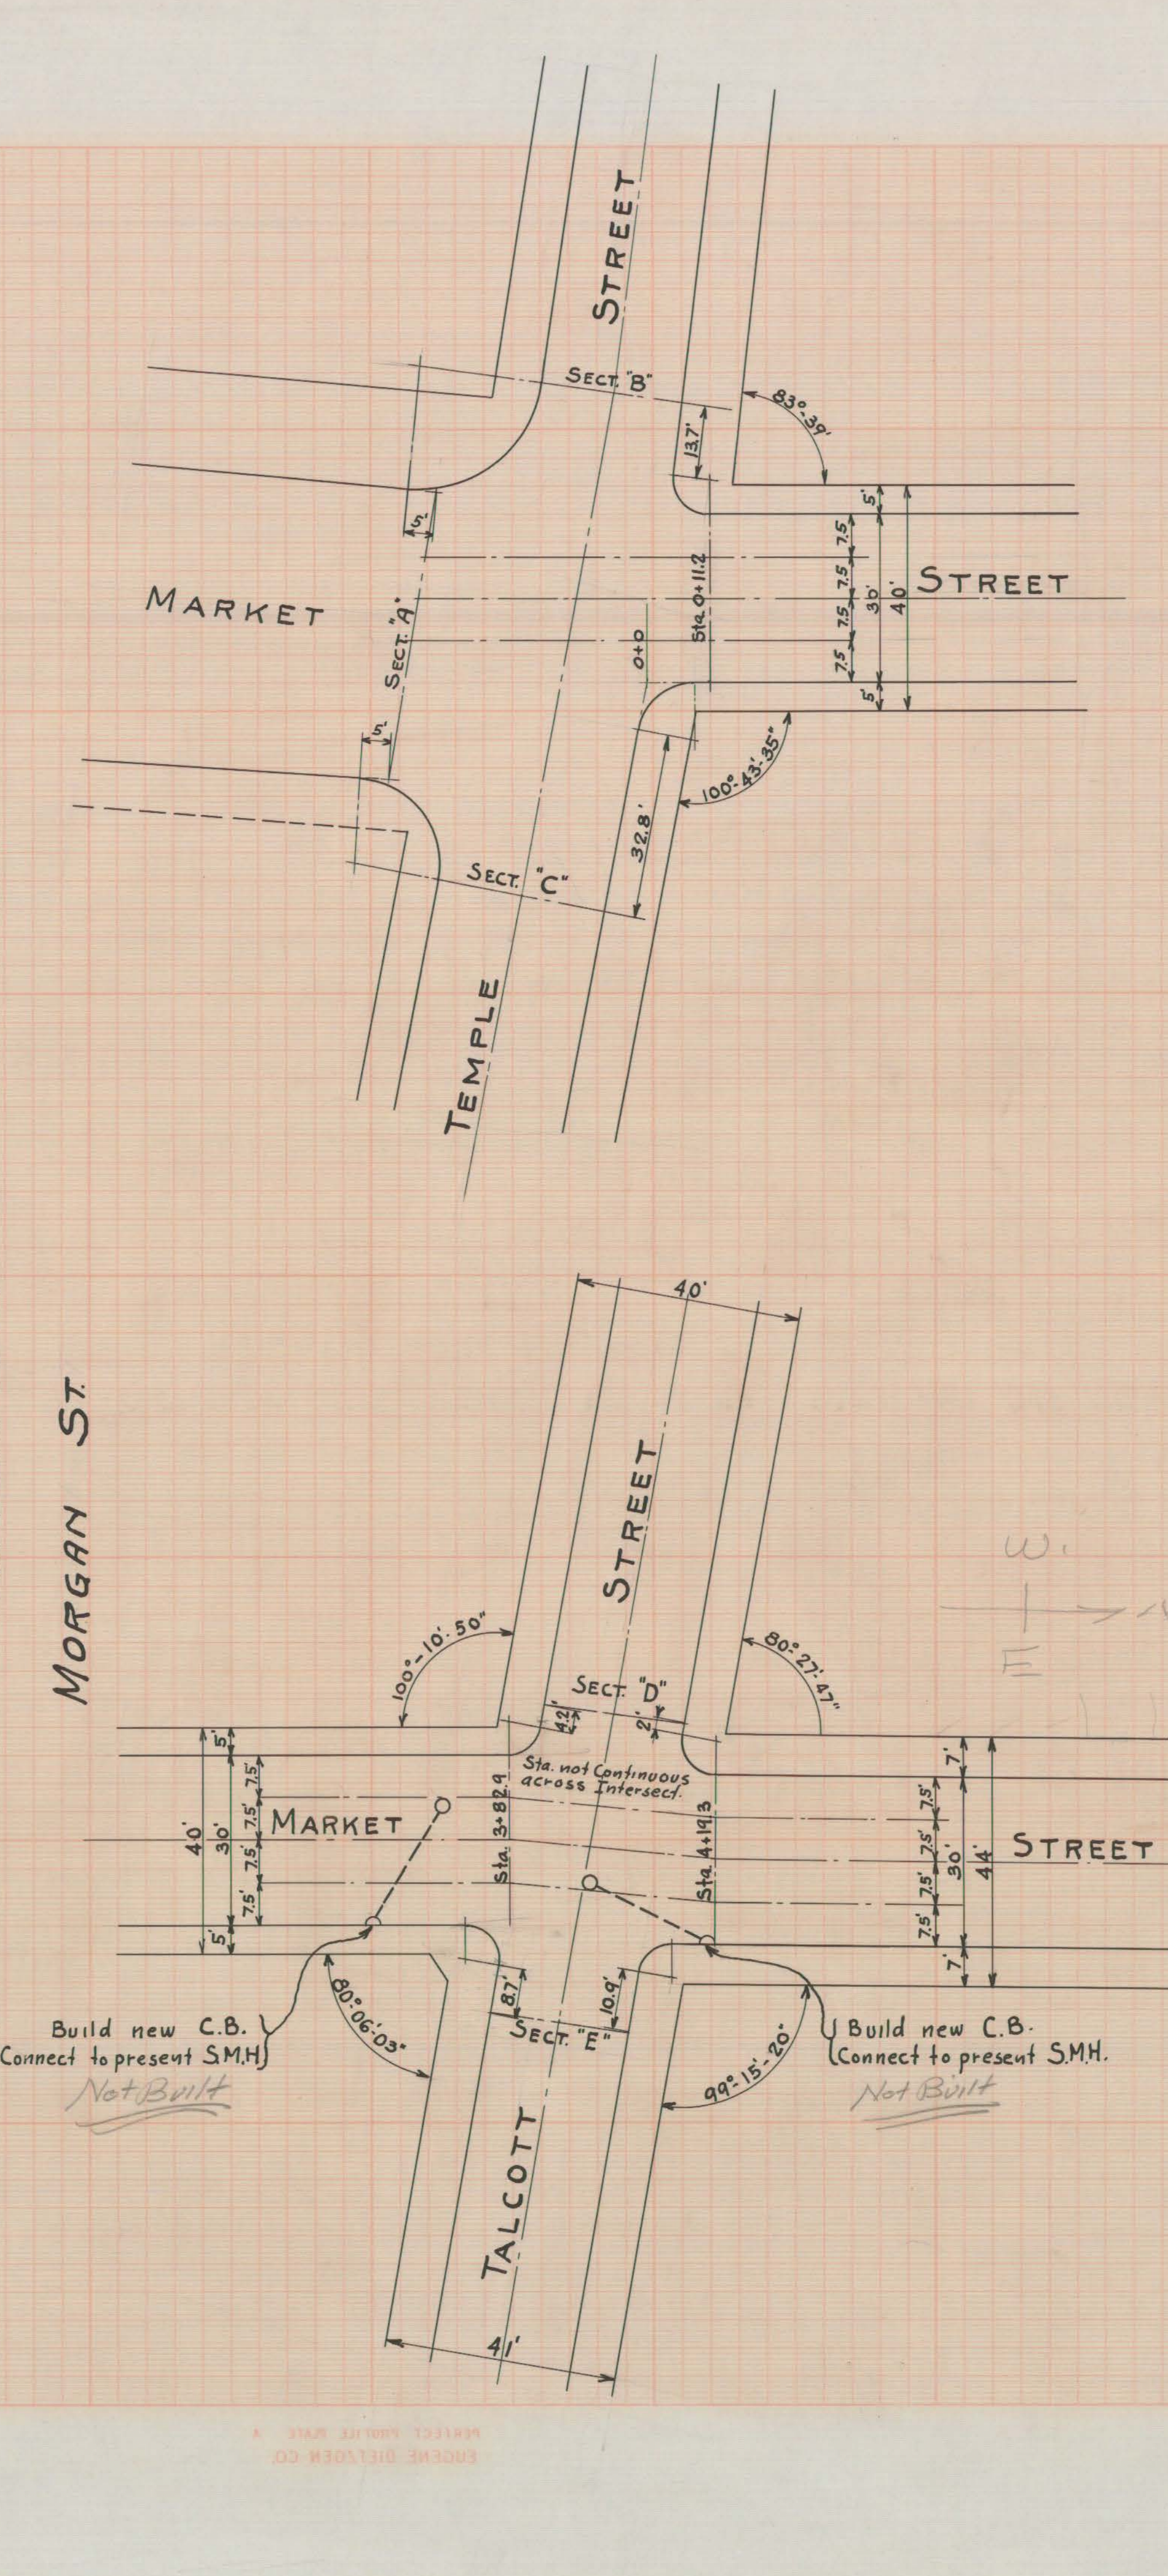


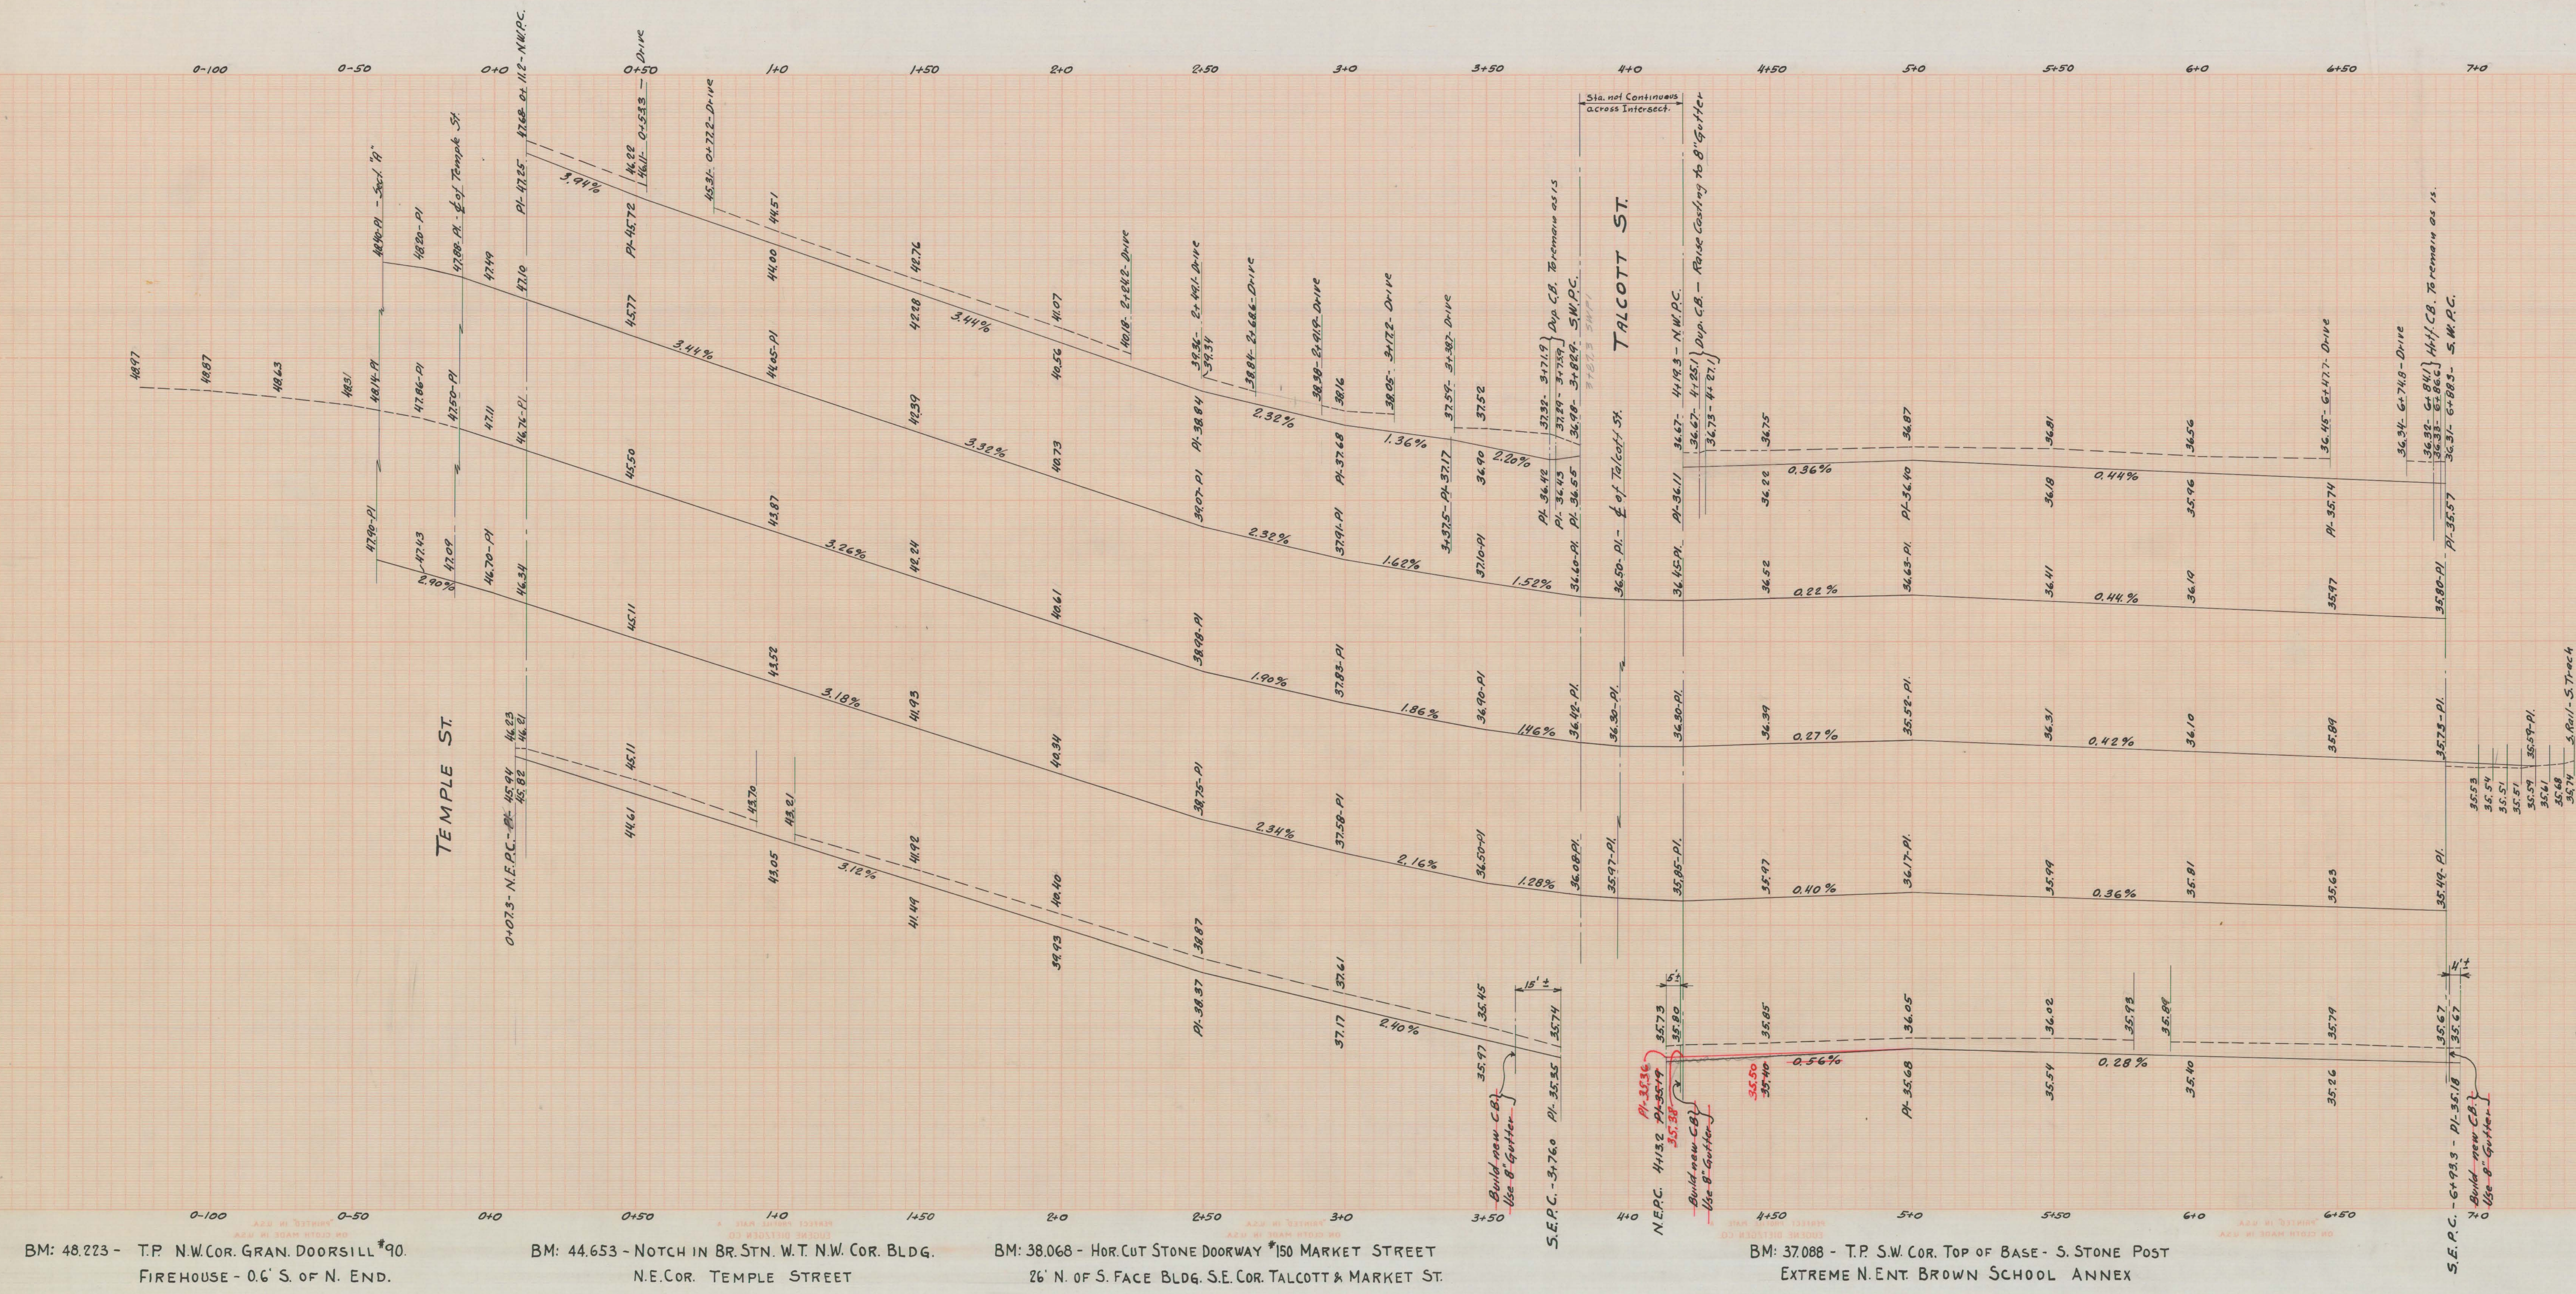

MARKET STREET PAVING PROFILE.
TEMPLE STREET TO MORGAN STREET.
HORIZONTAL SCALE 1"=20' - VERTICAL SCALE 1"=2'
STATIONS MEASURED ON EAST CURB FROM TEMPLE ST. TO MORGAN ST.

NOTE BOOK NO 649.
DAY BOOK NO 08422
SEE "SPECIAL SECTIONS" NO 557/0

CITY OF HARTFORD.
DEPARTMENT OF ENGINEERING.
MAY 1943.

BM: 48.223 - T.P. N.W. COR. GRAN. DOORSILL *90.
FIREHOUSE - O.G. S. OF N. END.

BM: 44.653 - NOTCH IN BR. STN. W.T. N.W. COR. BLDG.
N.E. COR. TEMPLE STREET

BM: 38.068 - HOR. CUT STONE DOORWAY *150 MARKET STREET
26' N. OF S. FACE BLDG. S.E. COR. TALCOTT & MARKET ST.

BM: 37.088 - T.P. S.W. COR. TOP OF BASE - S. STONE POST
EXTREME N. ENT. BROWN SCHOOL ANNEX