


Notes 759 P78
CASCO ST. EXT.

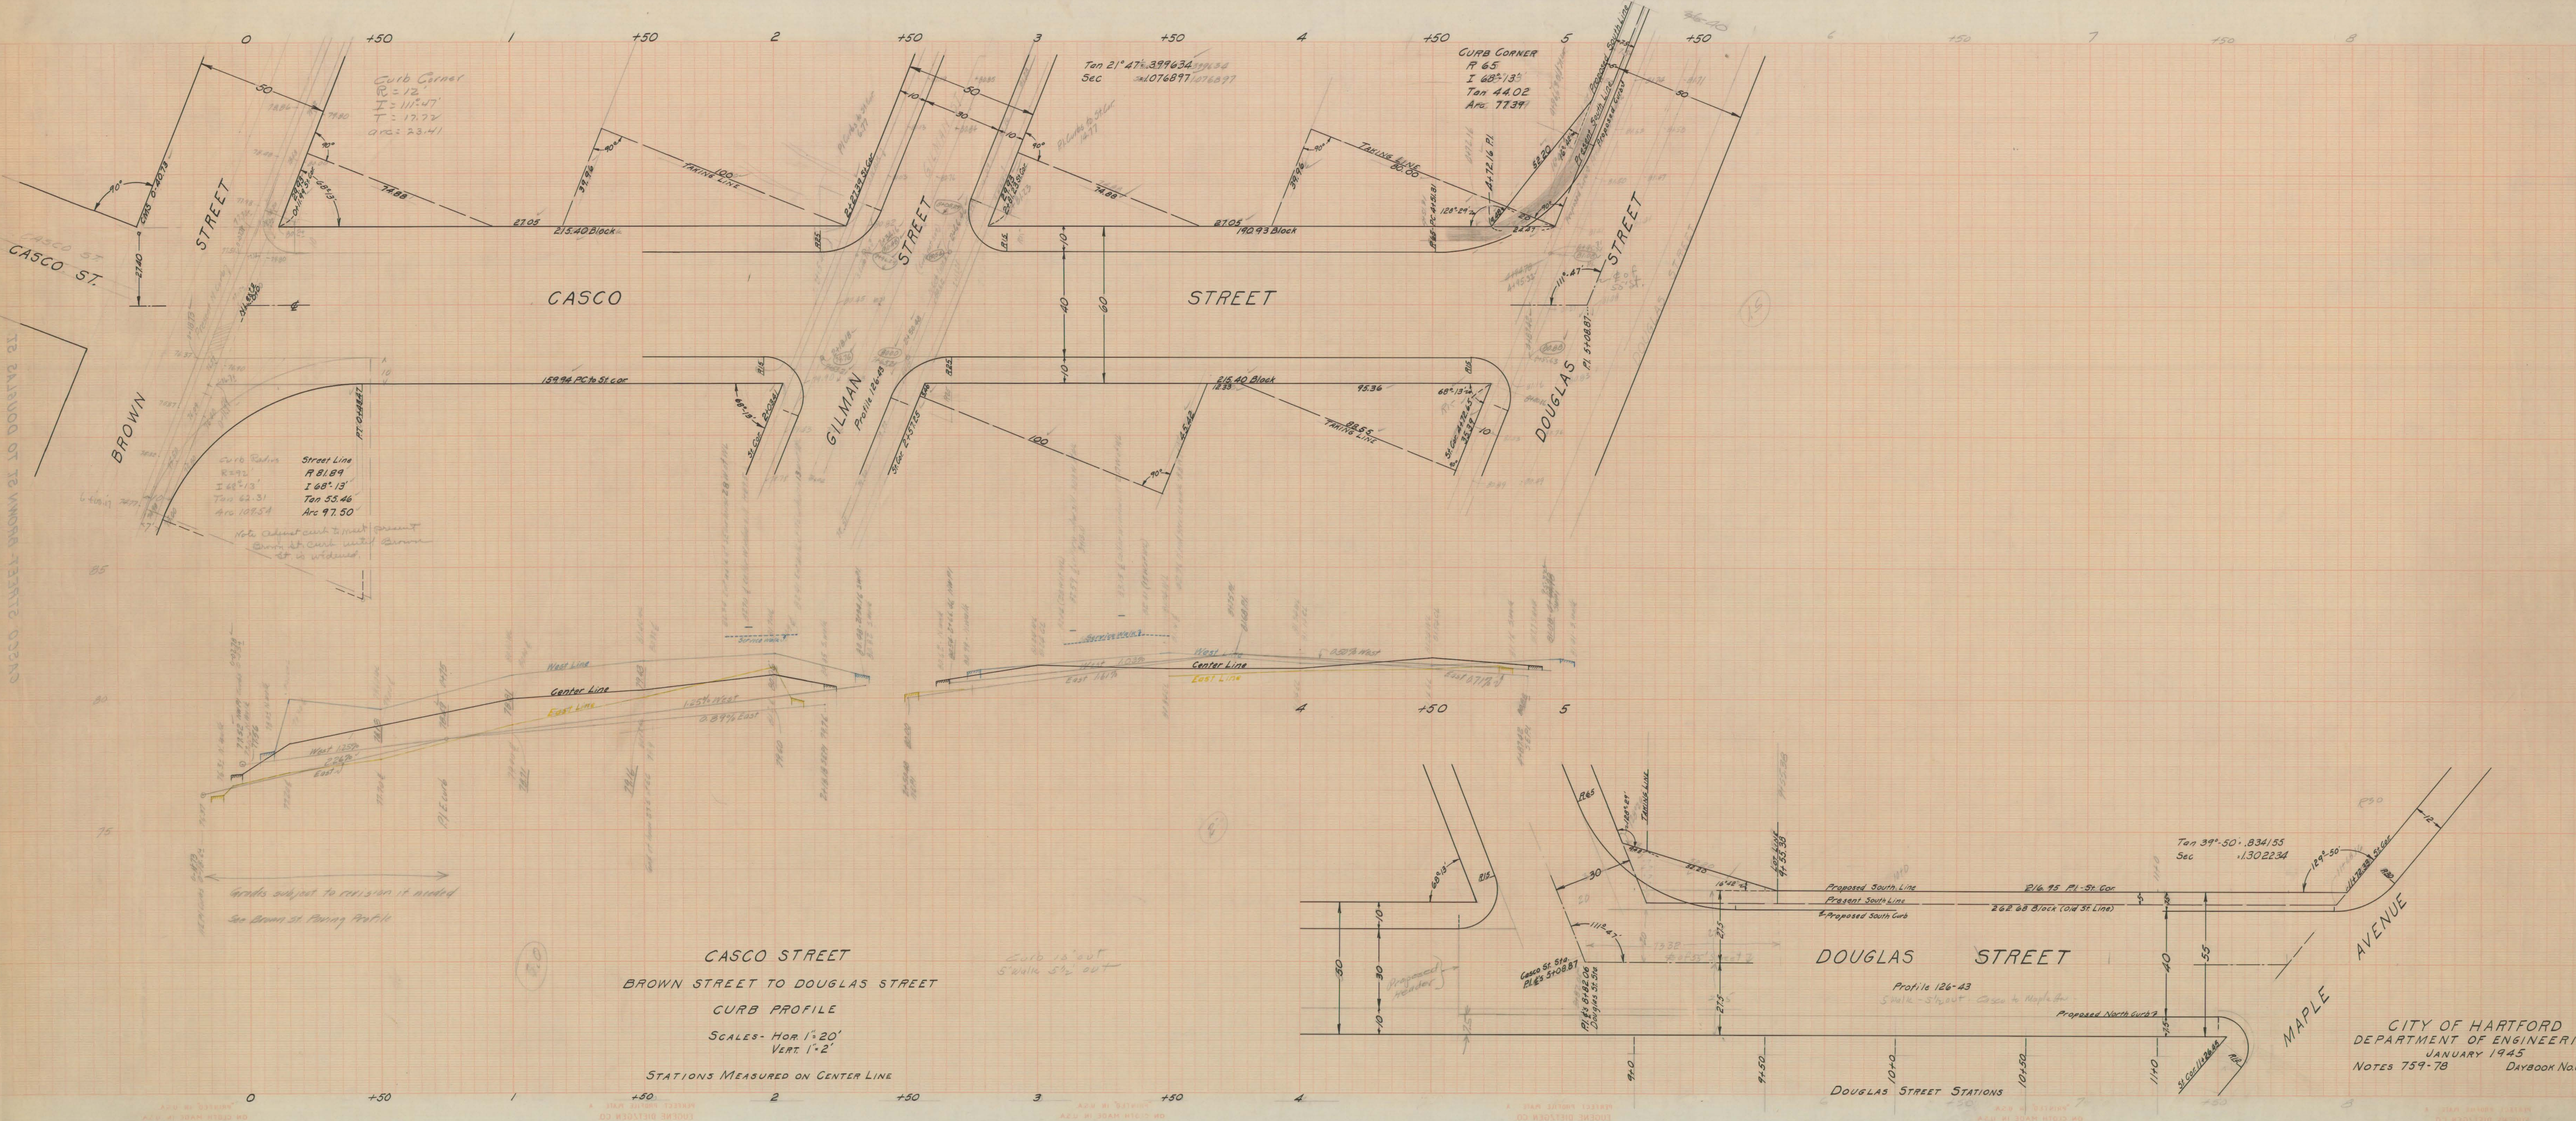

CASCO STREET
BROWN STREET TO DOUGLAS STREET
CURB PROFILE

SCALES - HOR 1"=20'
VERT 1"=2'

STATIONS MEASURED ON CENTER LINE

CITY OF HARTFORD
DEPARTMENT OF ENGINEERING
JANUARY 1945
NOTES 759-78 DAYBOOK No. 0861