


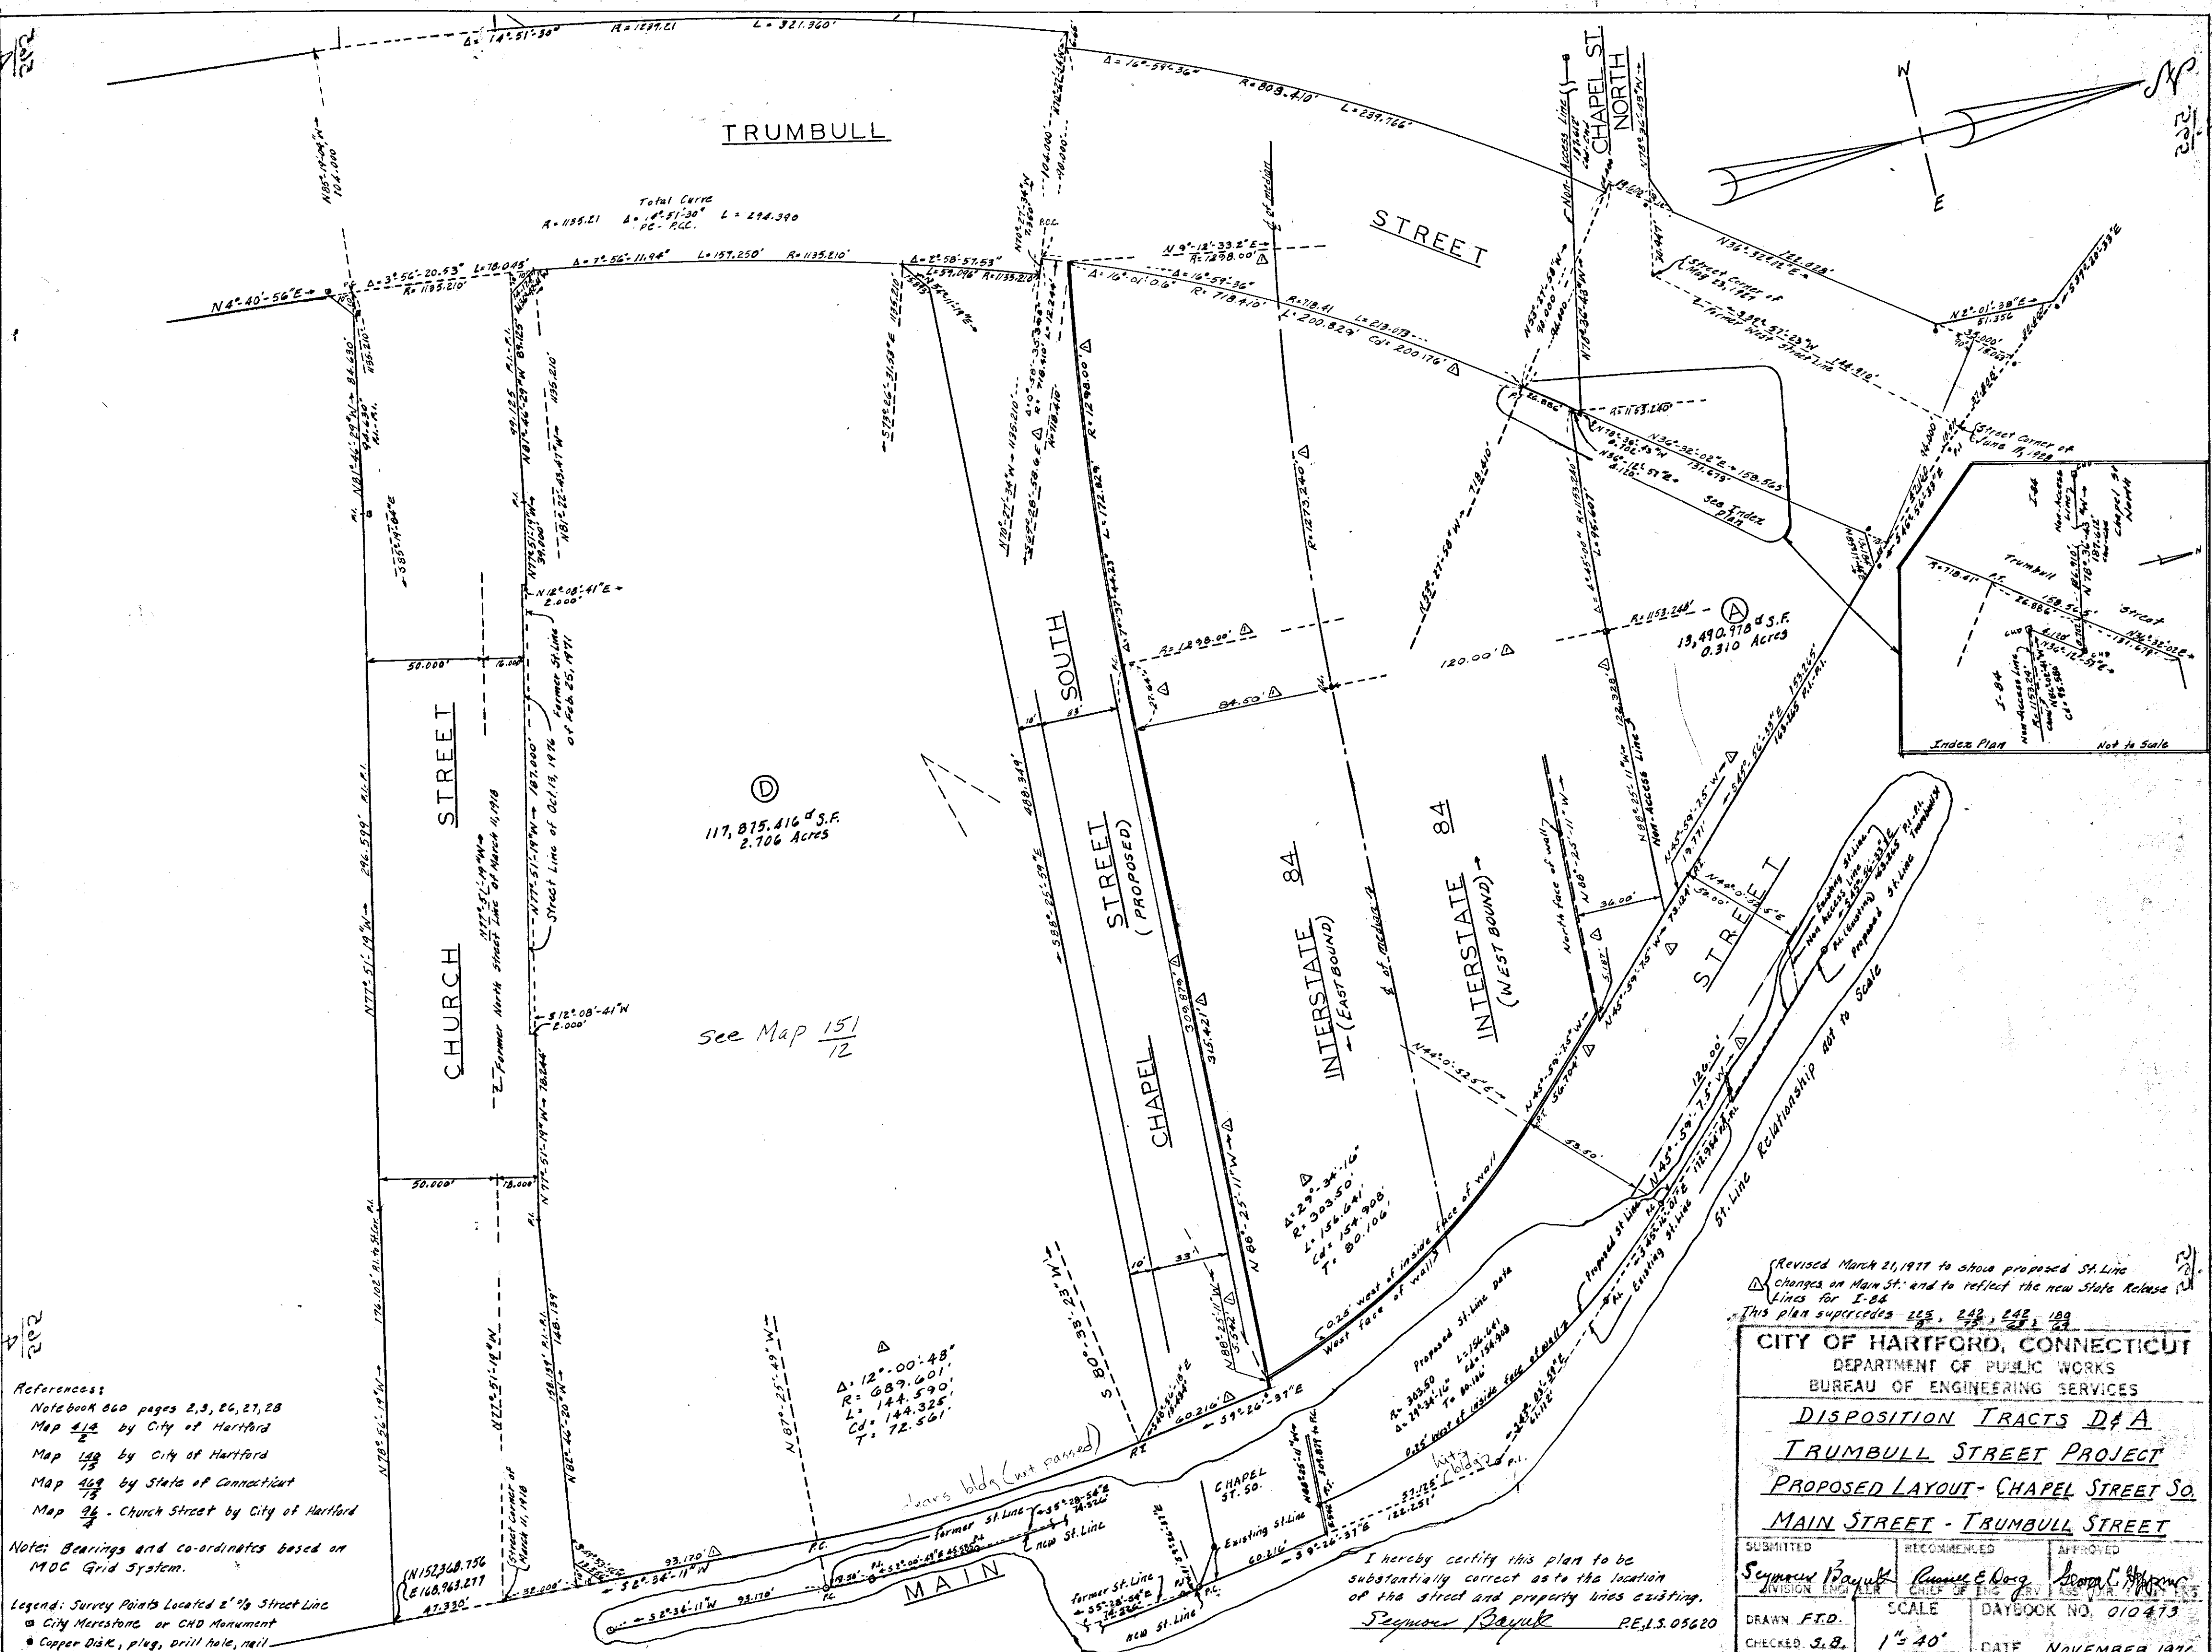

References:
Notebook 660 pages 2,3,26,27,28
Map 412 by City of Hartford
Map 140 by City of Hartford
Map 469 by State of Connecticut
Map 94 - Church Street by City of Hartford

Notes: Bearings and co-ordinates based on MDC Grid System.

Legend: Survey Points Located 2' to Street Line
City Merestone or CHD Monument
Copper Disk, plug, Drill Hole, nail

Revised March 21, 1977 to show proposed St. Line changes on Main St. and to reflect the new State Release Lines for I-84.
This plan supercedes 255, 242, 242, 189

CITY OF HARTFORD, CONNECTICUT
DEPARTMENT OF PUBLIC WORKS
BUREAU OF ENGINEERING SERVICES

DISPOSITION TRACTS D & A
TRUMBULL STREET PROJECT
PROPOSED LAYOUT - CHAPEL STREET SO.
MAIN STREET - TRUMBULL STREET

SUBMITTED Seymour Bayuk DIVISION ENGINEER	RECOMMENDED Russell E. Dwyer CHIEF OF ENGINEERING	APPROVED George C. Hyman ASSISTANT TO THE COMMISSIONER
DRAWN F.T.D.	SCALE 1" = 40'	DAYBOOK NO. 010473
CHECKED J.B.		DATE NOVEMBER, 1976

I hereby certify this plan to be substantially correct as to the location of the street and property lines existing.
Seymour Bayuk P.E. 15,05620