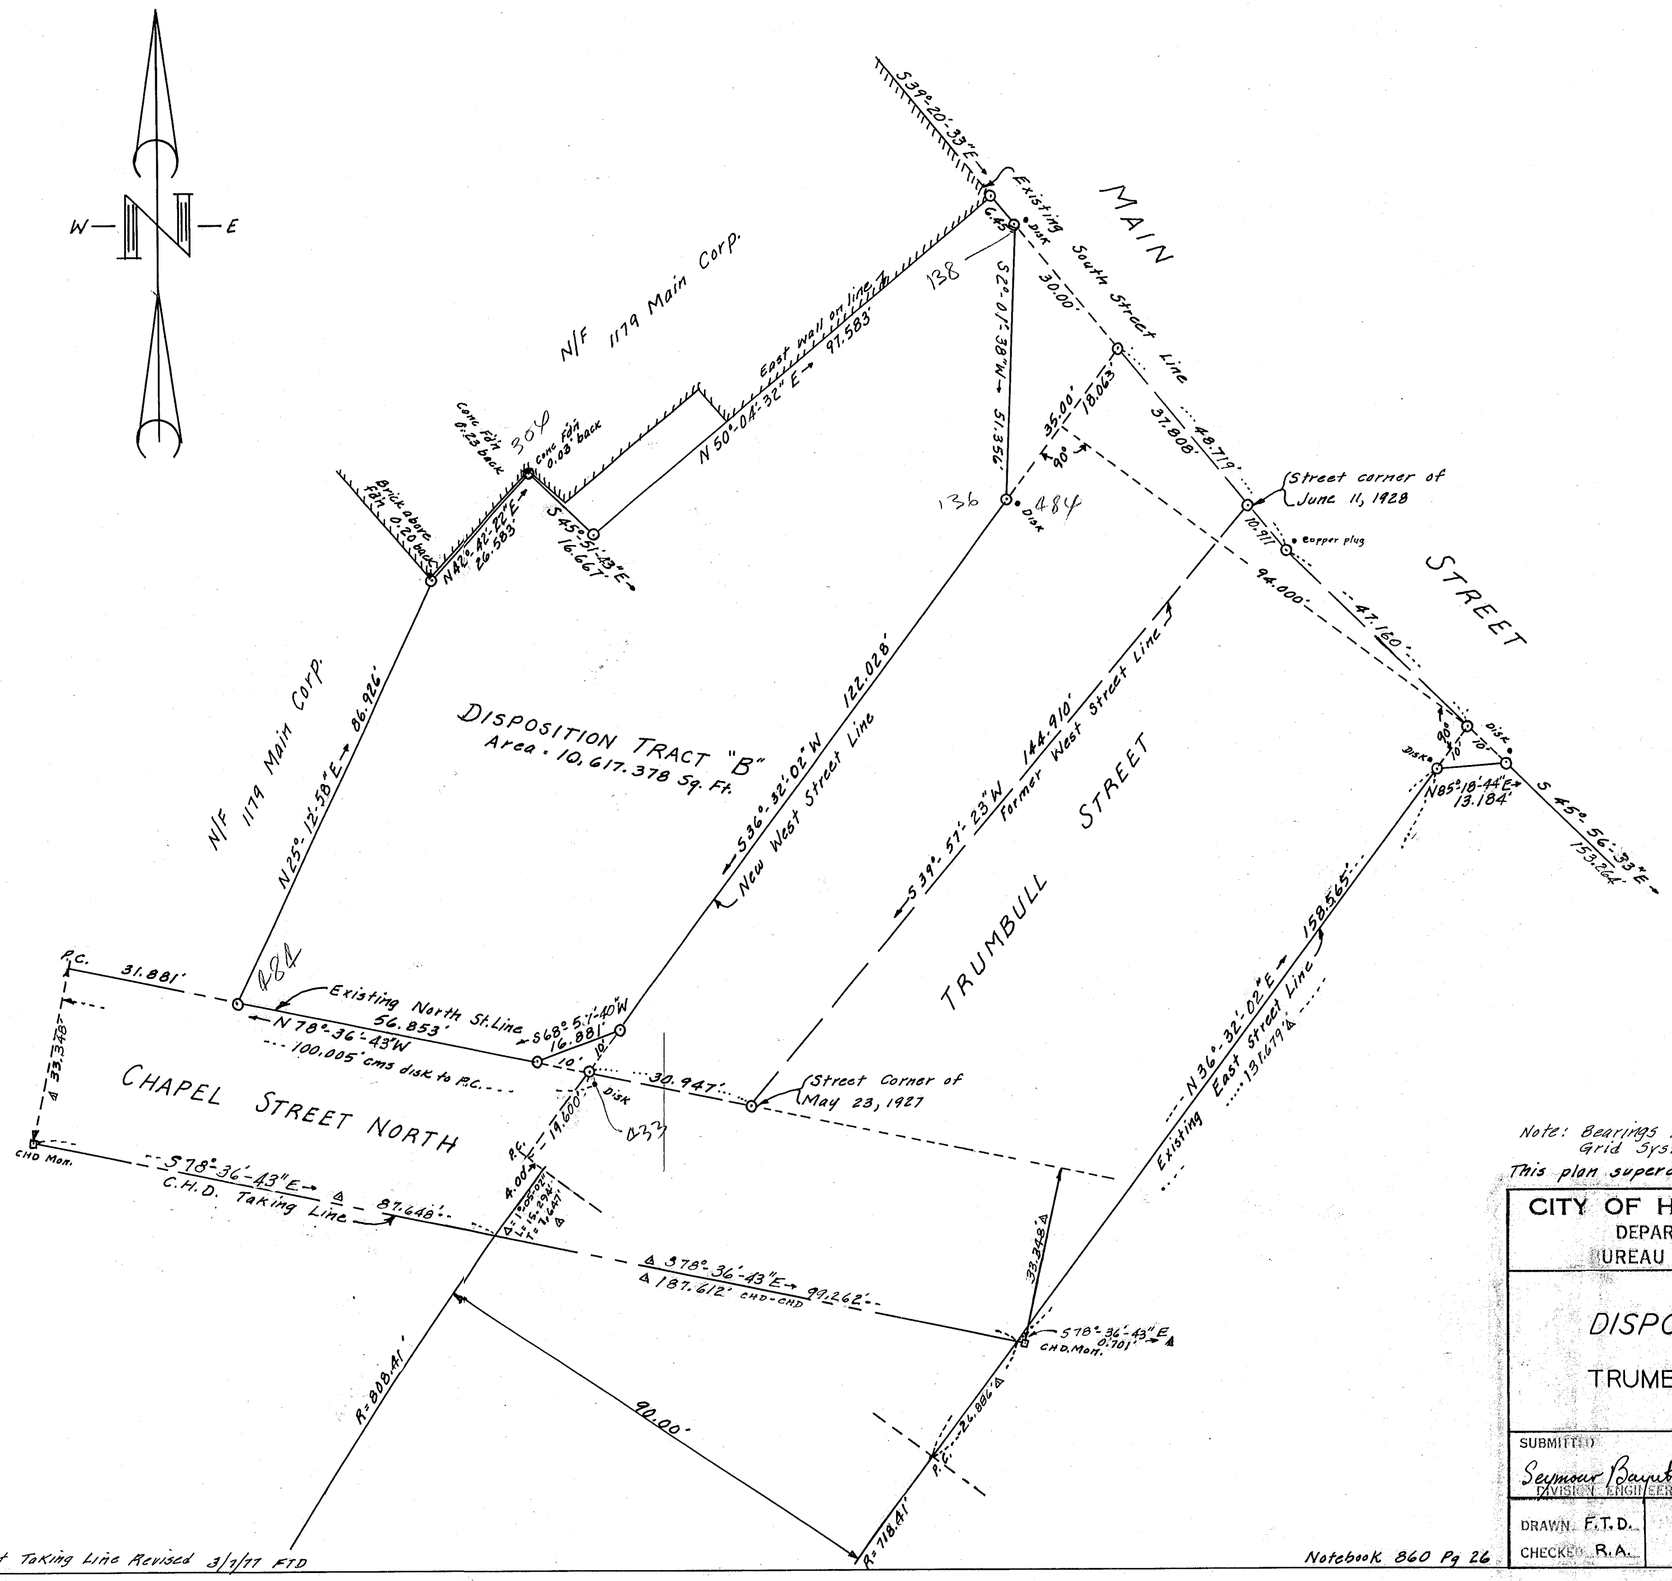

Note: Bearings revised Nov., 1976 to conform to M.D.C. Grid System.

This plan supercedes plan 242/65 - Daybook # 010040

CITY OF HARTFORD, CONNECTICUT DEPARTMENT OF PUBLIC WORKS BUREAU OF ENGINEERING SERVICES		
DISPOSITION TRACT B TRUMBULL ST. PROJECT		
SUBMITTED Seymour Baynt DIVISION ENGINEER	RECOMMENDED Russell E. Dorg CHIEF OF ENG. SERV.	APPROVED George E. Hoffner A. 3. DIR. & CHIEF ENG.
DRAWN F.T.D. CHECKED R.A.	SCALE 1" = 20'	DAYBOOK NO. 010520 REVISED Nov. 1976 DATE APRIL, 1975

Note:
Δ State of Connecticut Taking Line Revised 3/7/77 FTD

Notebook 860 Pg 26