
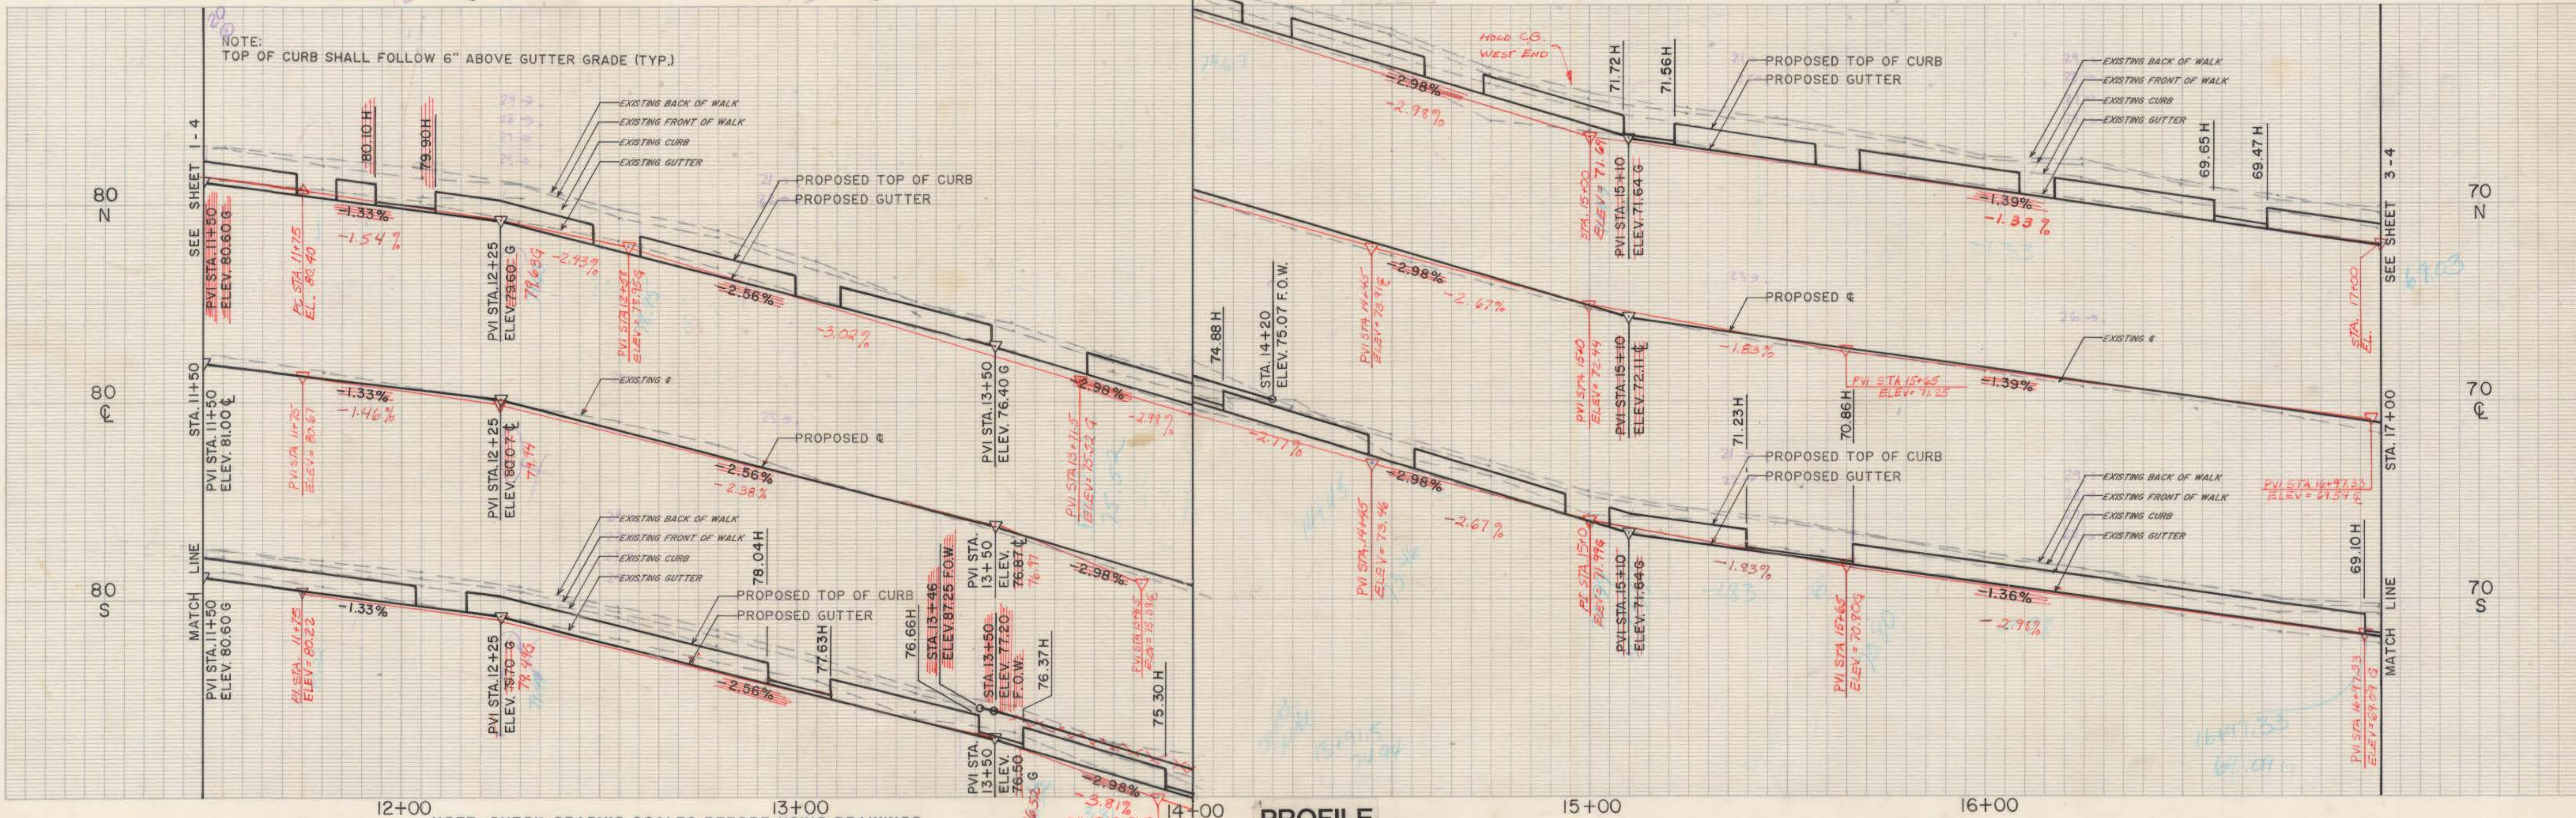


- NOTES:
- INSTALL 6' OF 6"x20" GRANITE CURB ON EACH SIDE OF CATCH BASIN WHERE INSTALLING BITUMINOUS CONCRETE LIP CURBING
 - CONSTRUCT BITUMINOUS CONCRETE DRIVEWAY RAMP
 - CONSTRUCT 8" REINFORCED CONCRETE DRIVEWAY RAMP
 - EXISTING DRIVEWAY RAMP TO REMAIN
- CALL BEFORE YOU DIG - THE CONTRACTOR IS HEREBY REMINDED THAT TITLE 16 CHAPTER 293 OF THE CONNECTICUT GENERAL STATUTES REQUIRES NOTIFICATION TO UTILITY COMPANIES OF PENDING EXCAVATION AT OR NEAR PUBLIC UTILITIES. THE CONTRACTOR SHALL CALL 1-800-922-4455 AT LEAST 48 HOURS PRIOR TO EXCAVATION.

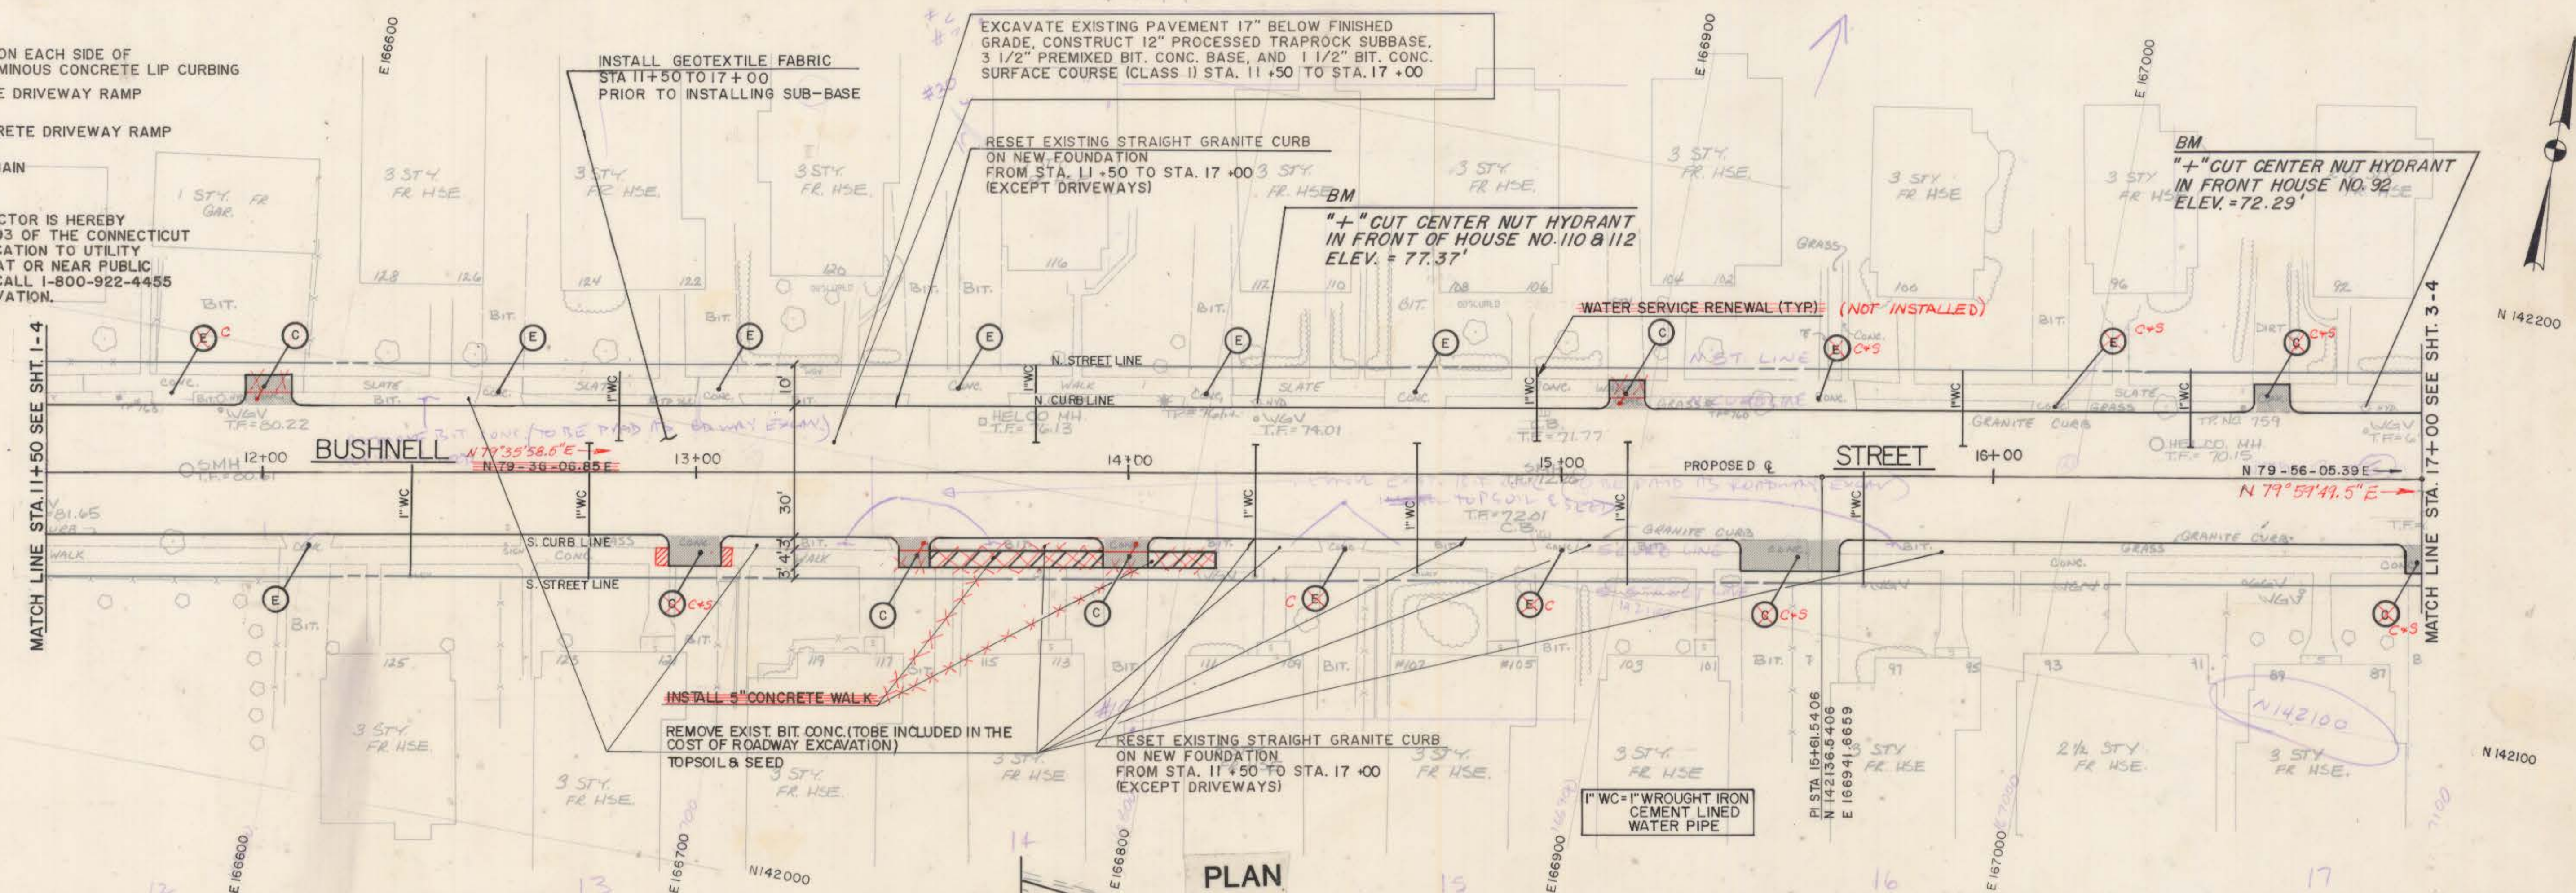

REVISIONS		DESCRIPTION
NO.	DATE	
1	6/3/18	DESIGN BY ARW, BLDH/AEC, DRAWN BY FB, ERF, CHECKED BY JAC, DATE 6/3/18

SUPV. ARW
DESIGN BLDH/AEC
DRAWN FB, ERF
CHECKED JAC
DATE 6/3/18

GRAPHIC SCALES
HORIZ. 1"=20'
VERT. 1"=2'

ROADWAY RECONSTRUCTION
HARTFORD, CONNECTICUT



Hayden Wegman
Consulting Engineers
WEST HARTFORD
NEW YORK • BOSTON • BUFFALO
ATLANTA • MEMPHIS

CITY OF HARTFORD, CONNECTICUT
DEPARTMENT OF PUBLIC WORKS
BUREAU OF ENGINEERING SERVICES

BUSHNELL STREET
STA. 11+50 TO STA. 17+00
PLAN AND PROFILE
SHEET 2-4
Contract No. E85-28
Job No. 845304