
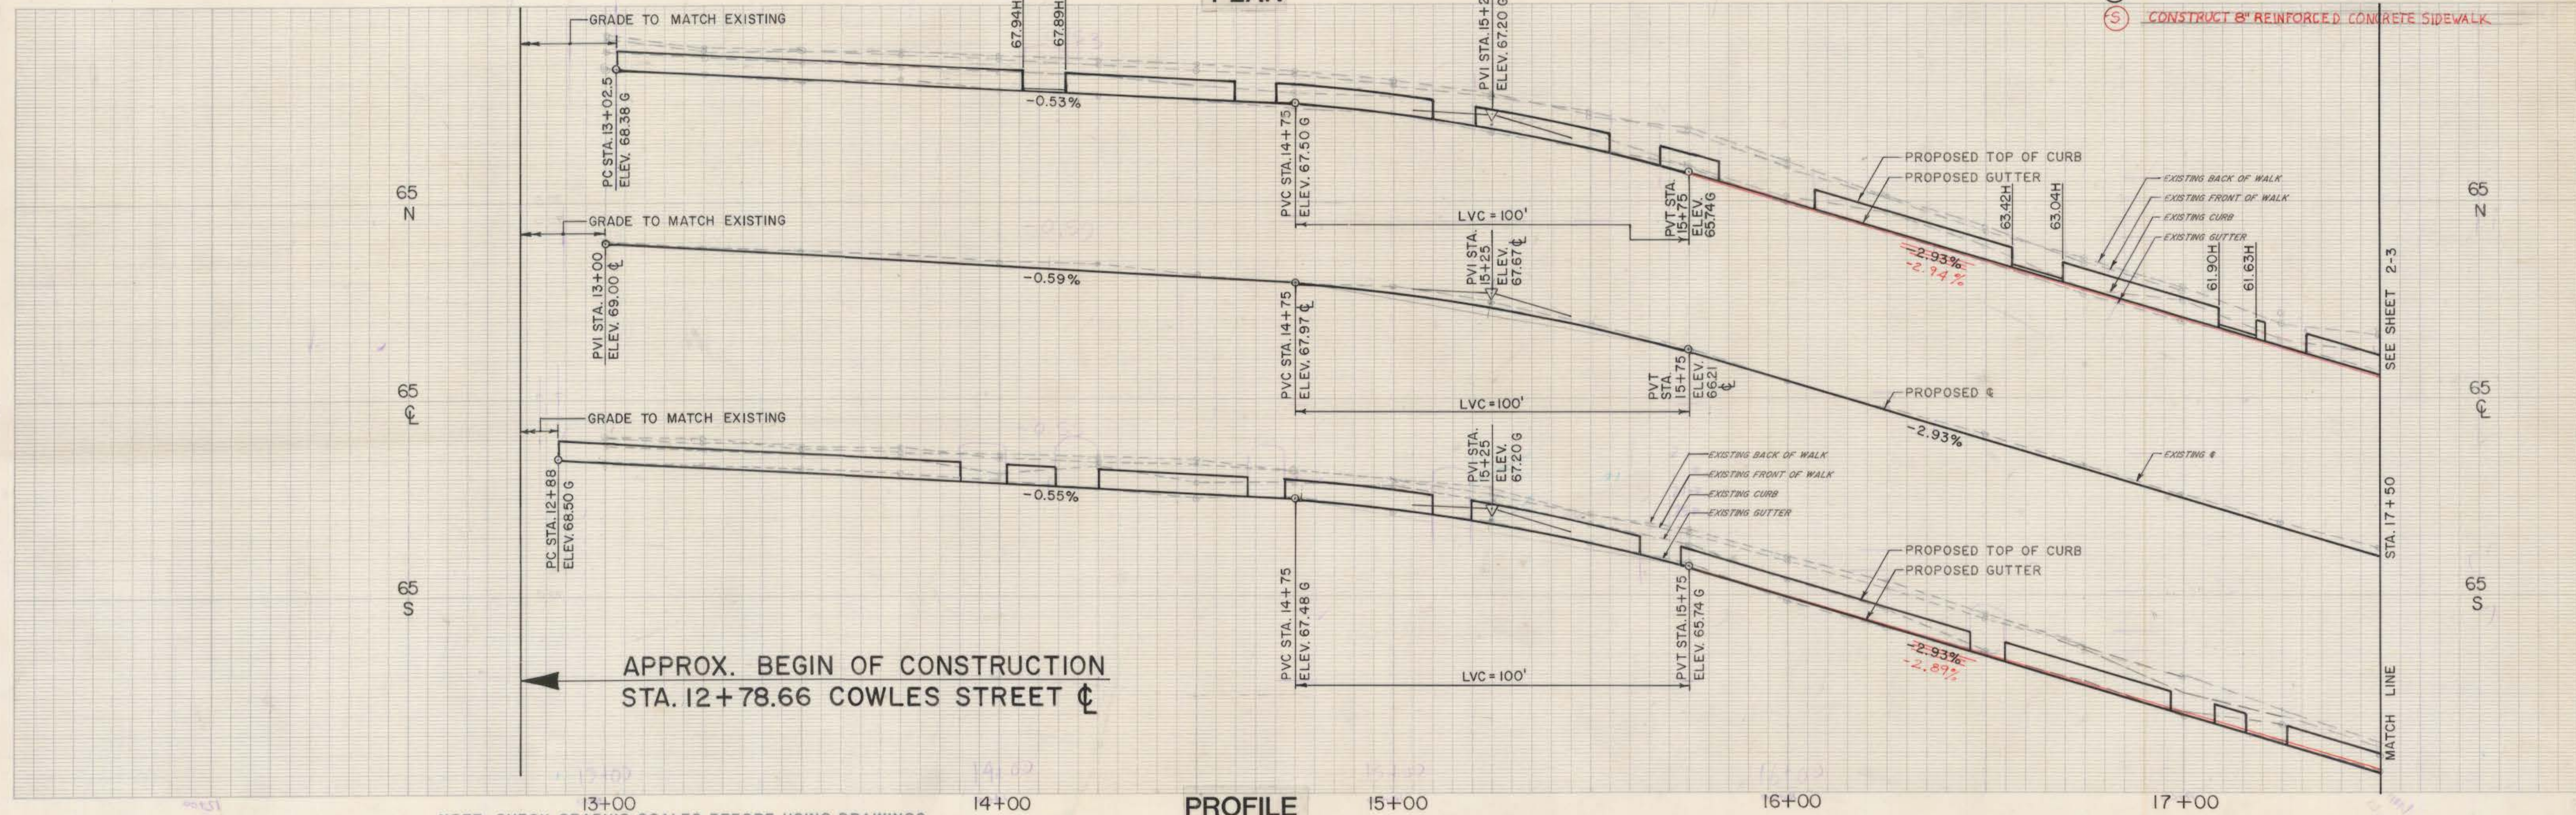


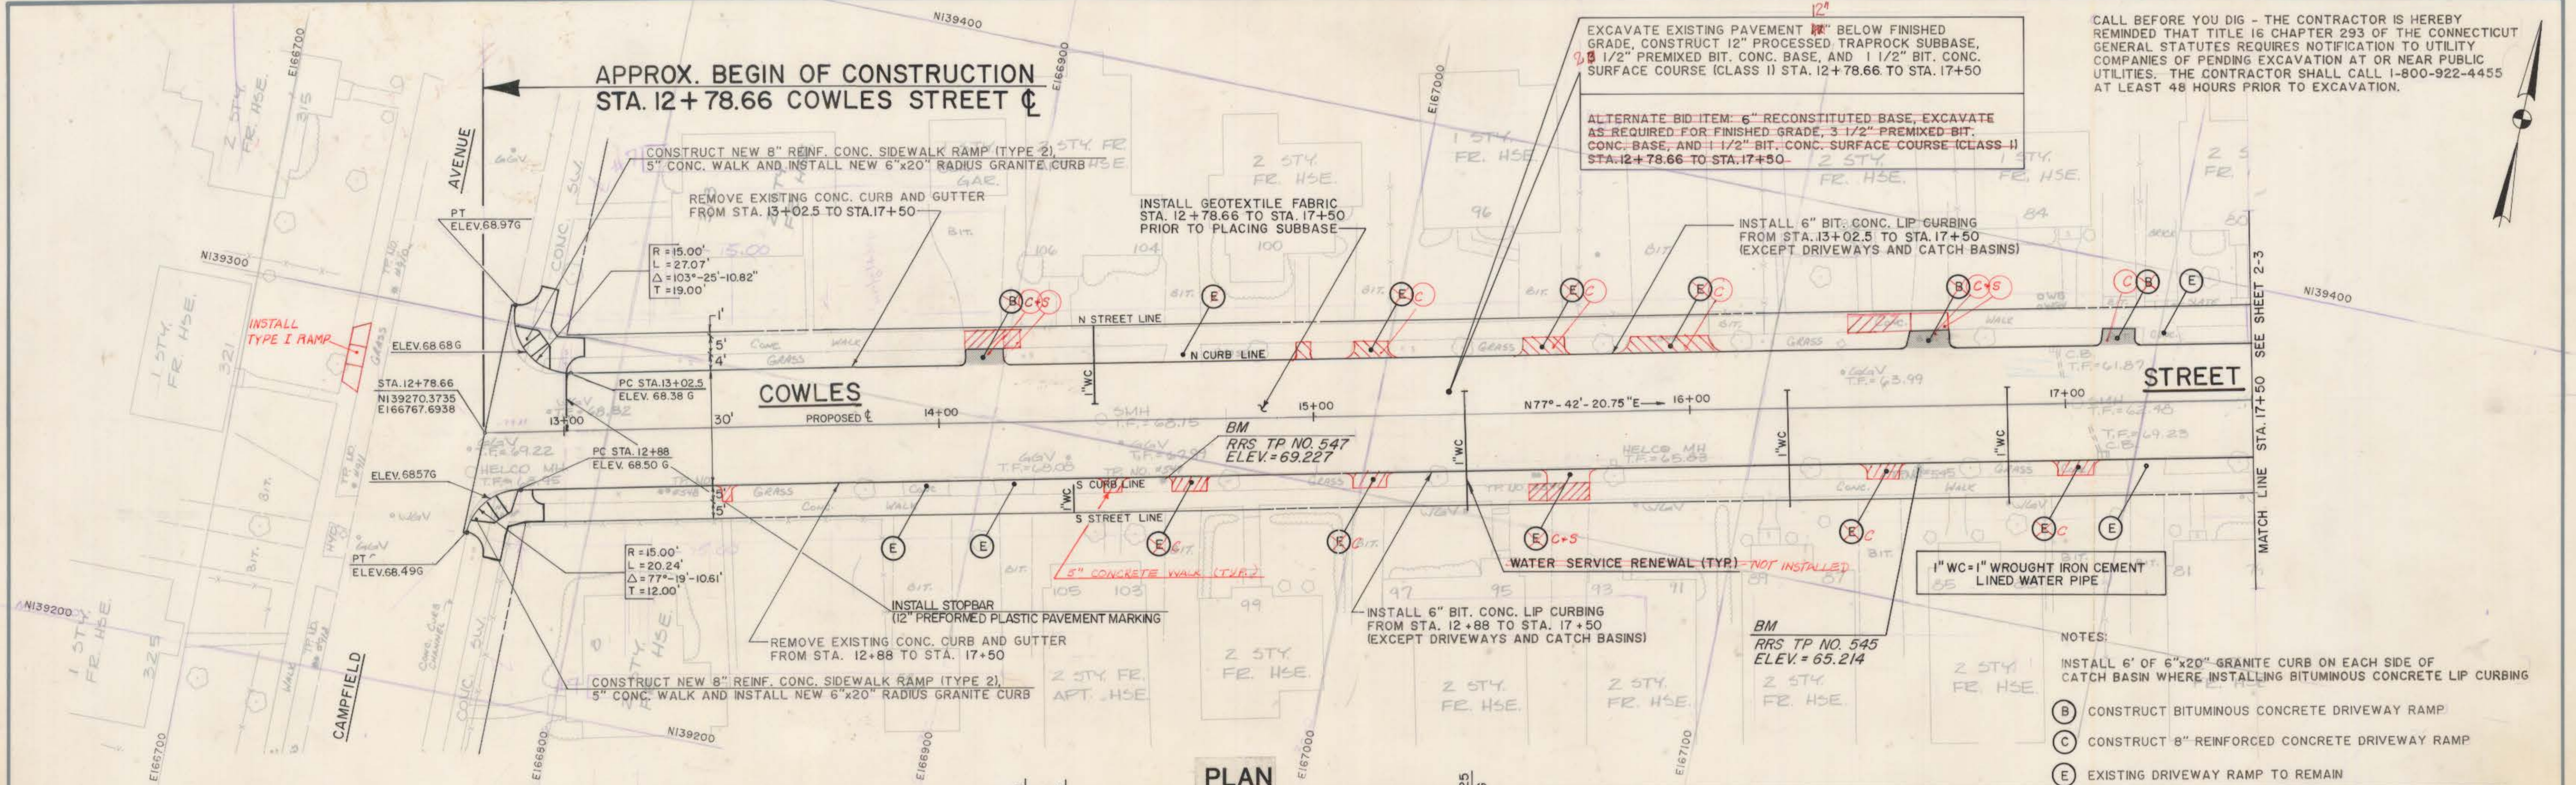

SUPV. ARW		GRAPHIC SCALES		ROADWAY RECONSTRUCTION HARTFORD, CONNECTICUT		CITY OF HARTFORD, CONNECTICUT DEPARTMENT OF PUBLIC WORKS BUREAU OF ENGINEERING SERVICES		COWLES STREET STA. 12+78.66 TO STA. 17+50		PLAN AND PROFILE	
DESIGN MDH/ABC		HORIZ. 1" = 20'		HAYDEN WEGMAN Consulting Engineers		WEST HARTFORD NEW YORK • BOSTON • BUFFALO ATLANTA • MEMPHIS		SCALE		SHEET 1-3	
DRAWN LPT		VERT. 1" = 2'		NO. 10606 REGISTERED PROFESSIONAL ENGINEER				DAYBOOK NO. 010947		Job No. - 845304	
CHECKED JAC								DATE		Contract No. E85-28	
DATE 6-3-15											
REVISIONS											