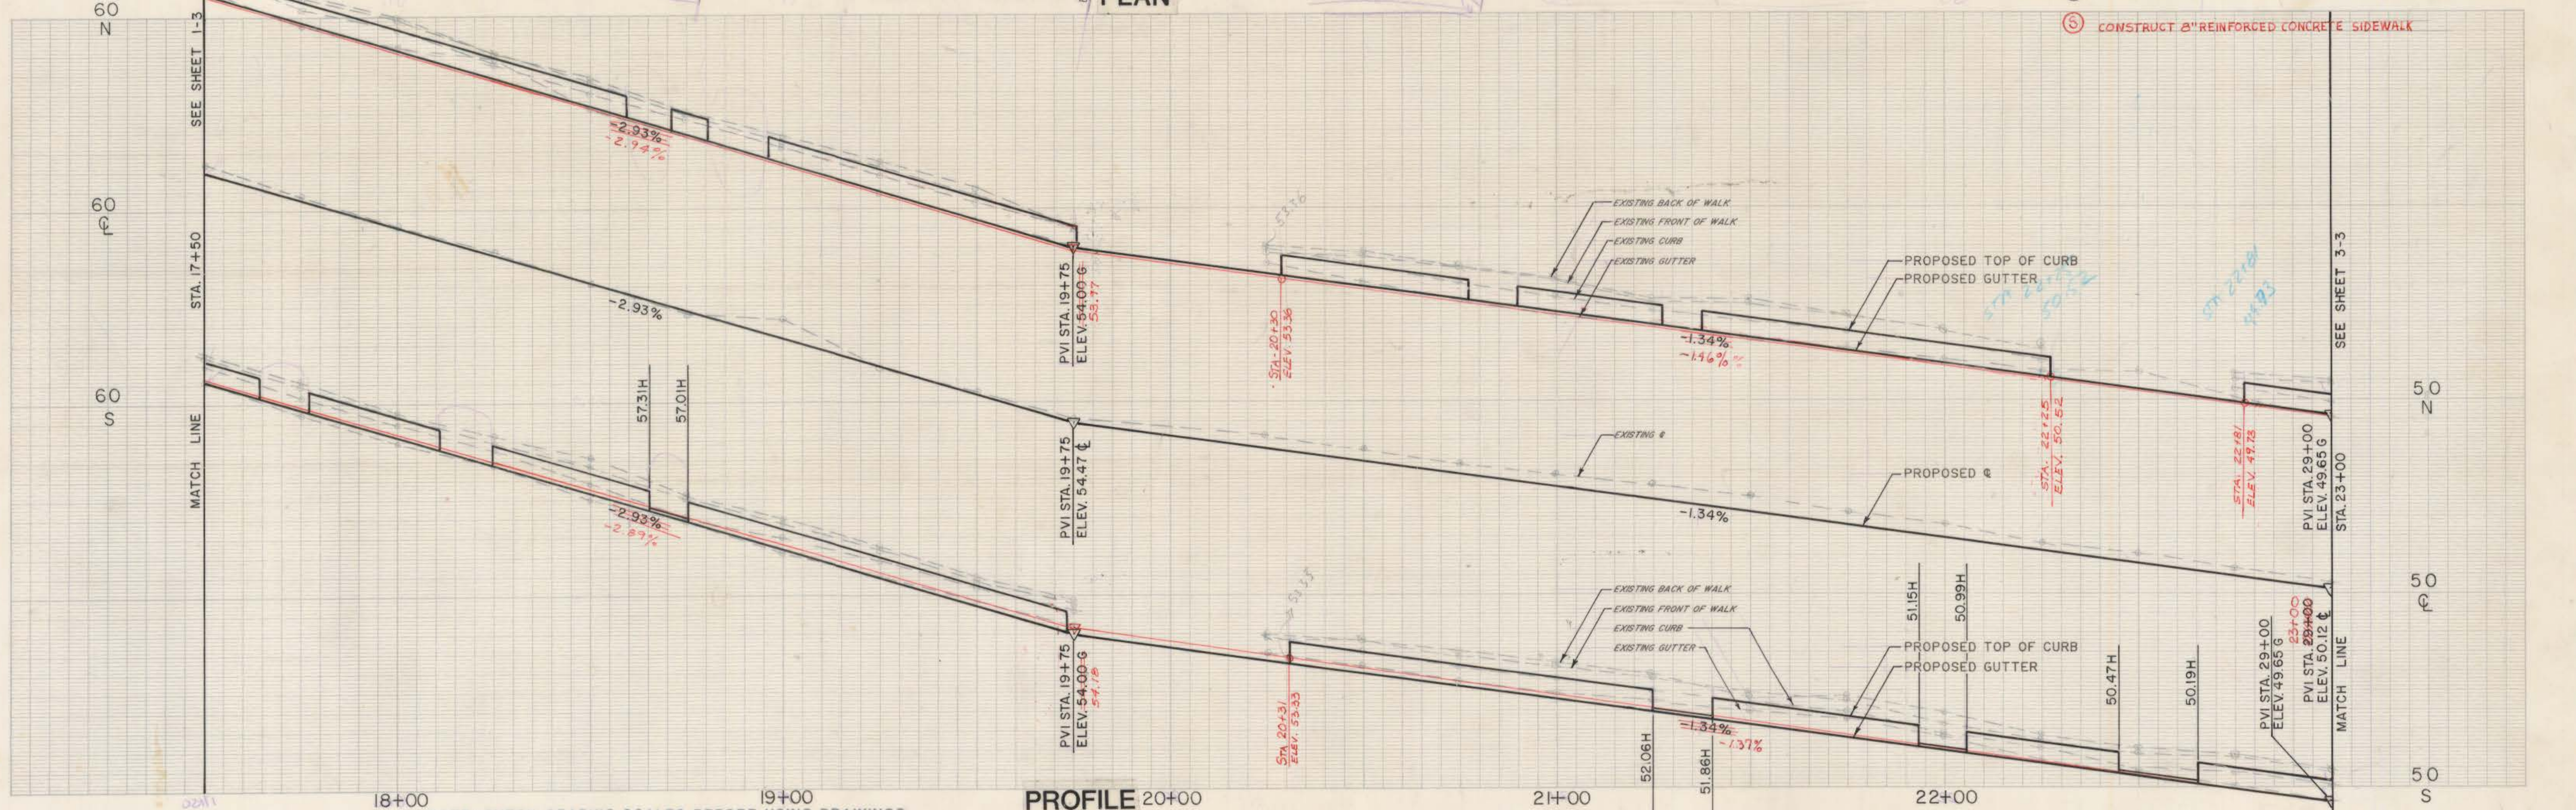
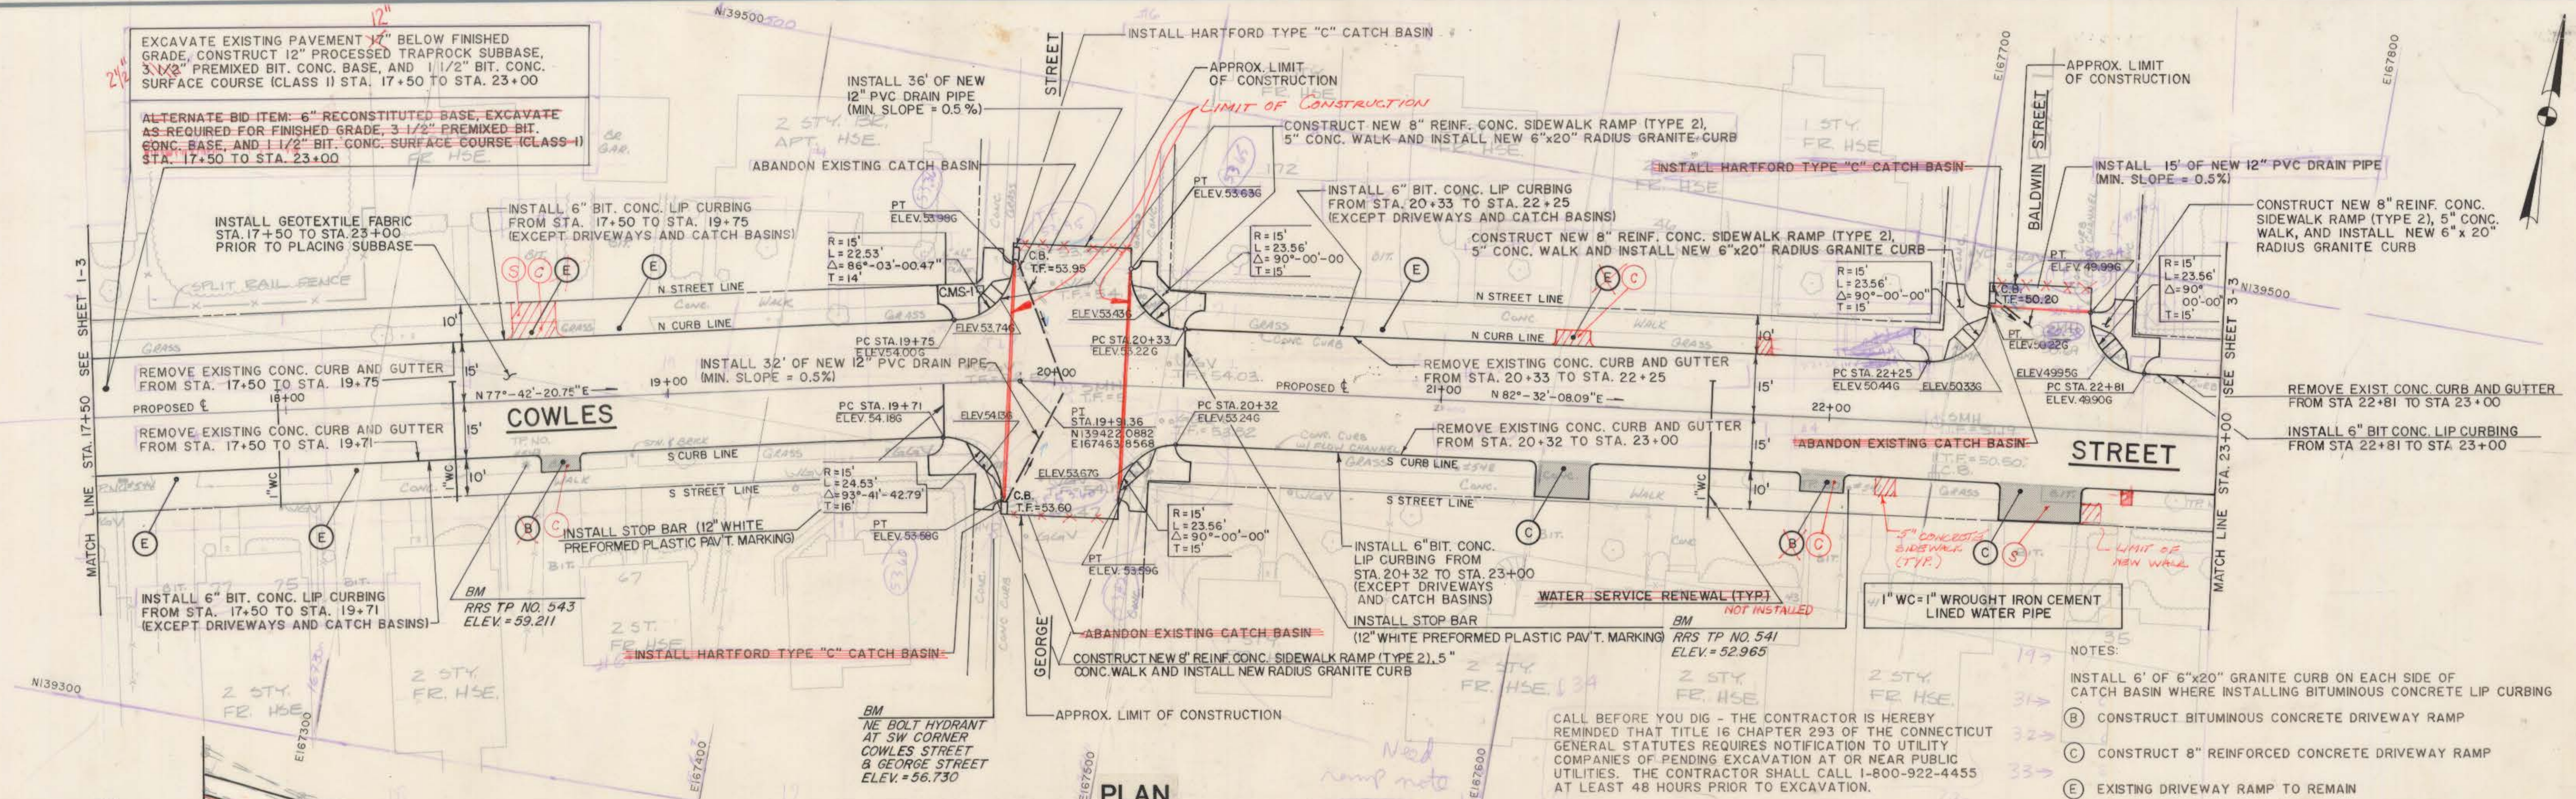


[illegible]

SUPV.	ARW
DESIGN	MOH/AEE
DRAWN	477
CHECKED	✓ MC
DATE	6-3-85

GRAPHIC SCALES

HORIZ. 1" = 20'

VERT. 1" = 2'

ROADWAY RECONSTRUCTION HARTFORD, CONNECTICUT



Hayden | Wegman
Consulting Engineers

WEST HARTFORD
NEW YORK • BOSTON • BUFFALO
ATLANTA • MEMPHIS

CITY OF HARTFORD, CONNECTICUT
DEPARTMENT OF PUBLIC WORKS
BUREAU OF ENGINEERING SERVICES

DRAWN _____	SCALE	DAYBOOK NO. 010947
CHECKED _____		DATE

COWLES STREET

STA. 17+50 TO STA. 23+00

PLAN AND PROFILE

Contract No. E85-28

Job No.- 845304 c

MEET
2-3