
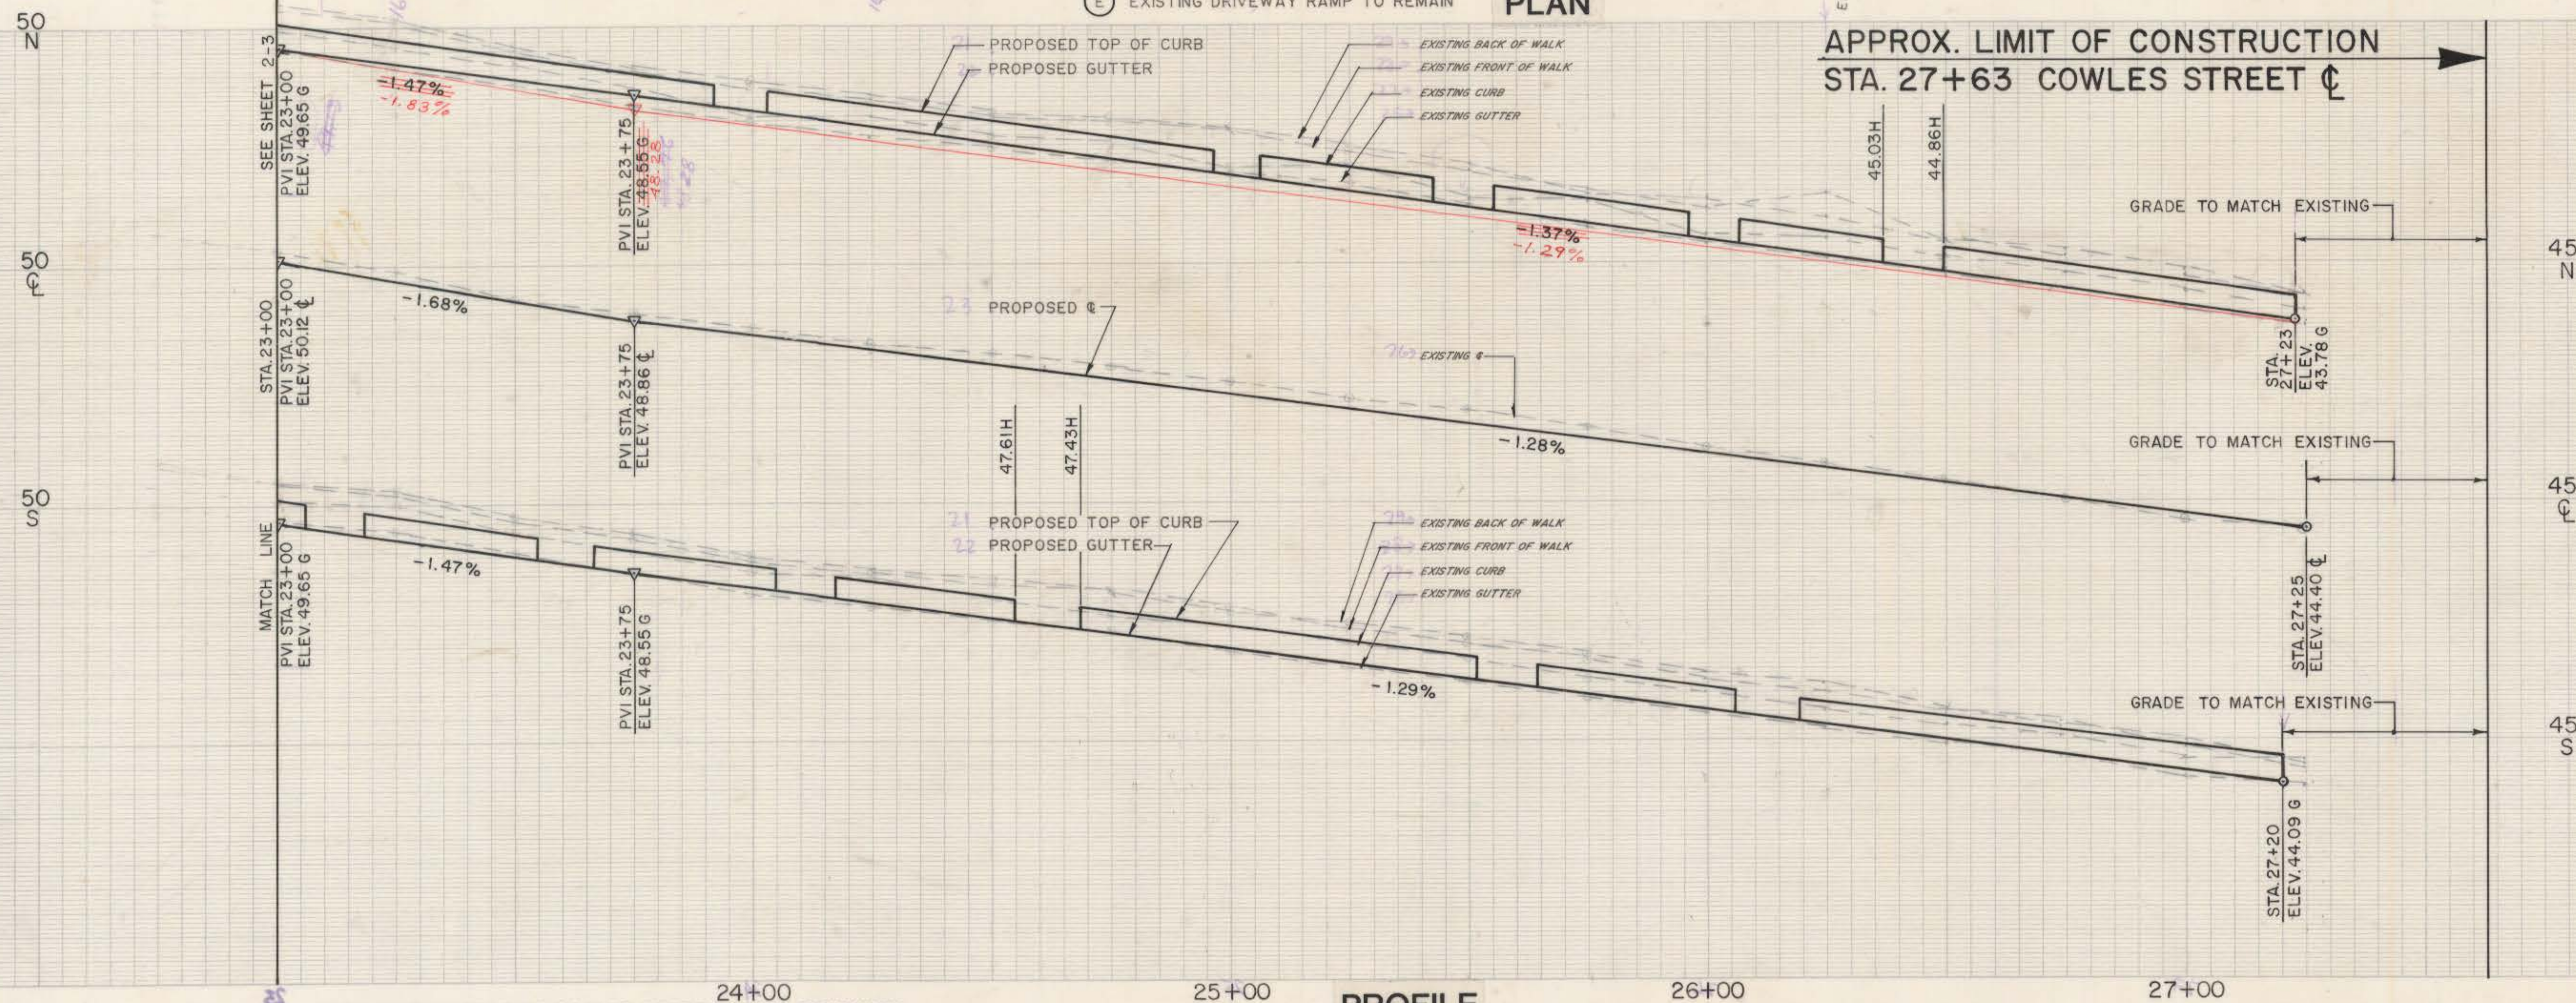


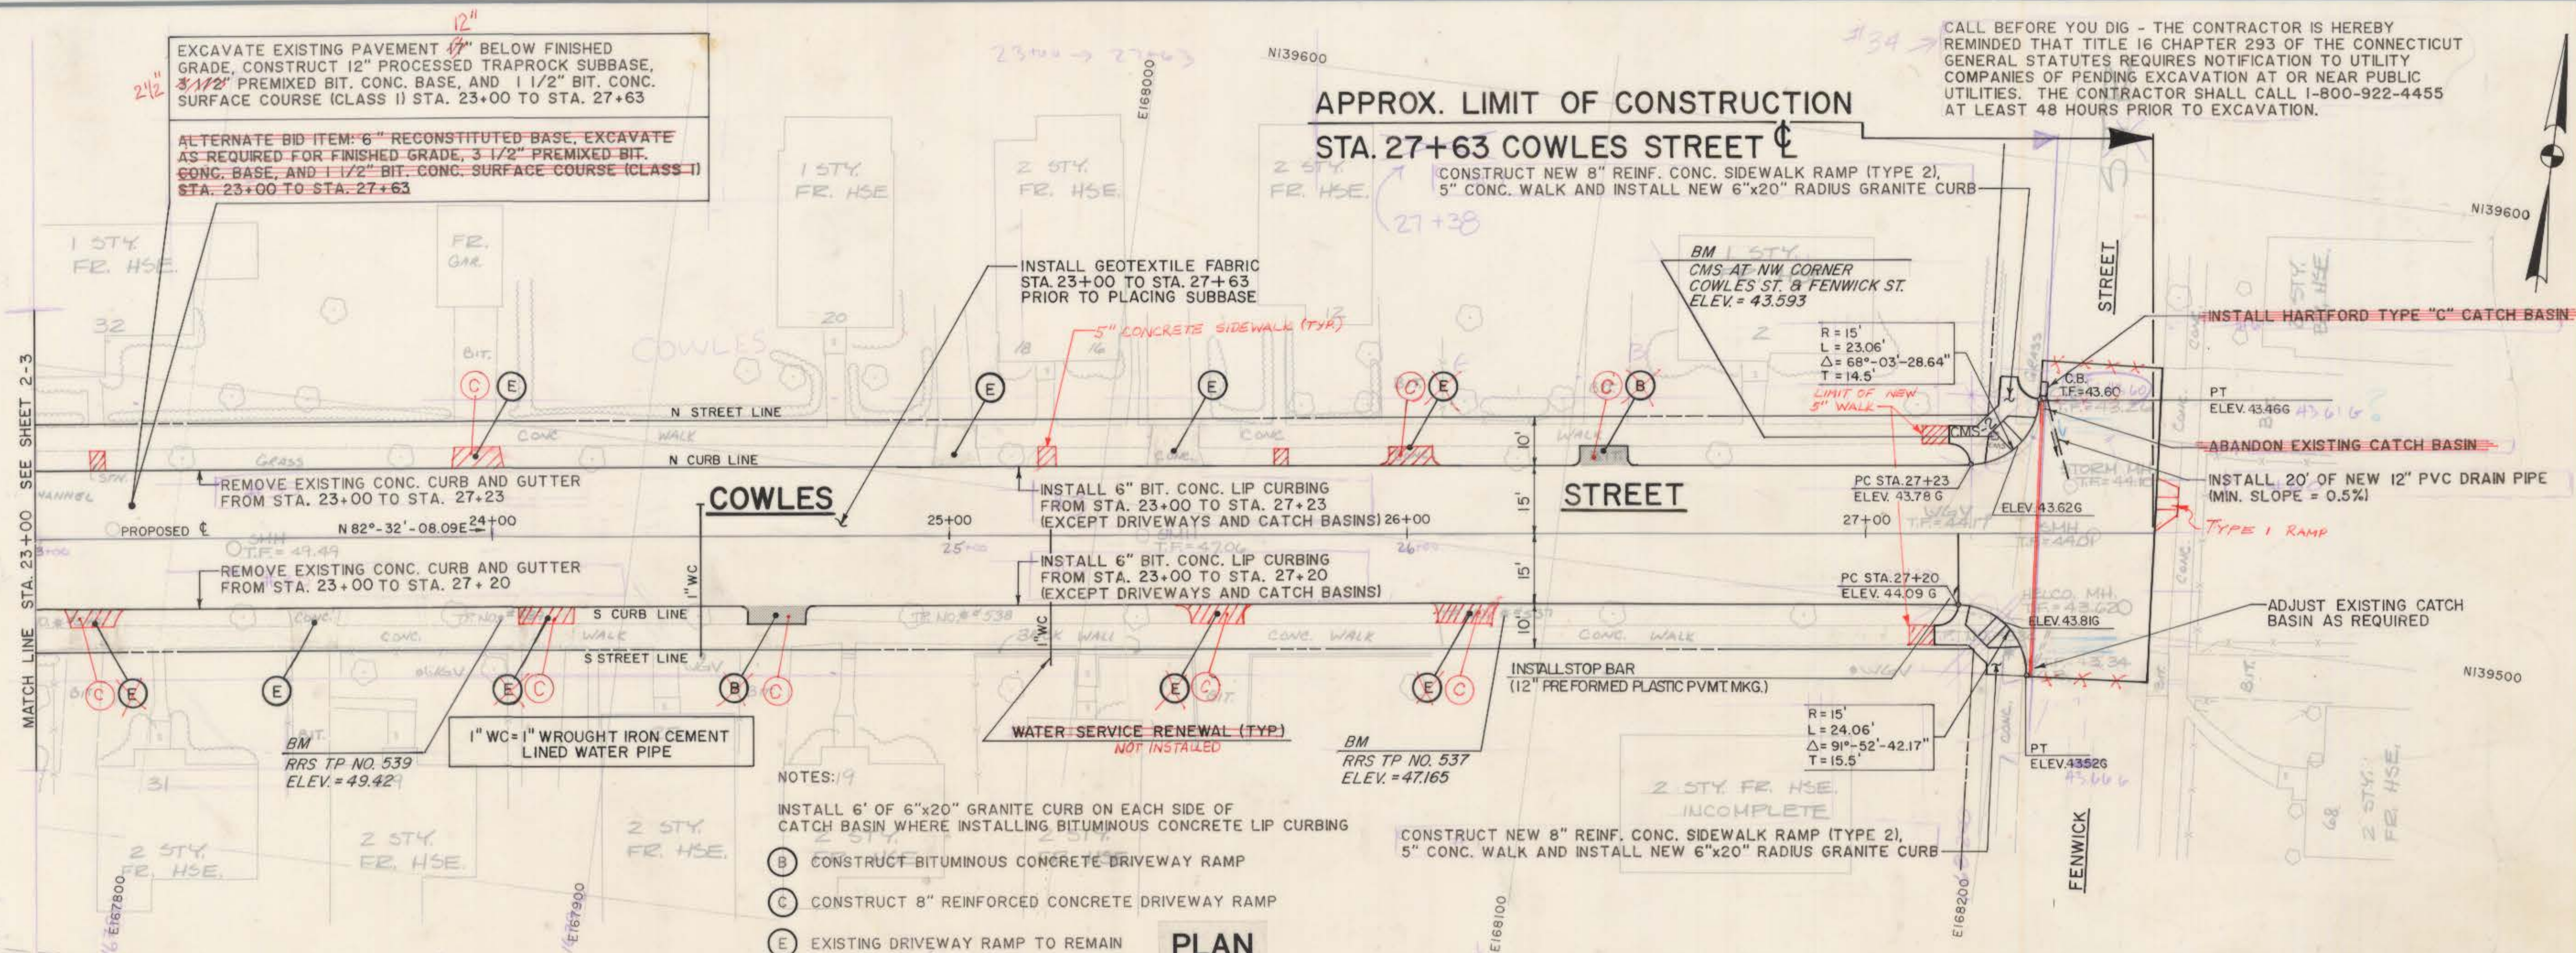

SUPV. ARW

DESIGN MDA AEC

DRAWN JAC

CHECKED JAC

DATE 6-3-85

GRAPHIC SCALES

HORIZ. 1" = 20'

VERT. 1" = 2'

ROADWAY RECONSTRUCTION
HARTFORD, CONNECTICUT



Hayden | Wegman
Consulting Engineers

WEST HARTFORD
NEW YORK • BOSTON • BUFFALO
ATLANTA • MEMPHIS

CITY OF HARTFORD, CONNECTICUT
DEPARTMENT OF PUBLIC WORKS
BUREAU OF ENGINEERING SERVICES

DRAWN: [Signature]
CHECKED: [Signature]

SCALE: [Blank]
DATE: [Blank]

DAYBOOK NO. 010947

COWLES STREET
STA. 23+00 TO STA. 27+63

PLAN AND PROFILE

Contract No. E85-28

Job No. - 845304

SHEET
3-3