
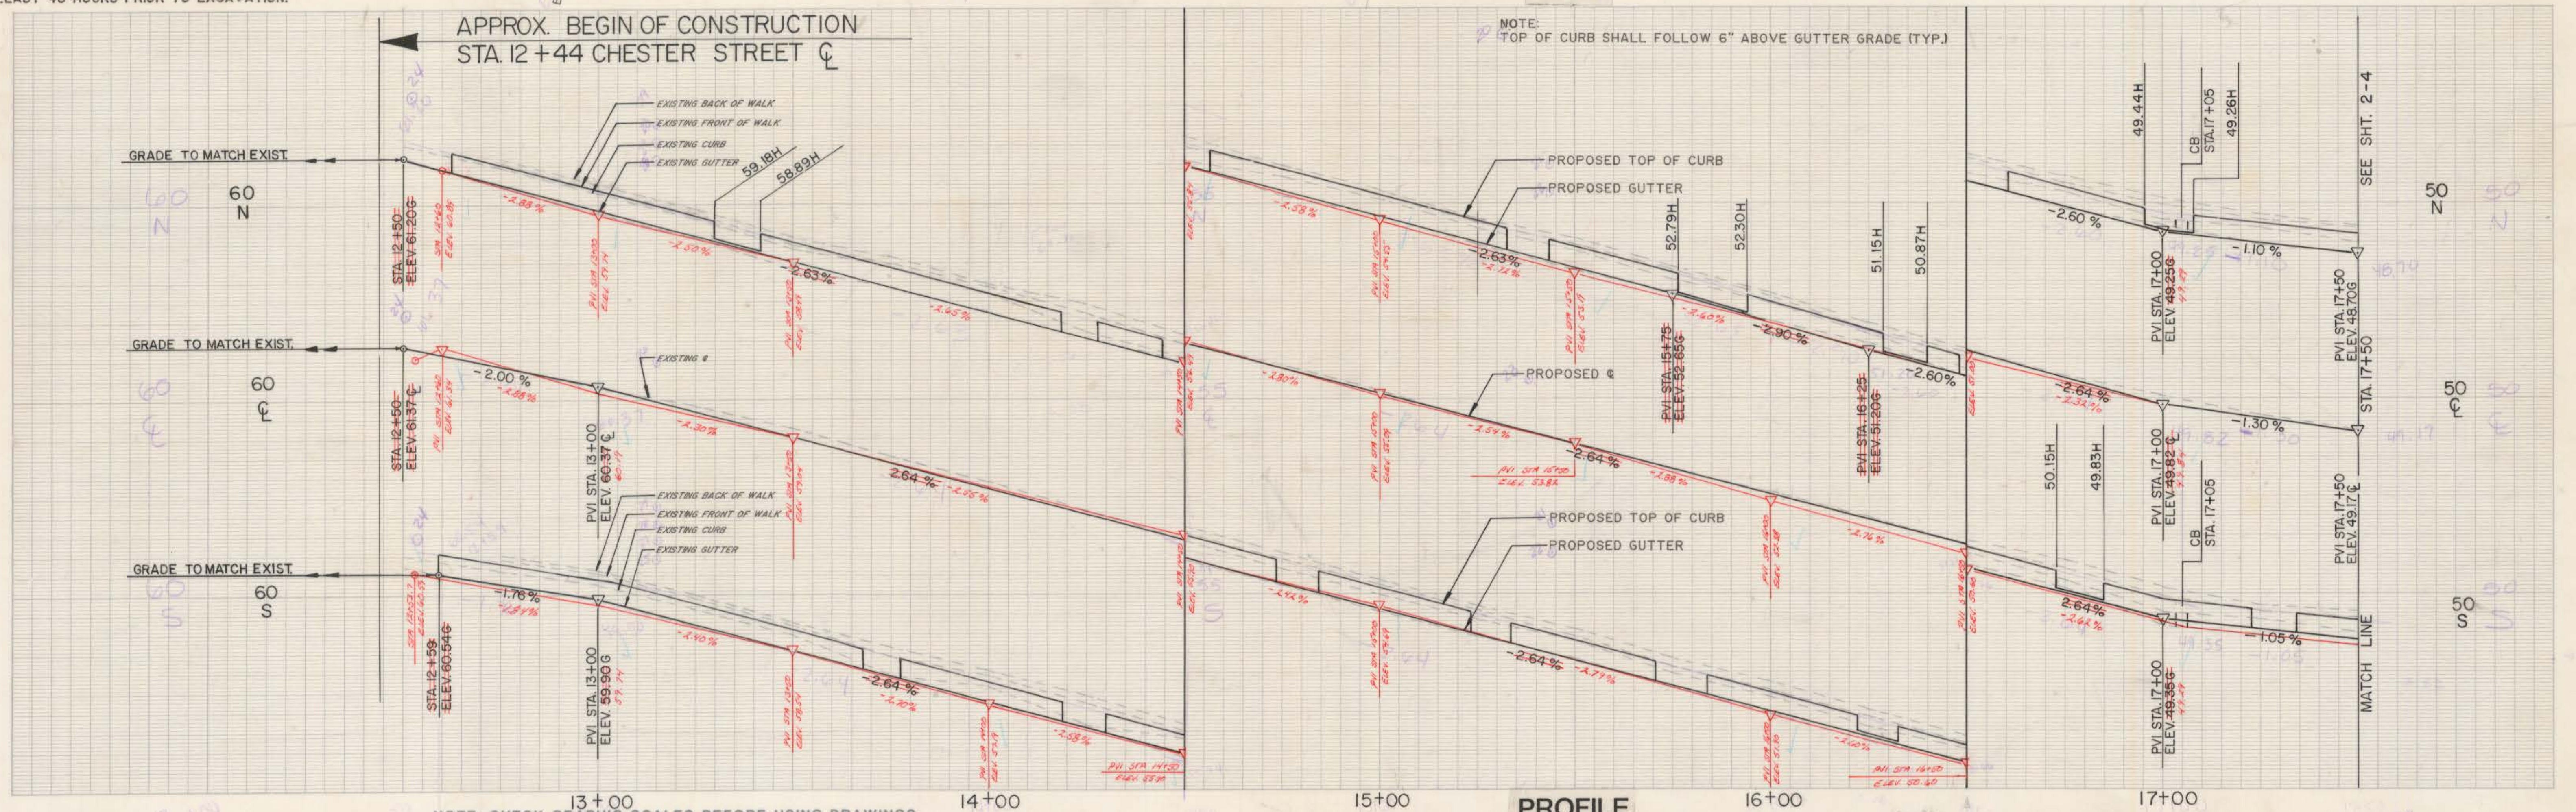


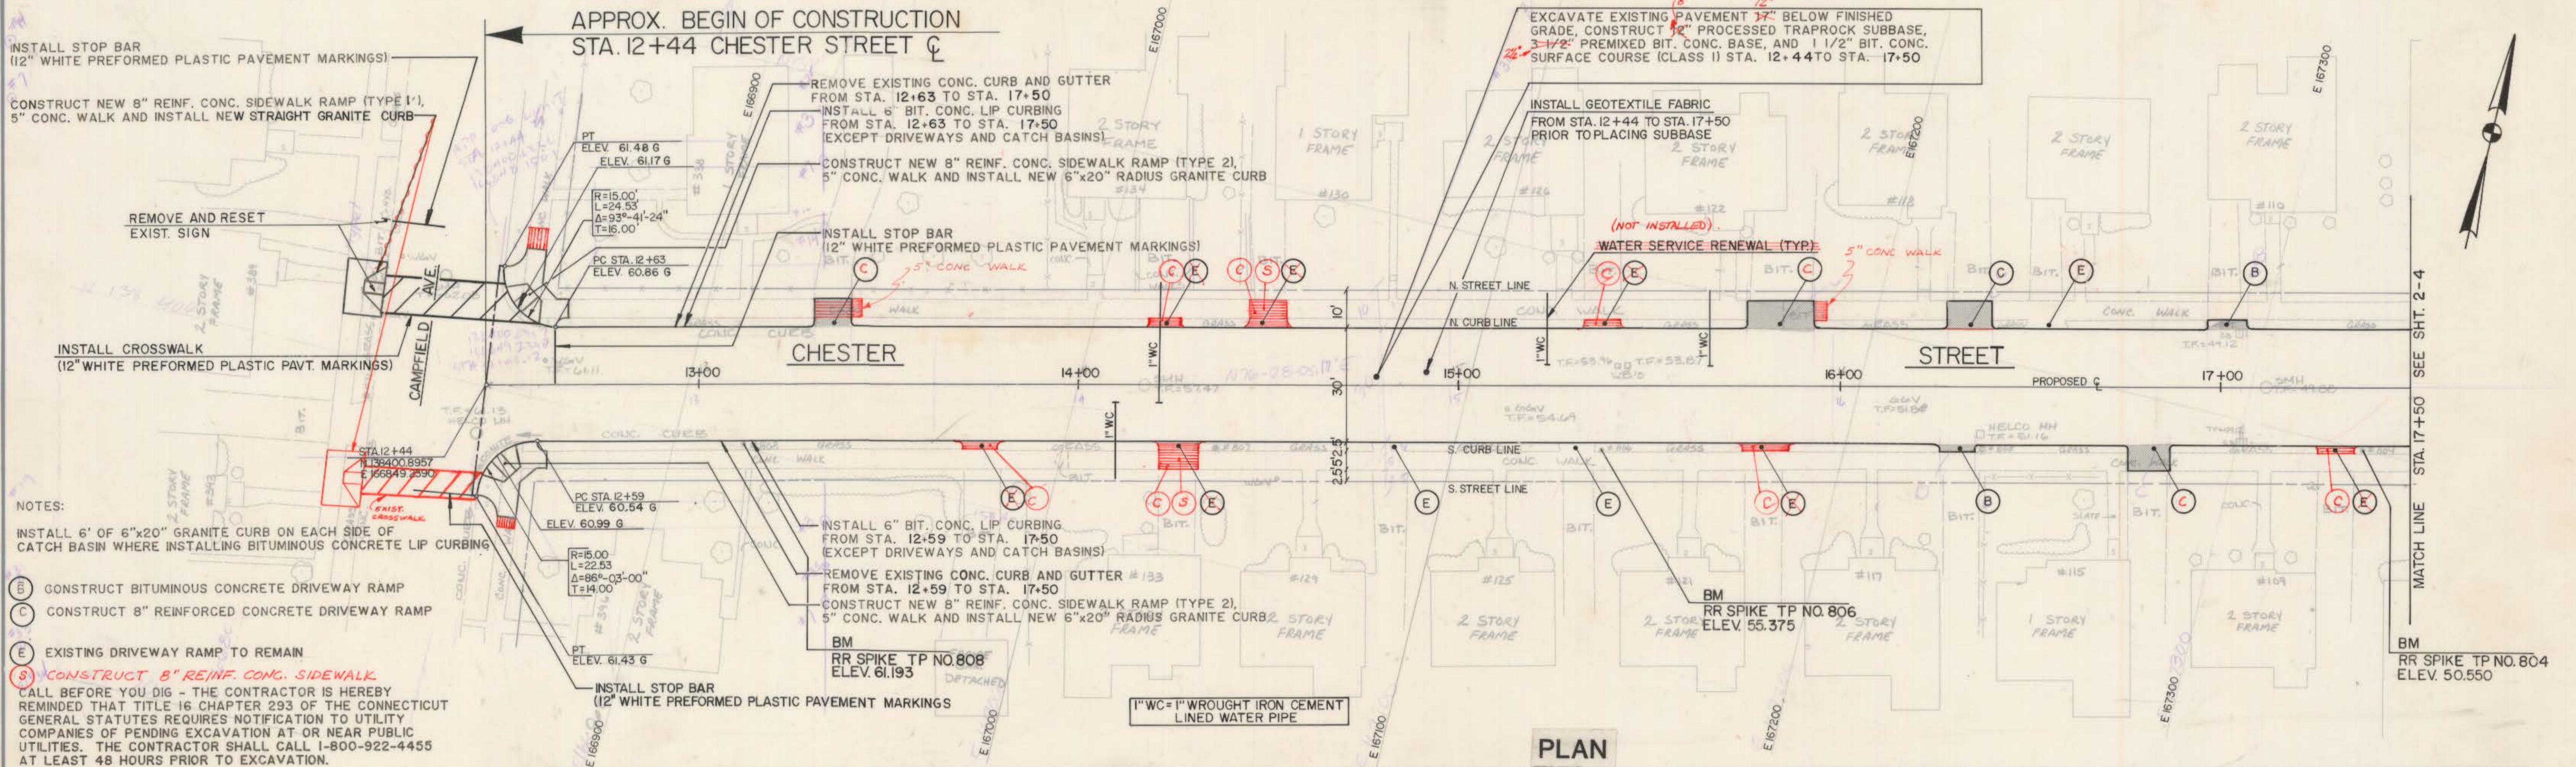

NO. DATE DESCRIPTION REVISIONS		SUPV. <i>AW</i> DESIGN <i>MDH / AHC</i> DRAWN <i>KHT / NF</i> CHECKED <i>UAC</i> DATE <i>6-3-85</i>	GRAPHIC SCALES HORIZ. 1" = 20' VERT. 1" = 2'	ROADWAY RECONSTRUCTION HARTFORD, CONNECTICUT	STATE OF CONNECTICUT ALAN R. WEGMAN REGISTERED PROFESSIONAL ENGINEER NO. 10606	Hayden Wegman Consulting Engineers WEST HARTFORD NEW YORK • BOSTON • BUFFALO ATLANTA • MEMPHIS	CITY OF HARTFORD, CONNECTICUT DEPARTMENT OF PUBLIC WORKS BUREAU OF ENGINEERING SERVICES	CHESTER STREET STA. 12+50 TO STA. 17+50 PLAN AND PROFILE	DRAWN CHECKED SCALE DATE DAYBOOK NO. 010947 Job No. - 845304 Contract No. E85-28 OF 4
--	--	---	---	--	---	---	--	---	---