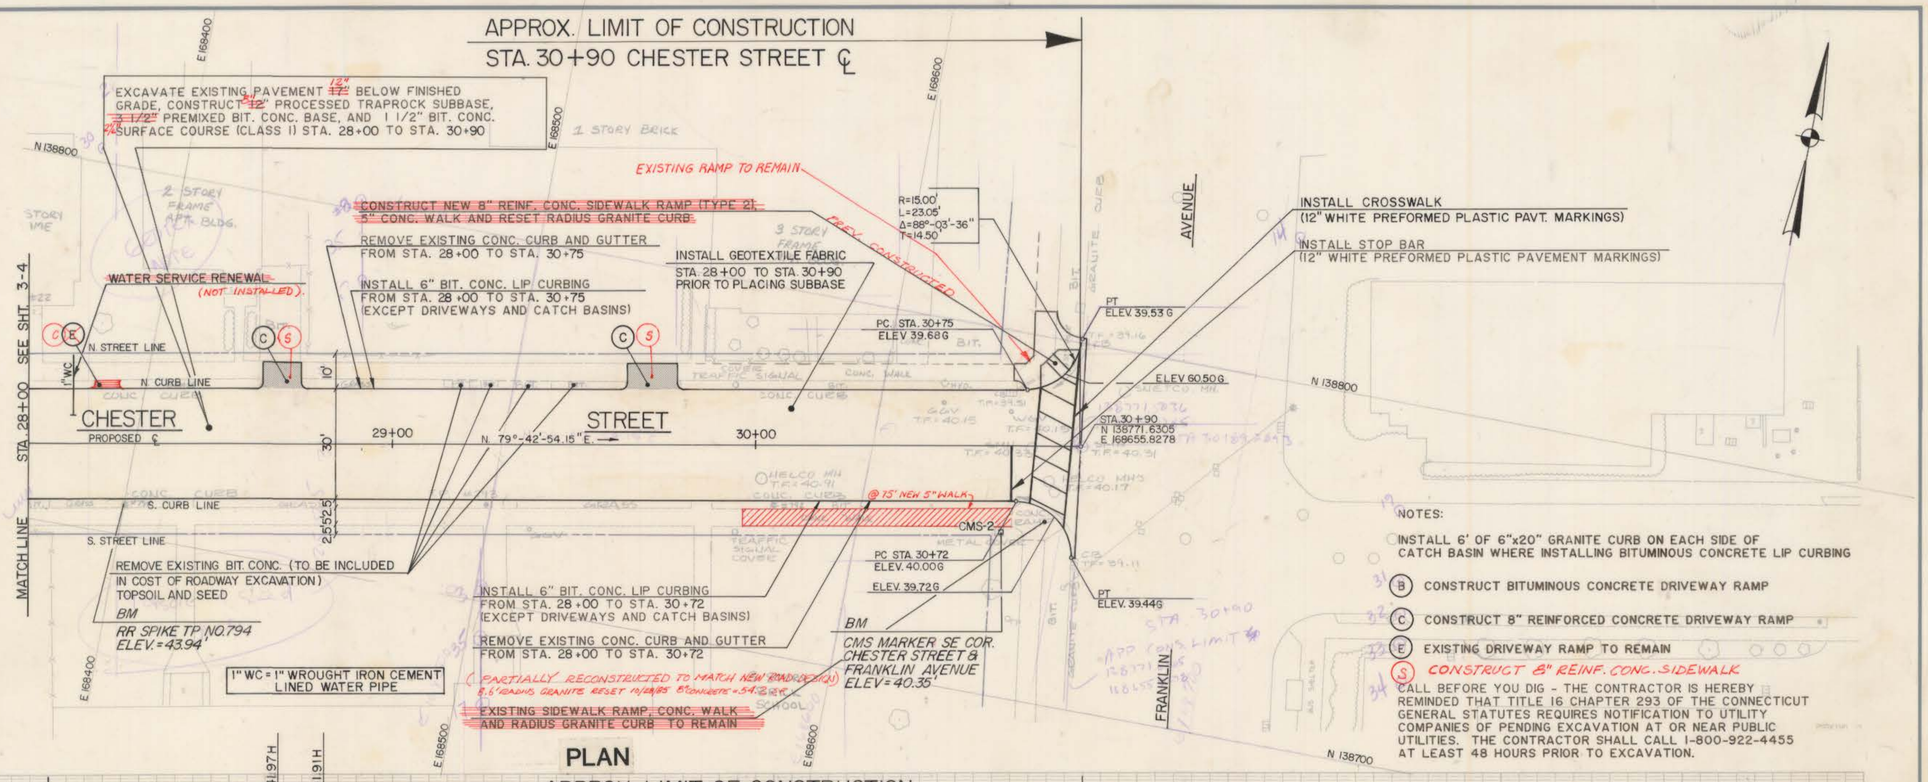

PLAN

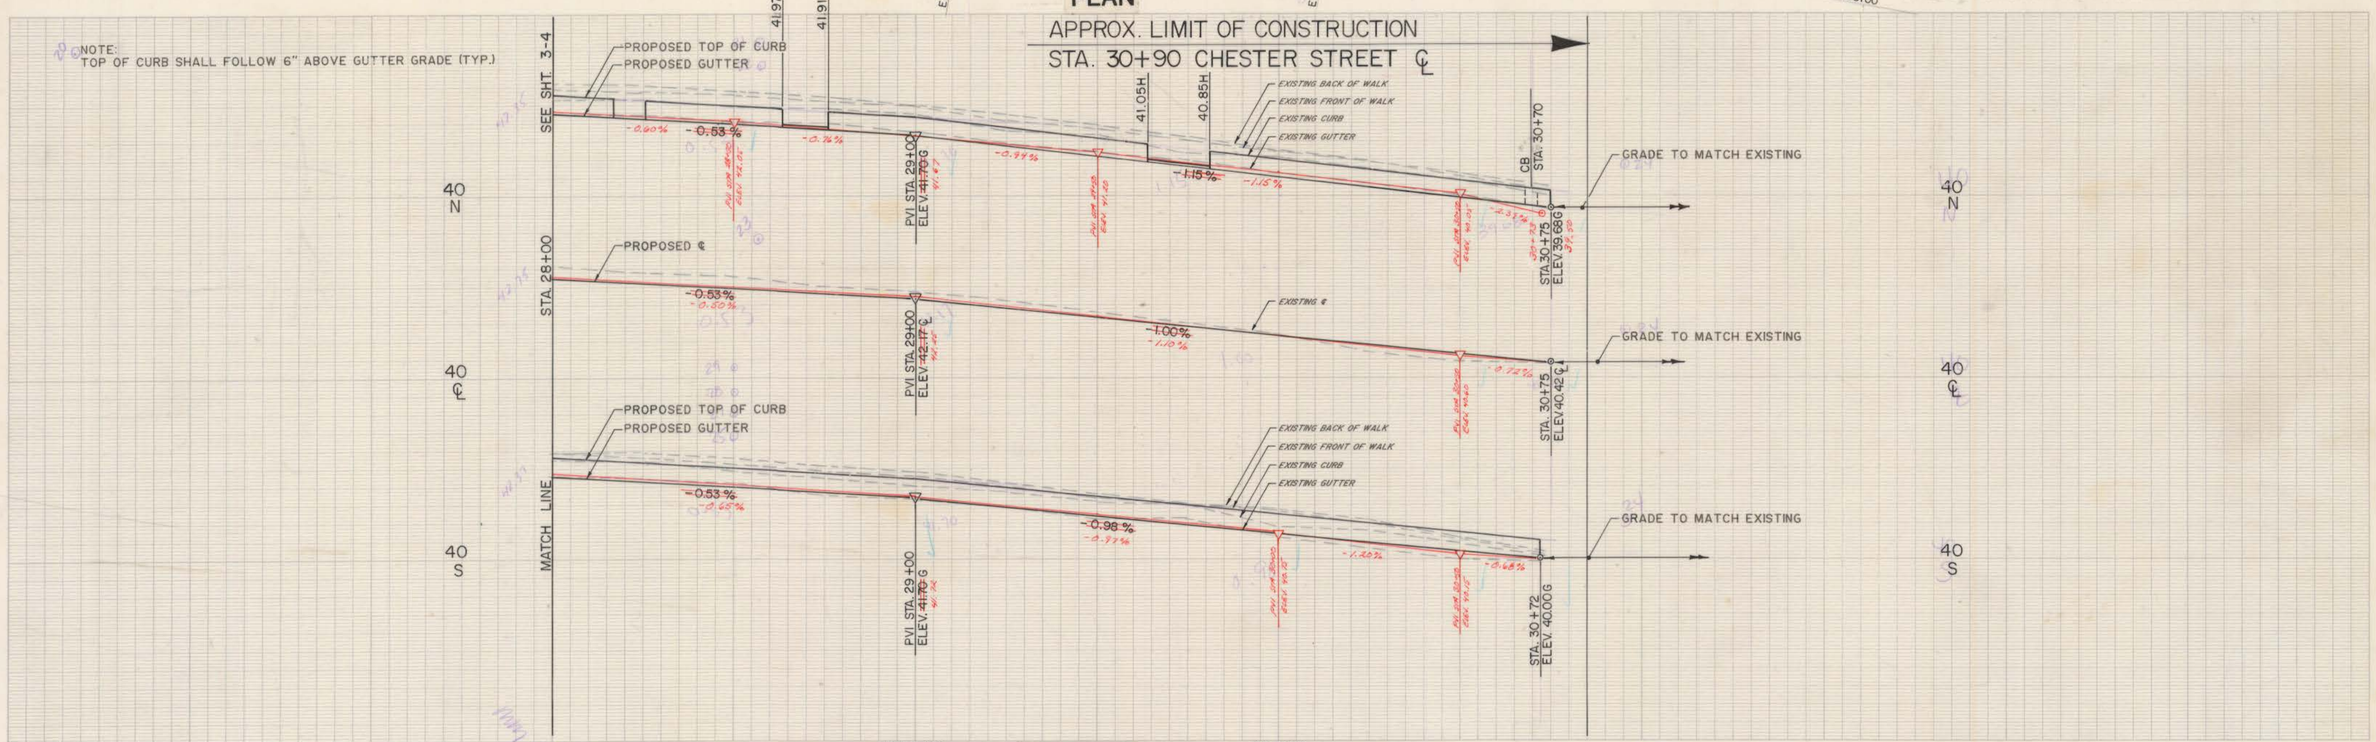

PROFILE

NOTE: CHECK GRAPHIC SCALES BEFORE USING DRAWINGS

NO.	DATE	DESCRIPTION

REVISIONS

SUPV. ARW
DESIGN MDH/AEC
DRAWN KHT
CHECKED JAC
DATE 6-3-95

GRAPHIC SCALES
HORIZ. 1" = 20'
VERT. 1" = 2'

ROADWAY RECONSTRUCTION
HARTFORD, CONNECTICUT

STATE OF CONNECTICUT — PLANS — REGISTERED PROFESSIONAL ENGINEER NO. 10006

Hayden | Wegman
Consulting Engineers
WEST HARTFORD
NEW YORK • BOSTON • BUFFALO
ATLANTA • MEMPHIS

CITY OF HARTFORD, CONNECTICUT
DEPARTMENT OF PUBLIC WORKS
BUREAU OF ENGINEERING SERVICES

DRAWN
CHECKED
SCALE
DAYBOOK NO. 010947
DATE

CHESTER STREET
STA. 28+00 TO STA. 30+90

PLAN AND PROFILE

Contract No. E85-28 Job No.- 845304

SHEET 4-1 OF