
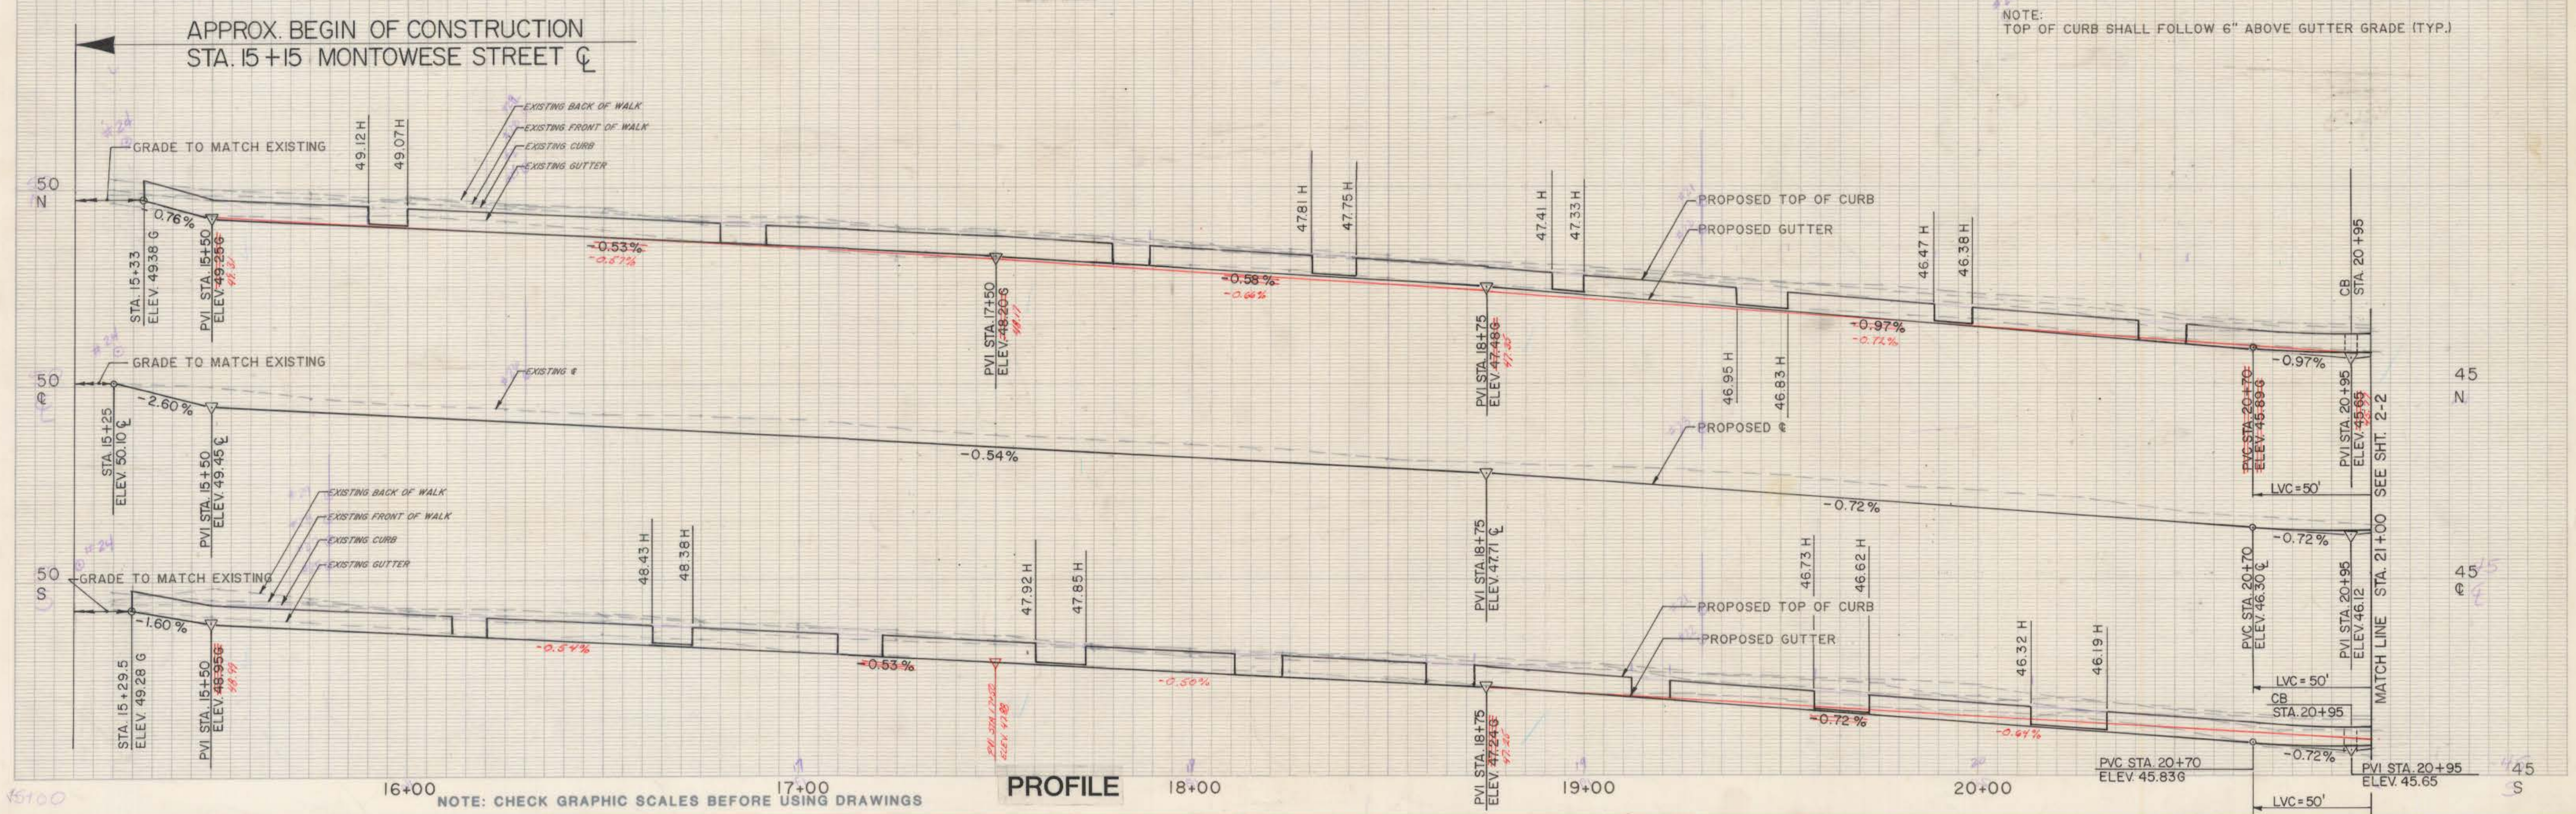


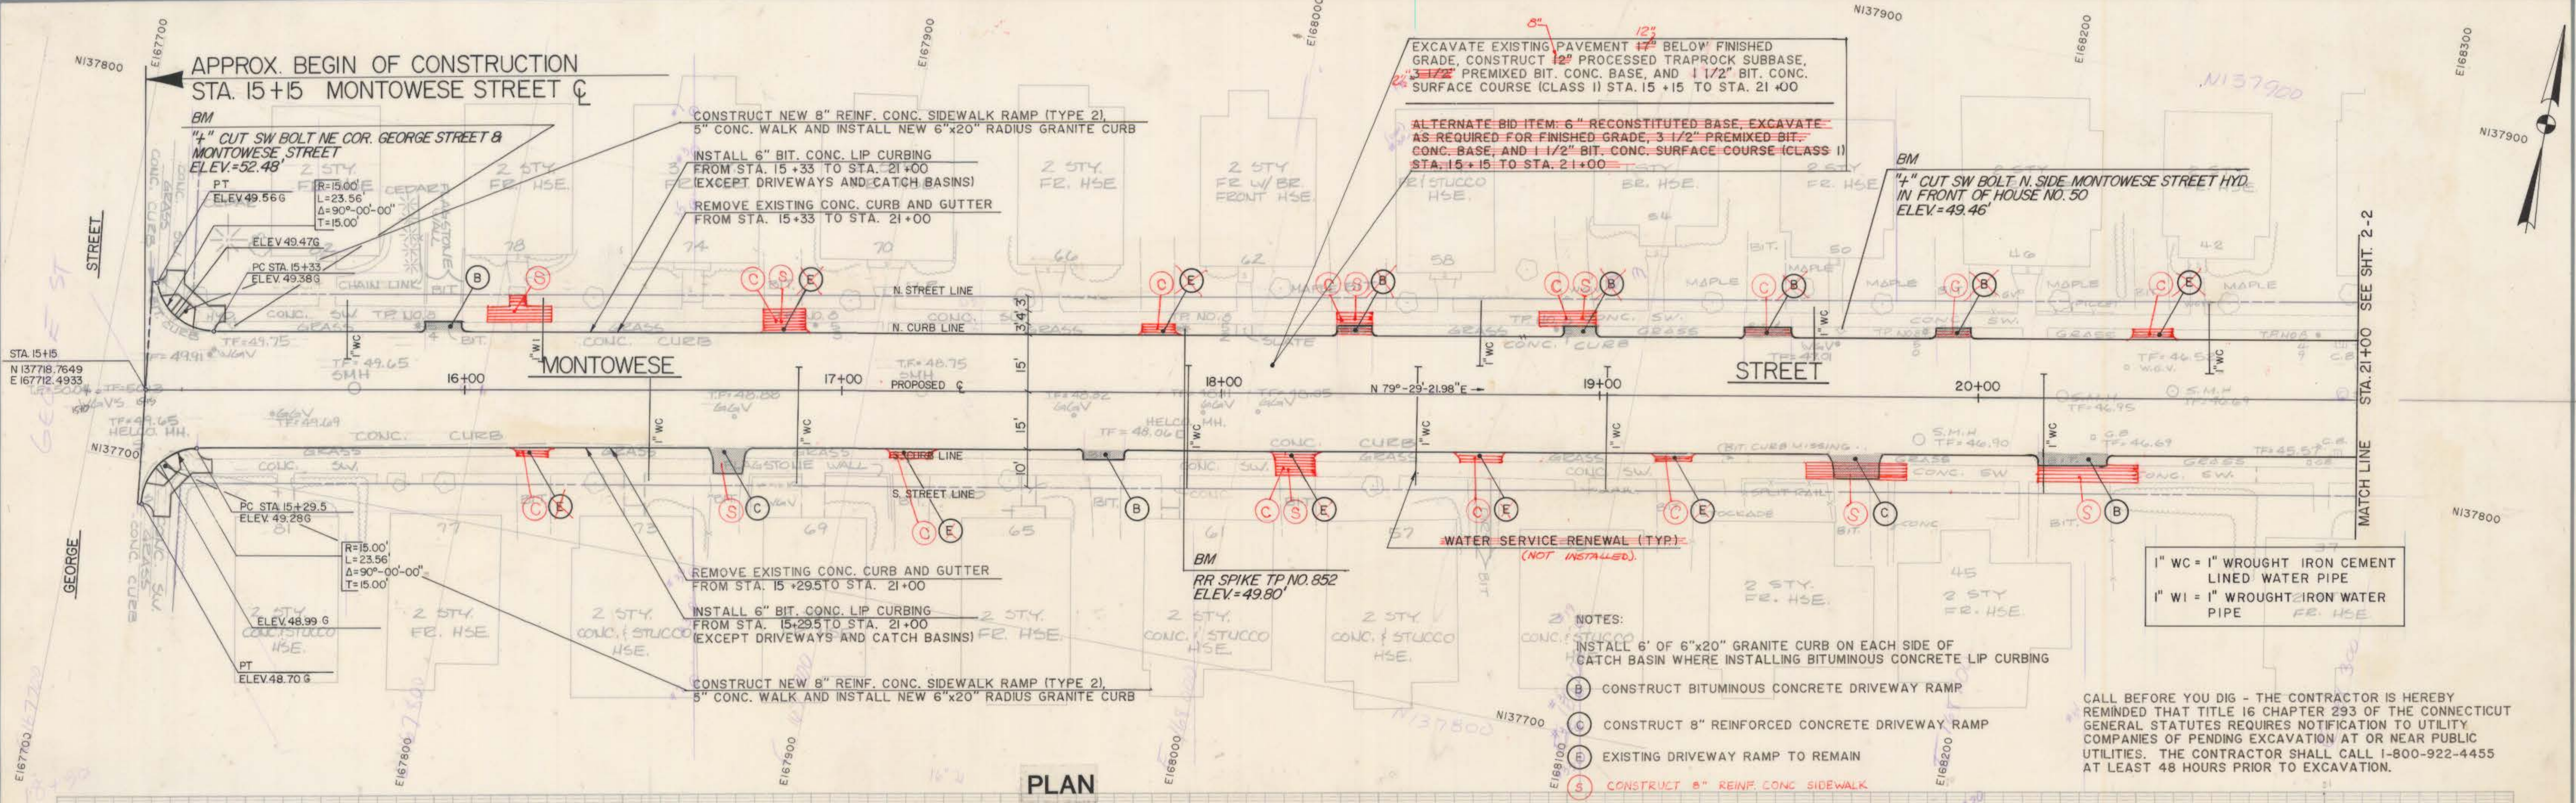

REVISIONS NO. DATE DESCRIPTION 1 1/28/87 As Bldgs - Roadway Reconstruction - (Location & Elevation) 2 6/3/85		SUPV. ARW DESIGN MDH/AEC DRAWN KHT CHECKED JAC DATE 6/3/85		GRAPHIC SCALES HORIZ. 1" = 20' VERT. 1" = 2'		ROADWAY RECONSTRUCTION HARTFORD, CONNECTICUT				Hayden Wegman Consulting Engineers WEST HARTFORD NEW YORK • BOSTON • BUFFALO ATLANTA • MEMPHIS		CITY OF HARTFORD, CONNECTICUT DEPARTMENT OF PUBLIC WORKS BUREAU OF ENGINEERING SERVICES		MONTOWESE STREET STA. 15+15 TO STA. 21+00 PLAN AND PROFILE Contract No. E85-28 Job No. 845304		SHEET 1-2	
--	--	---	--	---	--	---	--	--	--	---	--	--	--	--	--	------------------	--