
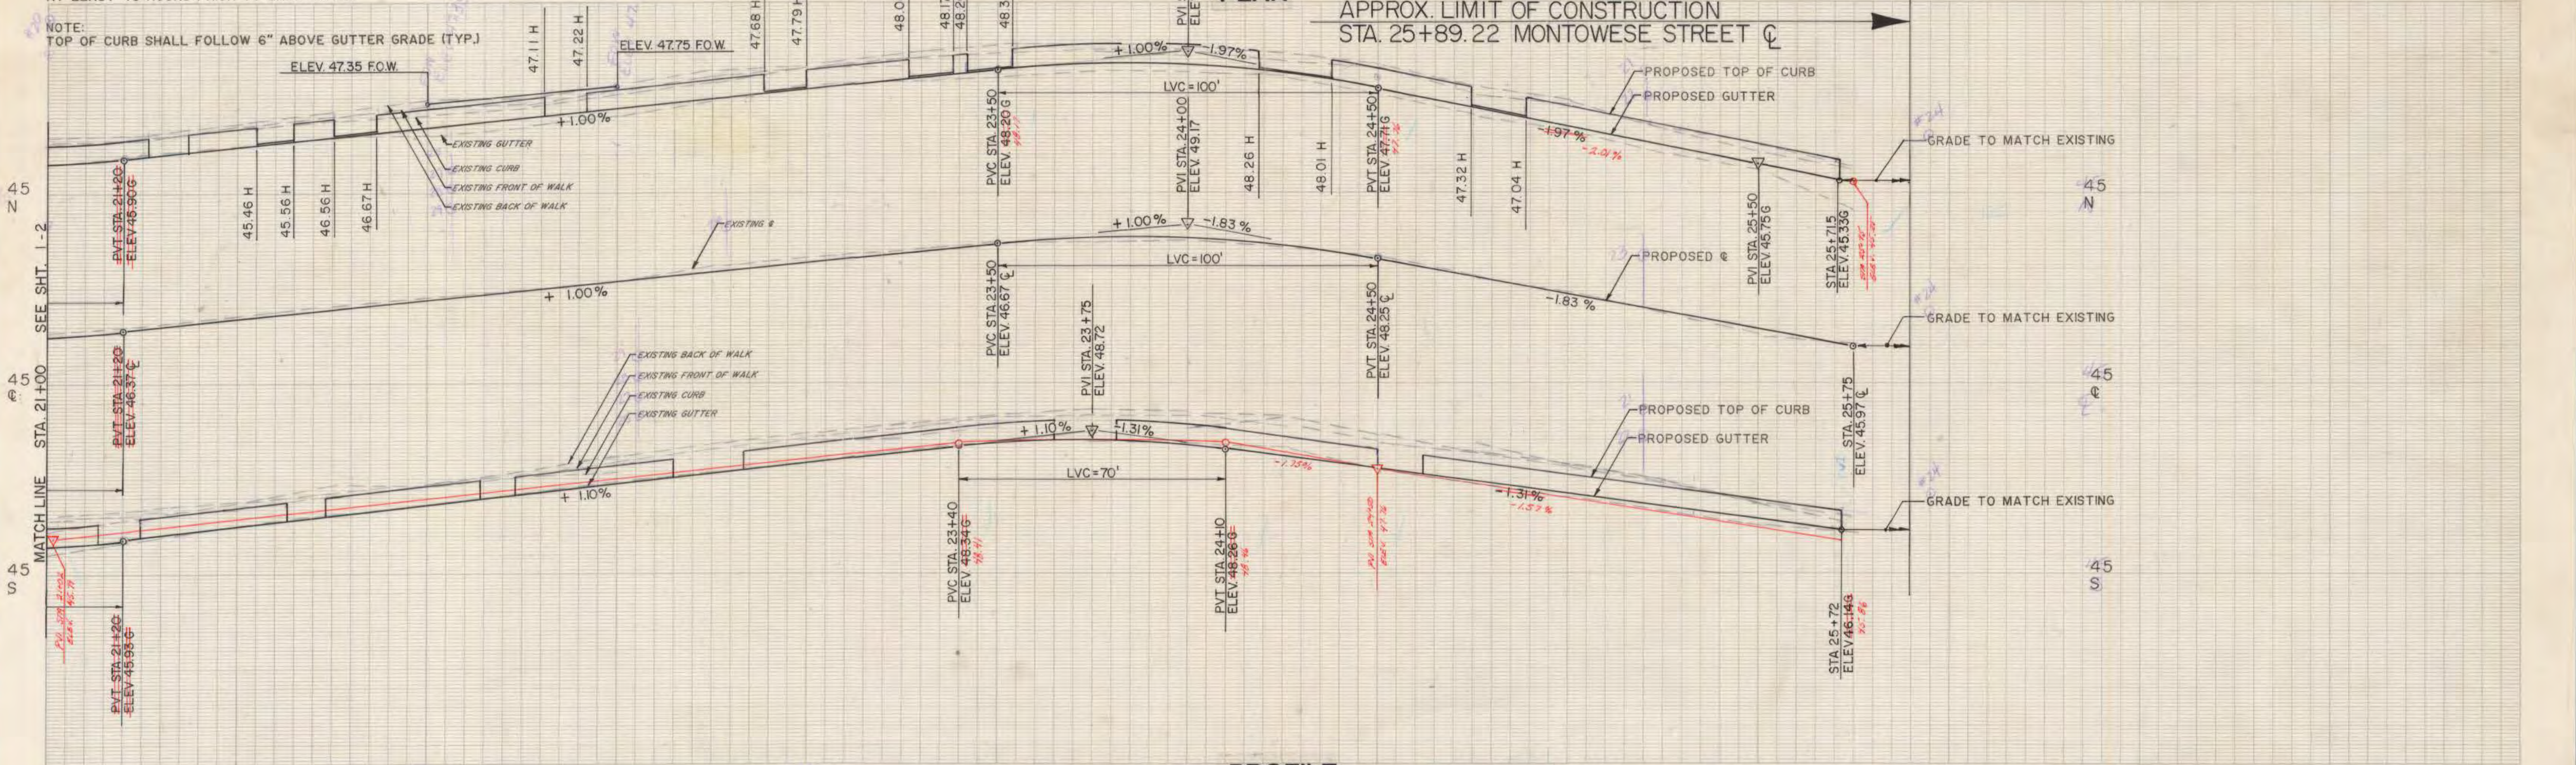


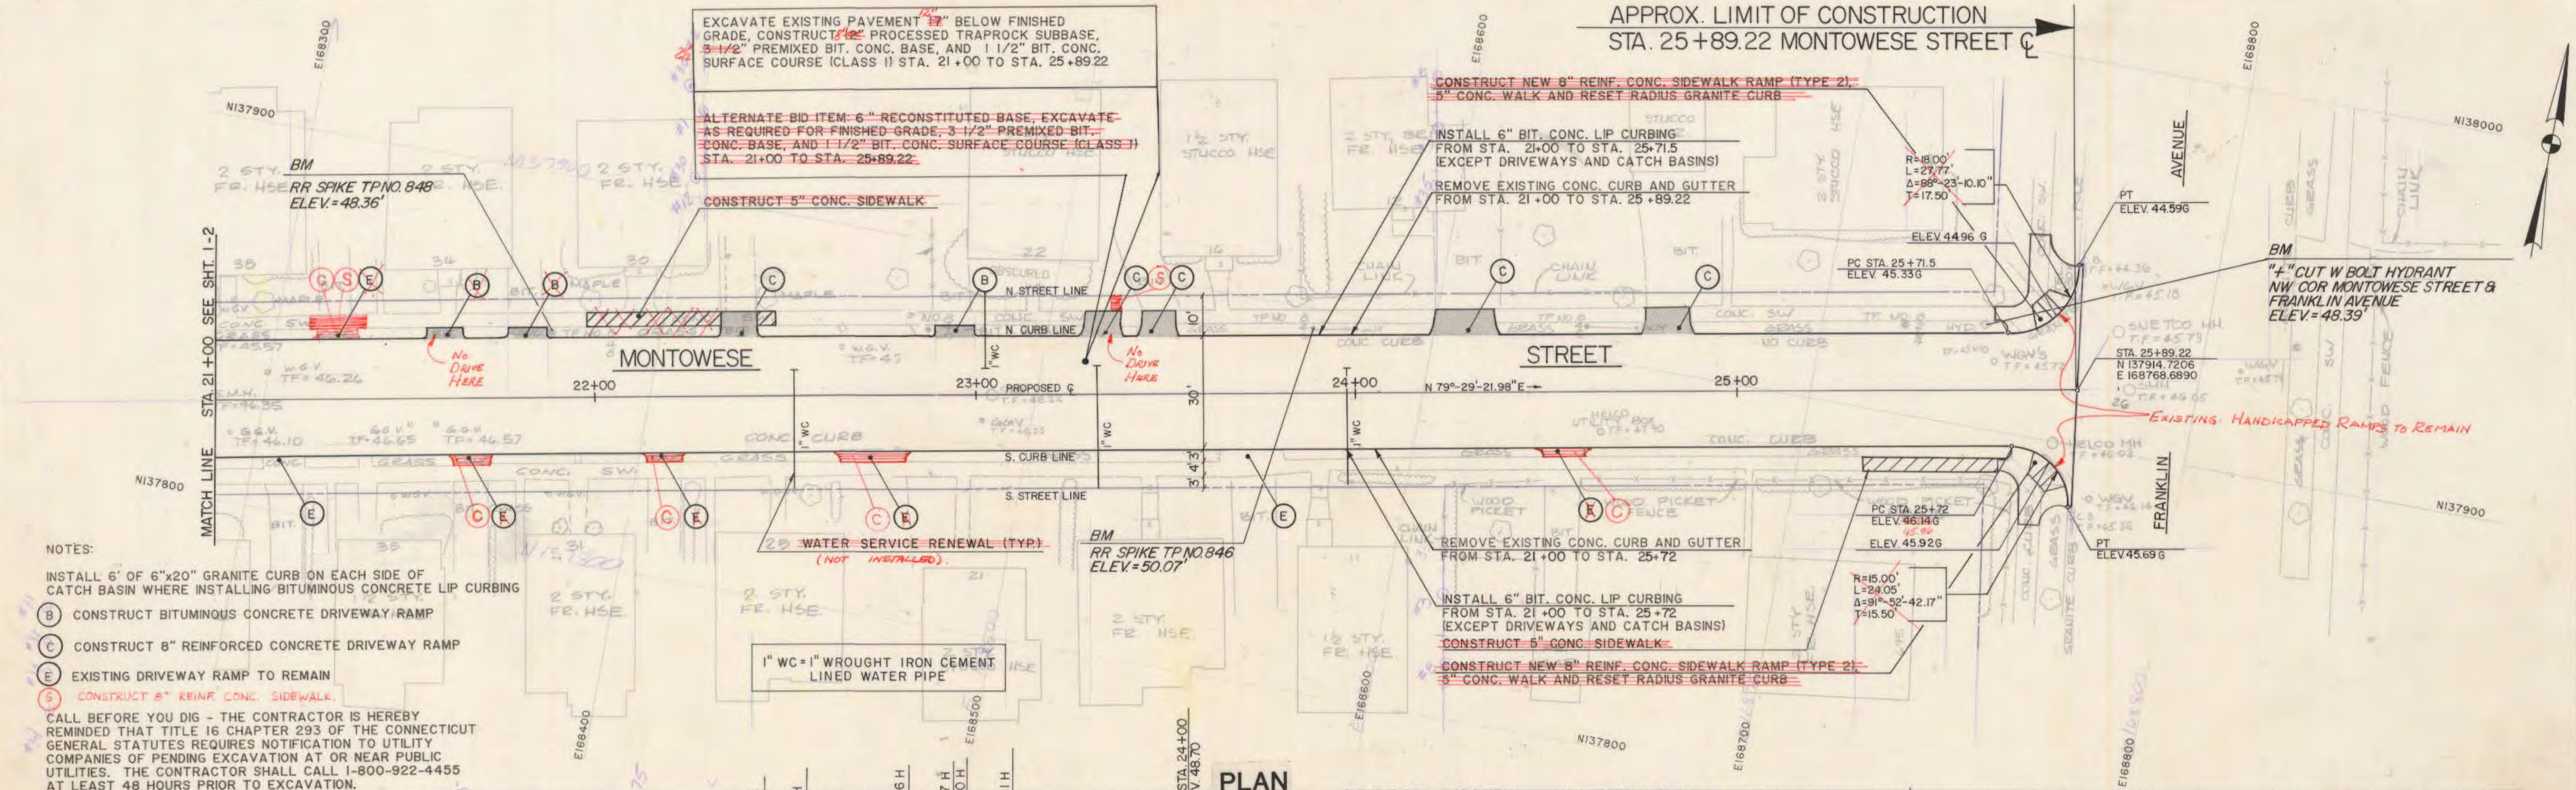

REVISIONS		GRAPHIC SCALES		ROADWAY RECONSTRUCTION		CITY OF HARTFORD, CONNECTICUT		MONTOWESE STREET	
SUPV. ARW		HORIZ. 1"=20'		HARTFORD, CONNECTICUT		DEPARTMENT OF PUBLIC WORKS		STA. 21+00 TO STA. 25+89.22	
DESIGN MDH/AEC		VERT. 1"=2'				BUREAU OF ENGINEERING SERVICES		PLAN AND PROFILE	
DRAWN KHT								SHEET 2-2	
CHECKED JAC									
DATE 6/3/05									

Hayden | Wegman
Consulting Engineers
WEST HARTFORD
NEW YORK • BOSTON • BUFFALO
ATLANTA • MEMPHIS

CITY OF HARTFORD, CONNECTICUT
DEPARTMENT OF PUBLIC WORKS
BUREAU OF ENGINEERING SERVICES

DRAWN _____ SCALE _____ DAYBOOK NO. 010947
CHECKED _____ DATE _____

Contract No. E85-28 Job No. 845304