
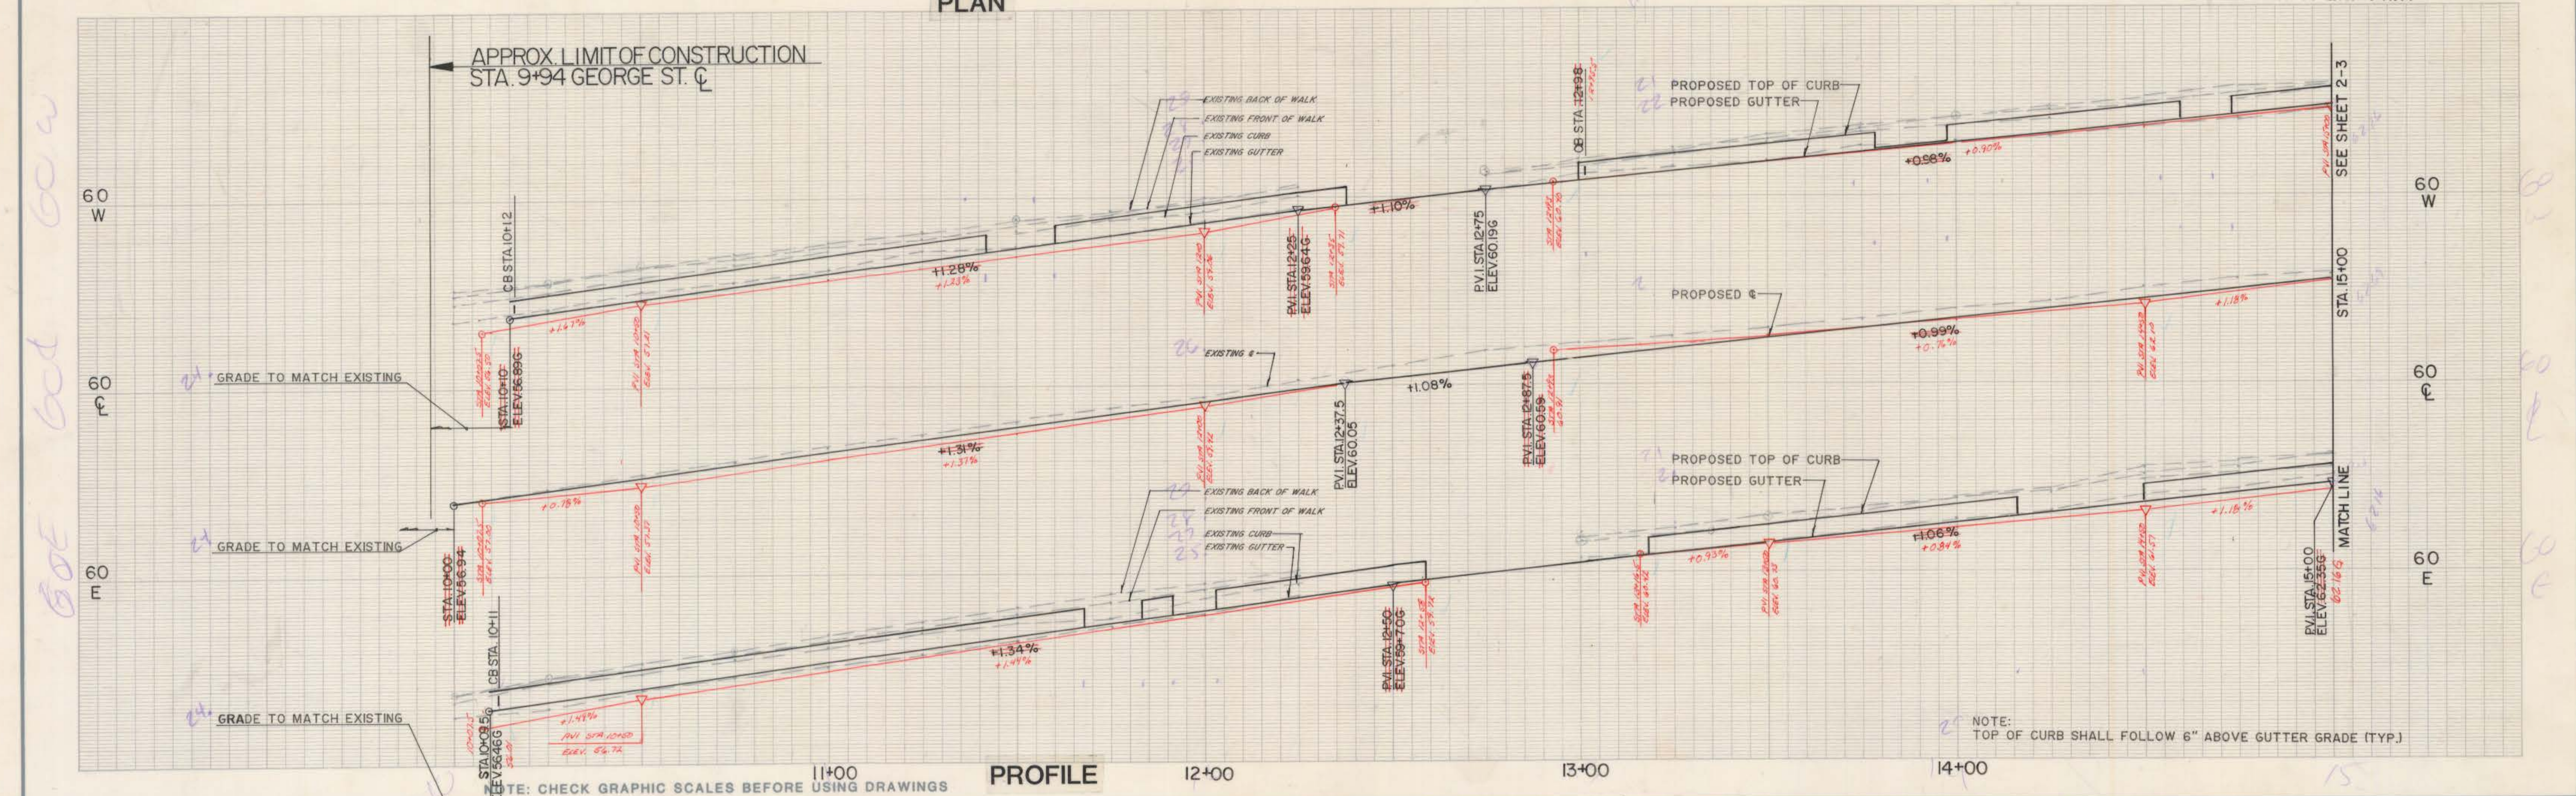


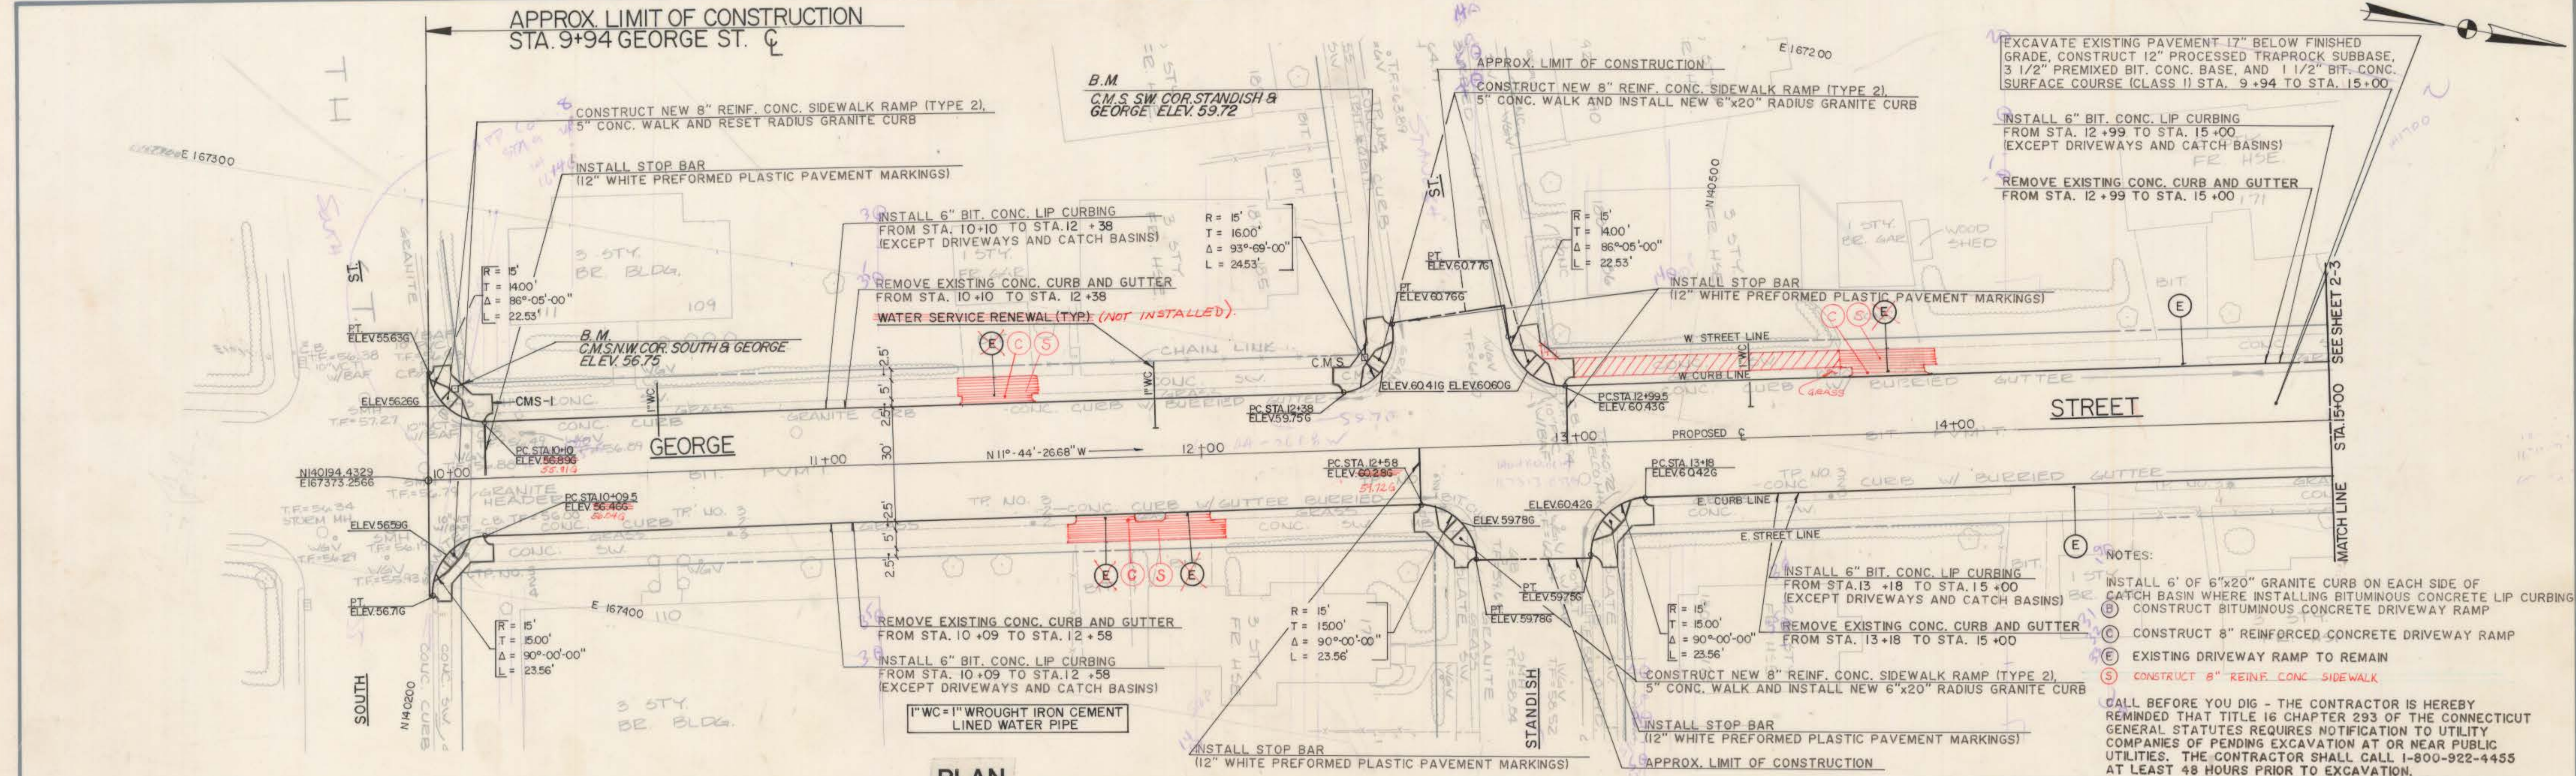

REVISIONS NO. DATE DESCRIPTION 1 6-3-85		SUPV. HRW DESIGN MDH/AEC DRAWN CS CHECKED AK DATE 6-3-85	GRAPHIC SCALES HORIZ. 1" = 20' VERT. 1" = 2'	ROADWAY RECONSTRUCTION HARTFORD, CONNECTICUT		Hayden Wegman Consulting Engineers WEST HARTFORD NEW YORK • BOSTON • BUFFALO ATLANTA • MEMPHIS	CITY OF HARTFORD, CONNECTICUT DEPARTMENT OF PUBLIC WORKS BUREAU OF ENGINEERING SERVICES	GEORGE STREET STA. 9+94 TO STA. 15+00 PLAN AND PROFILE	SHEET 1-3
--	--	---	--	---	--	---	--	--	---------------------