



APPROX. BEGIN OF CONST.
STA. 10+03 GILMAN STREET C

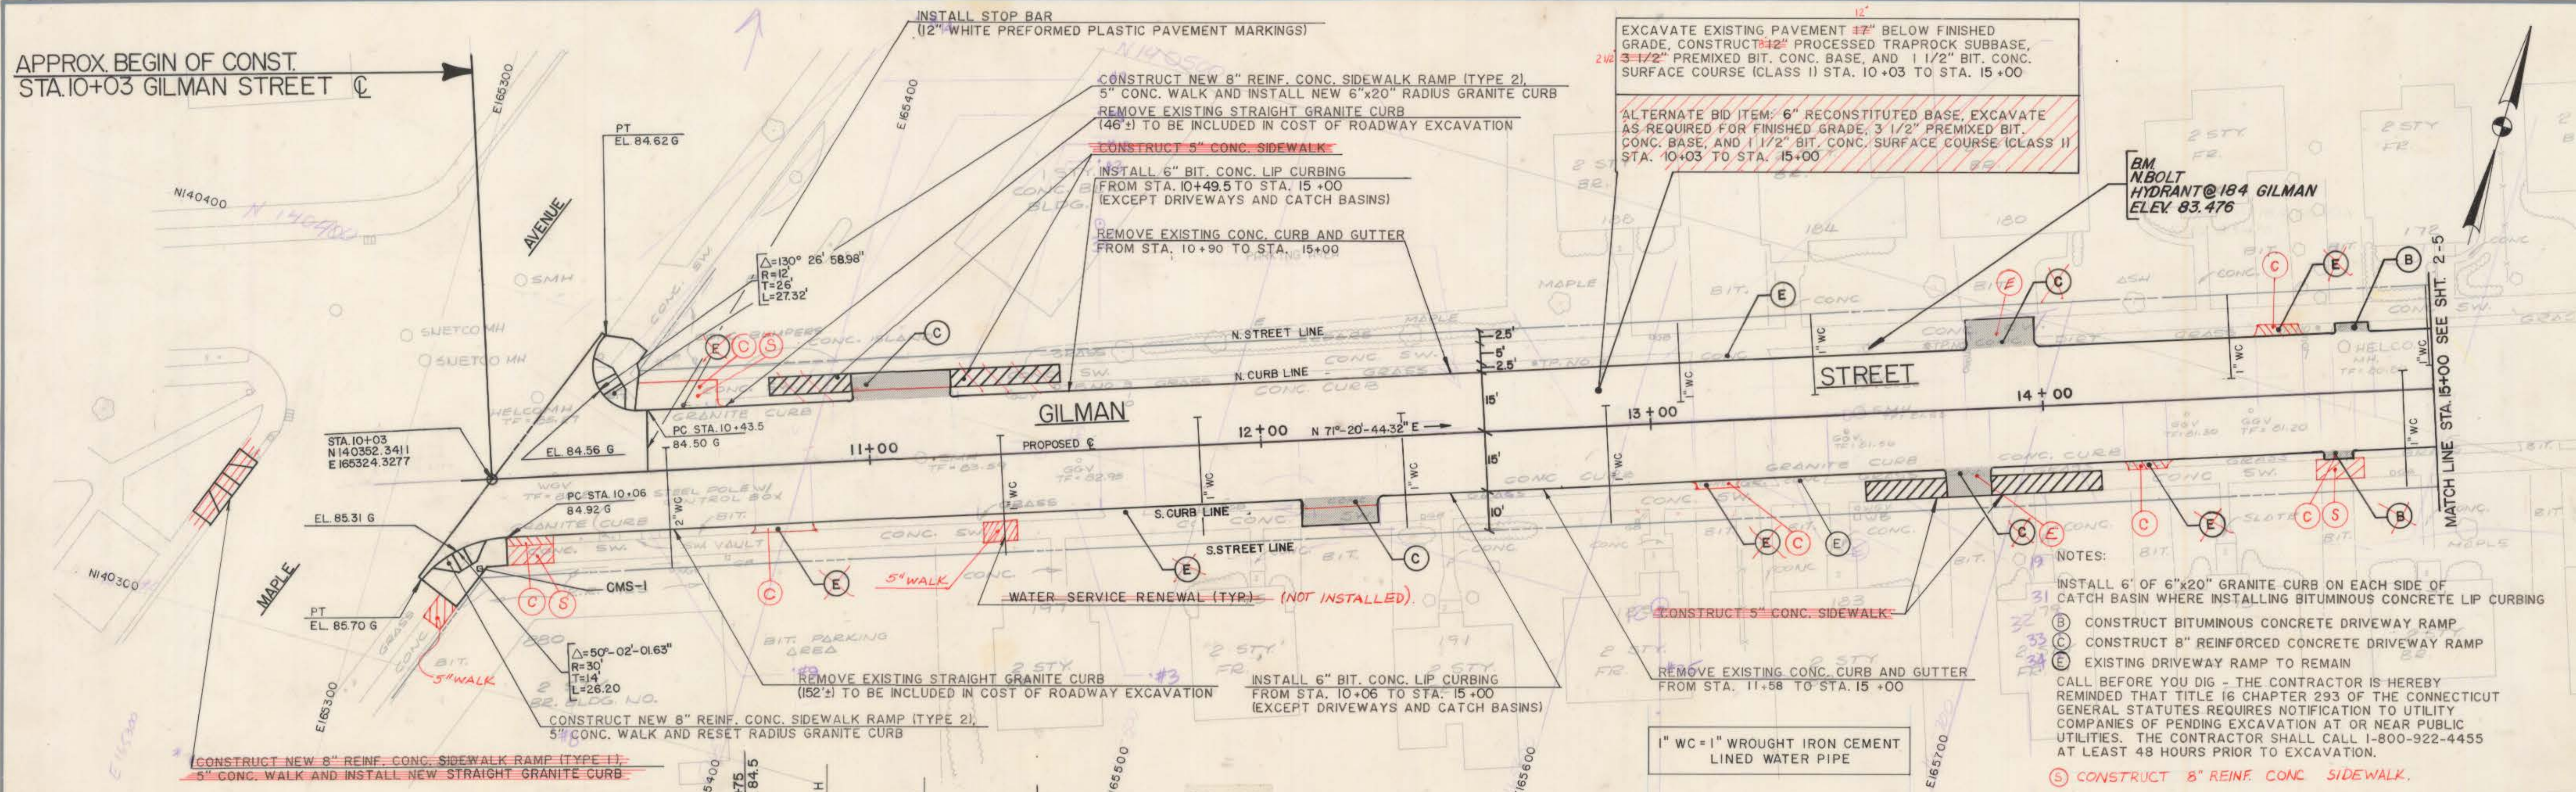

APPROX. BEGIN OF CONST.
STA. 10+03 GILMAN STREET C

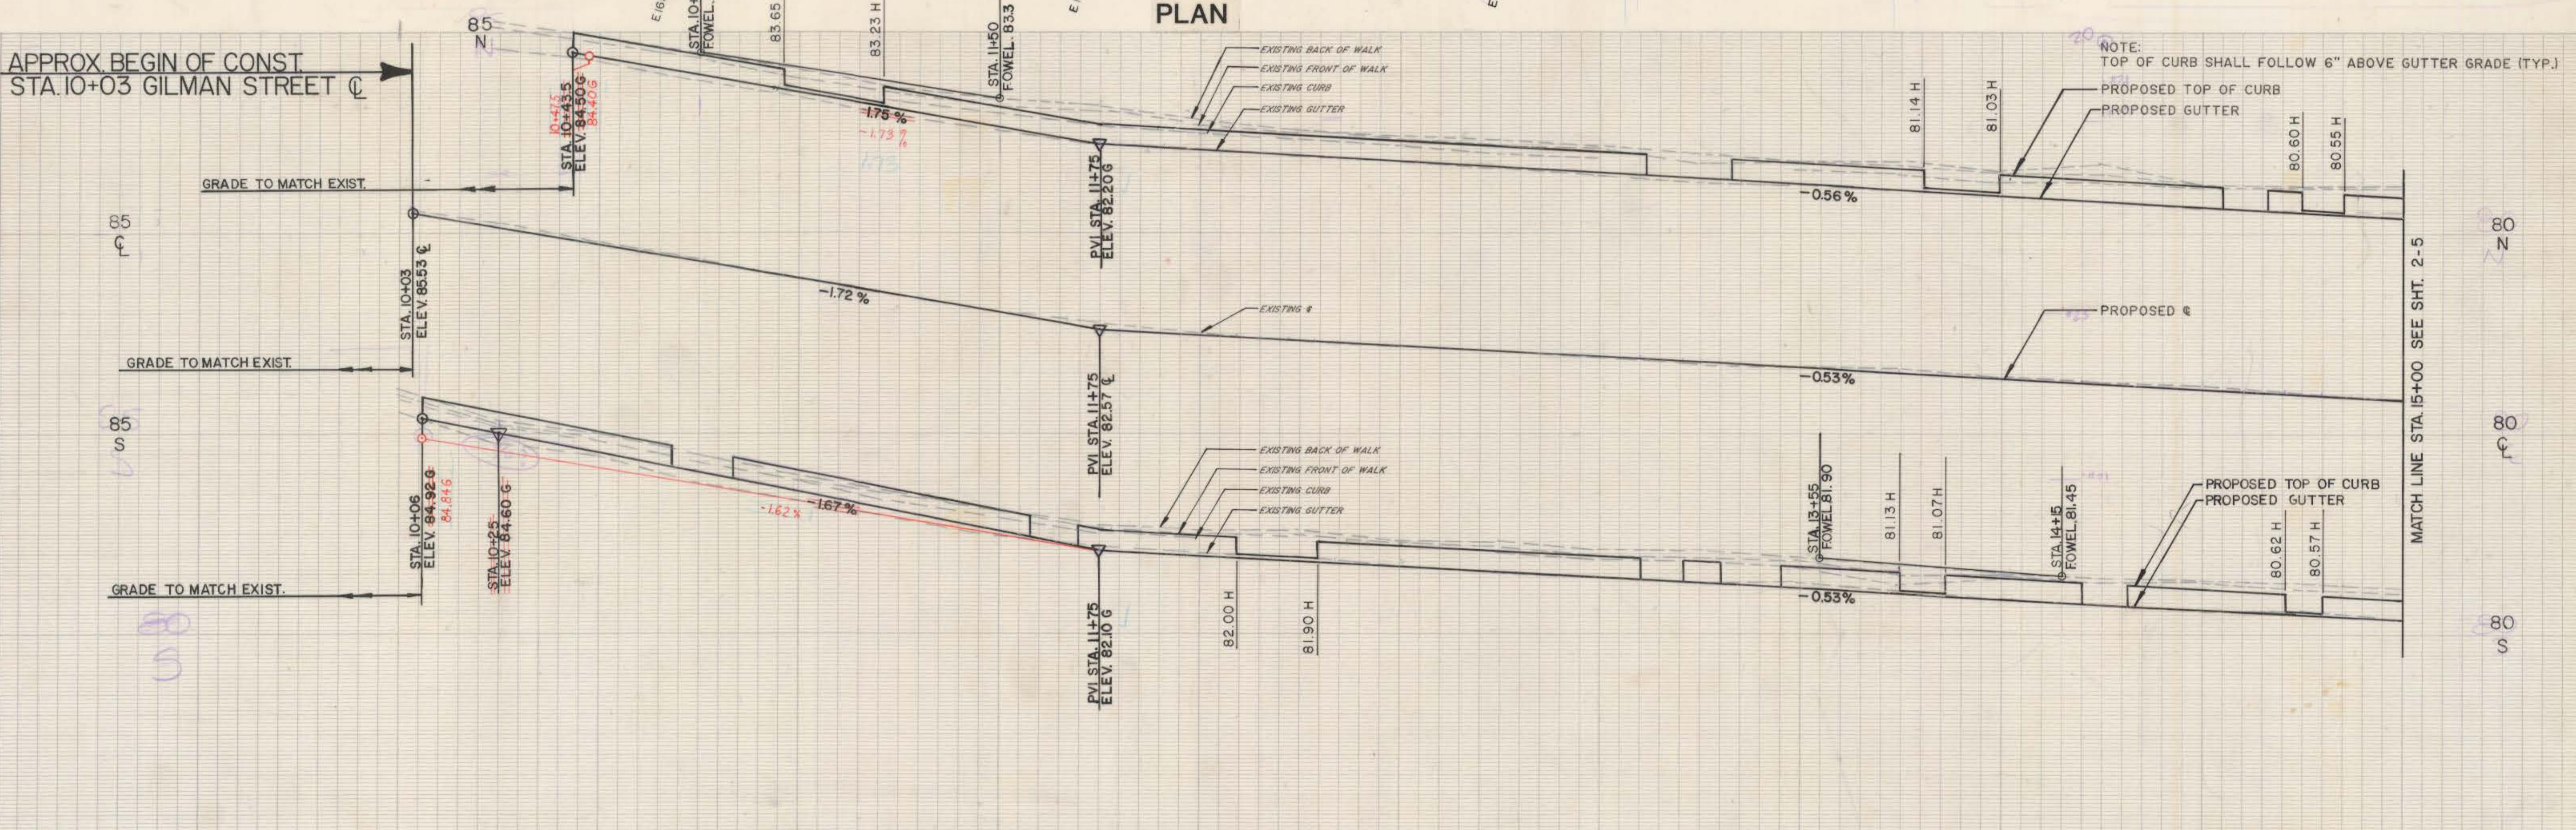

NOTE: CHECK GRAPHIC SCALES BEFORE USING DRAWINGS

PROFILE

NO.	DATE	REVISIONS
1	6-3-85	DESIGN BY MDH/AEC DRAWN N.L. CHECKED JAC DATE 6-3-85

SUPV. ARW	GRAPHIC SCALES
DESIGN MDH/AEC	HORIZ. 1"=20'
DRAWN N.L.	VERT. 1"=2'

ROADWAY RECONSTRUCTION
HARTFORD, CONNECTICUT



Hayden | Wegman
Consulting Engineers
WEST HARTFORD
NEW YORK • BOSTON • BUFFALO
ATLANTA • MEMPHIS

CITY OF HARTFORD, CONNECTICUT
DEPARTMENT OF PUBLIC WORKS
BUREAU OF ENGINEERING SERVICES

GILMAN STREET
STA. 10+03 TO STA. 15+00
PLAN AND PROFILE
SHEET 1-5
Contract No. E85-28 Job No. 845304