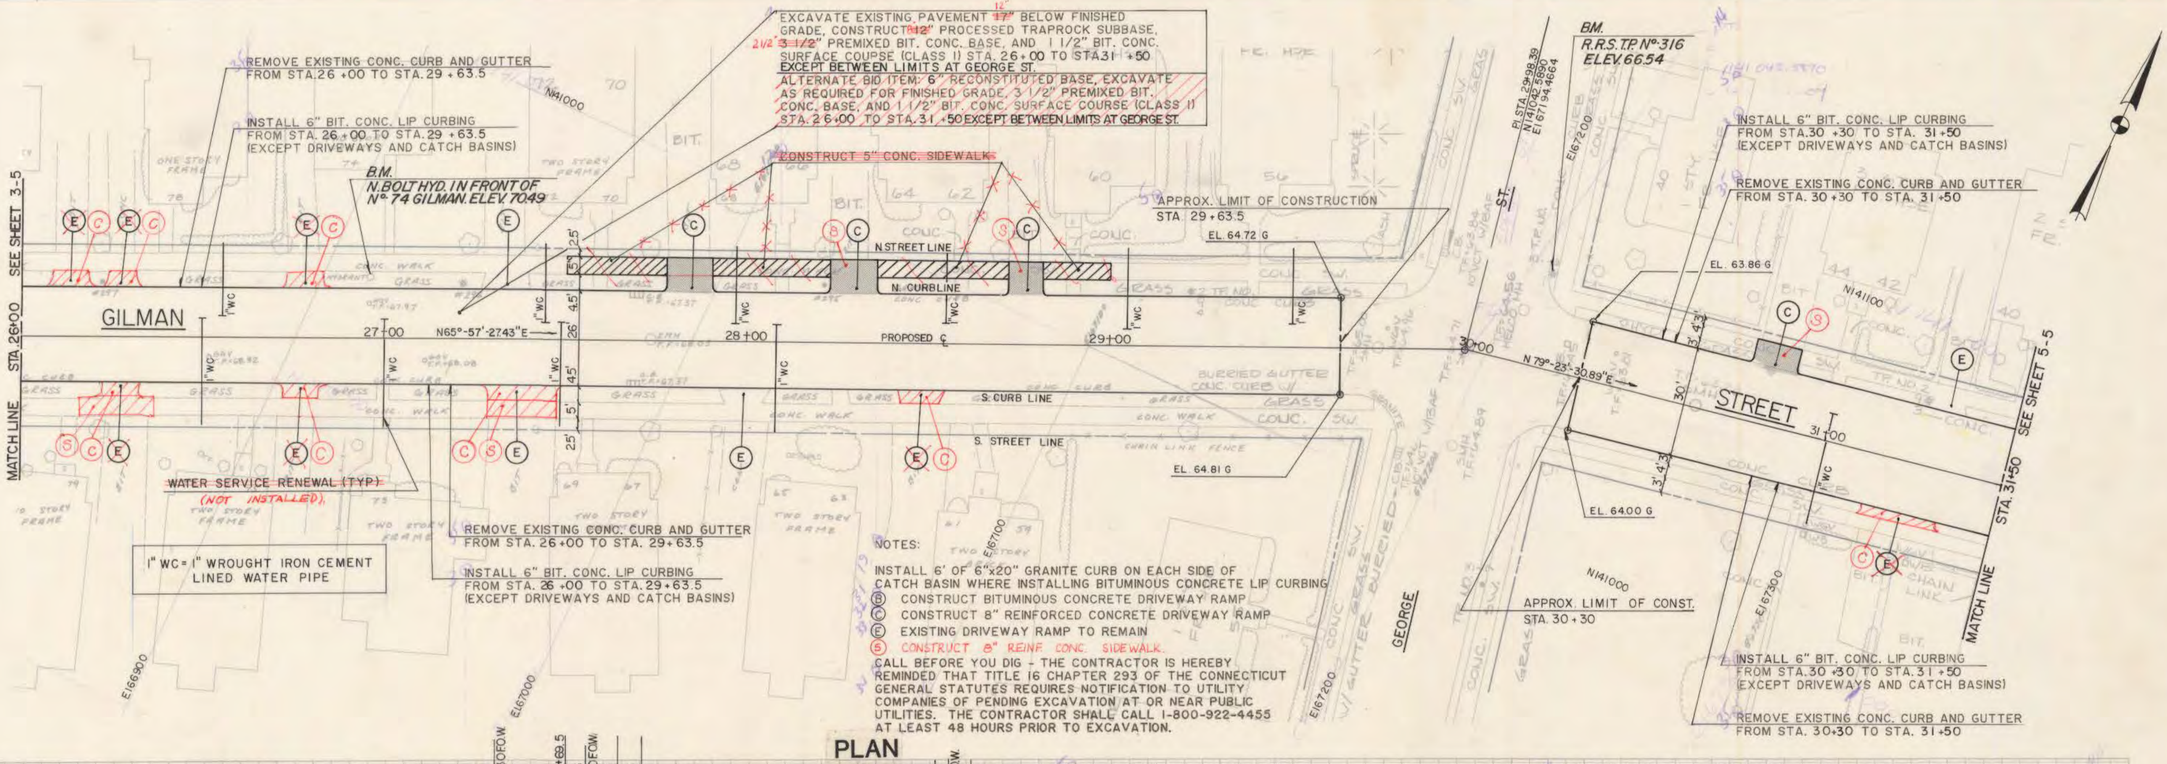

NO.	DATE	DESCRIPTION
1	DEC '84	CHECKED BY MDH HOT TO AC: BUILD CURB AT RIP

REVISIONS

SUPV. ARW
DESIGN MDH / AEC
DRAWN CGJ
CHECKED JAC
DATE 6/3/85

GRAPHIC SCALES
HORIZ. 1" = 20'
VERT. 1" = 2'

ROADWAY RECONSTRUCTION
HARTFORD, CONNECTICUT

STATE OF CONNECTICUT — ALAN W. WEGMAN — NO. 10606 — REGISTERED PROFESSIONAL ENGINEER

Hayden | Wegman
Consulting Engineers
WEST HARTFORD
NEW YORK • BOSTON • BUFFALO
ATLANTA • MEMPHIS

CITY OF HARTFORD, CONNECTICUT
DEPARTMENT OF PUBLIC WORKS
BUREAU OF ENGINEERING SERVICES

DRAWN ____ CHECKED ____ SCALE ____ DAYBOOK NO. 010947 DATE ____

GILMAN STREET

STA. 26+00 TO STA. 31+50

PLAN AND PROFILE

Contract No. E85-28 Job No.- 845304

SHEET 4-5 OF