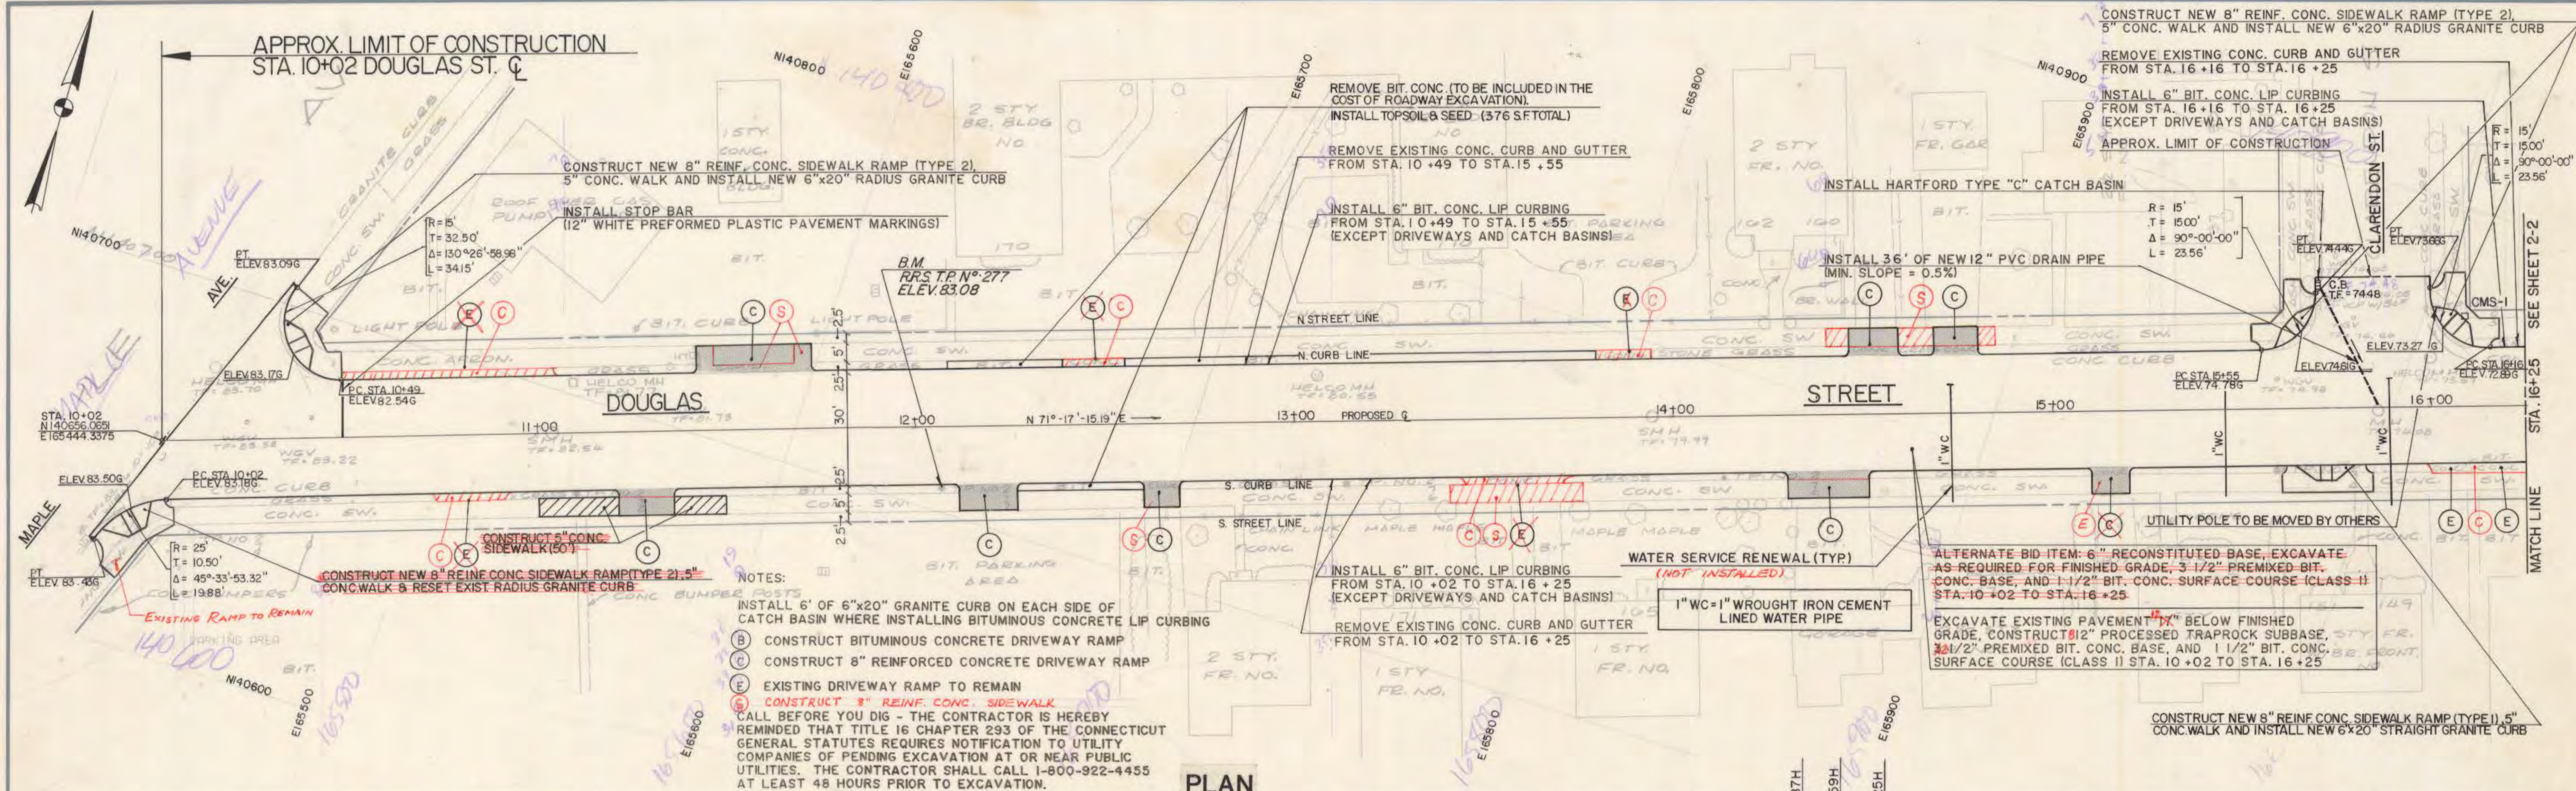


[illegible]

SUPV.	ACW
DESIGN	MDH / AEC
DRAWN	CB
CHECKED.	VAC
DATE	6.3.85

GRAPHIC SCALES

HORIZ. $1'' = 20'$

VERT. $1'' = 2'$

ROADWAY RECONSTRUCTION HARTFORD, CONNECTICUT



Hayden | Wegman
Consulting Engineers

WEST HARTFORD
NEW YORK • BOSTON • BUFFALO
ATLANTA • MEMPHIS

CITY OF HARTFORD, CONNECTICUT
DEPARTMENT OF PUBLIC WORKS
BUREAU OF ENGINEERING SERVICES

DRAWN _____	SCALE	DAYBOOK NO. 010947
CHECKED _____		DATE

DOUGLAS STREET

STA. 10+02 TO STA. 16+25

PLAN AND PROFILE

Contract No. E85-28

Job No.- 845304

1-2